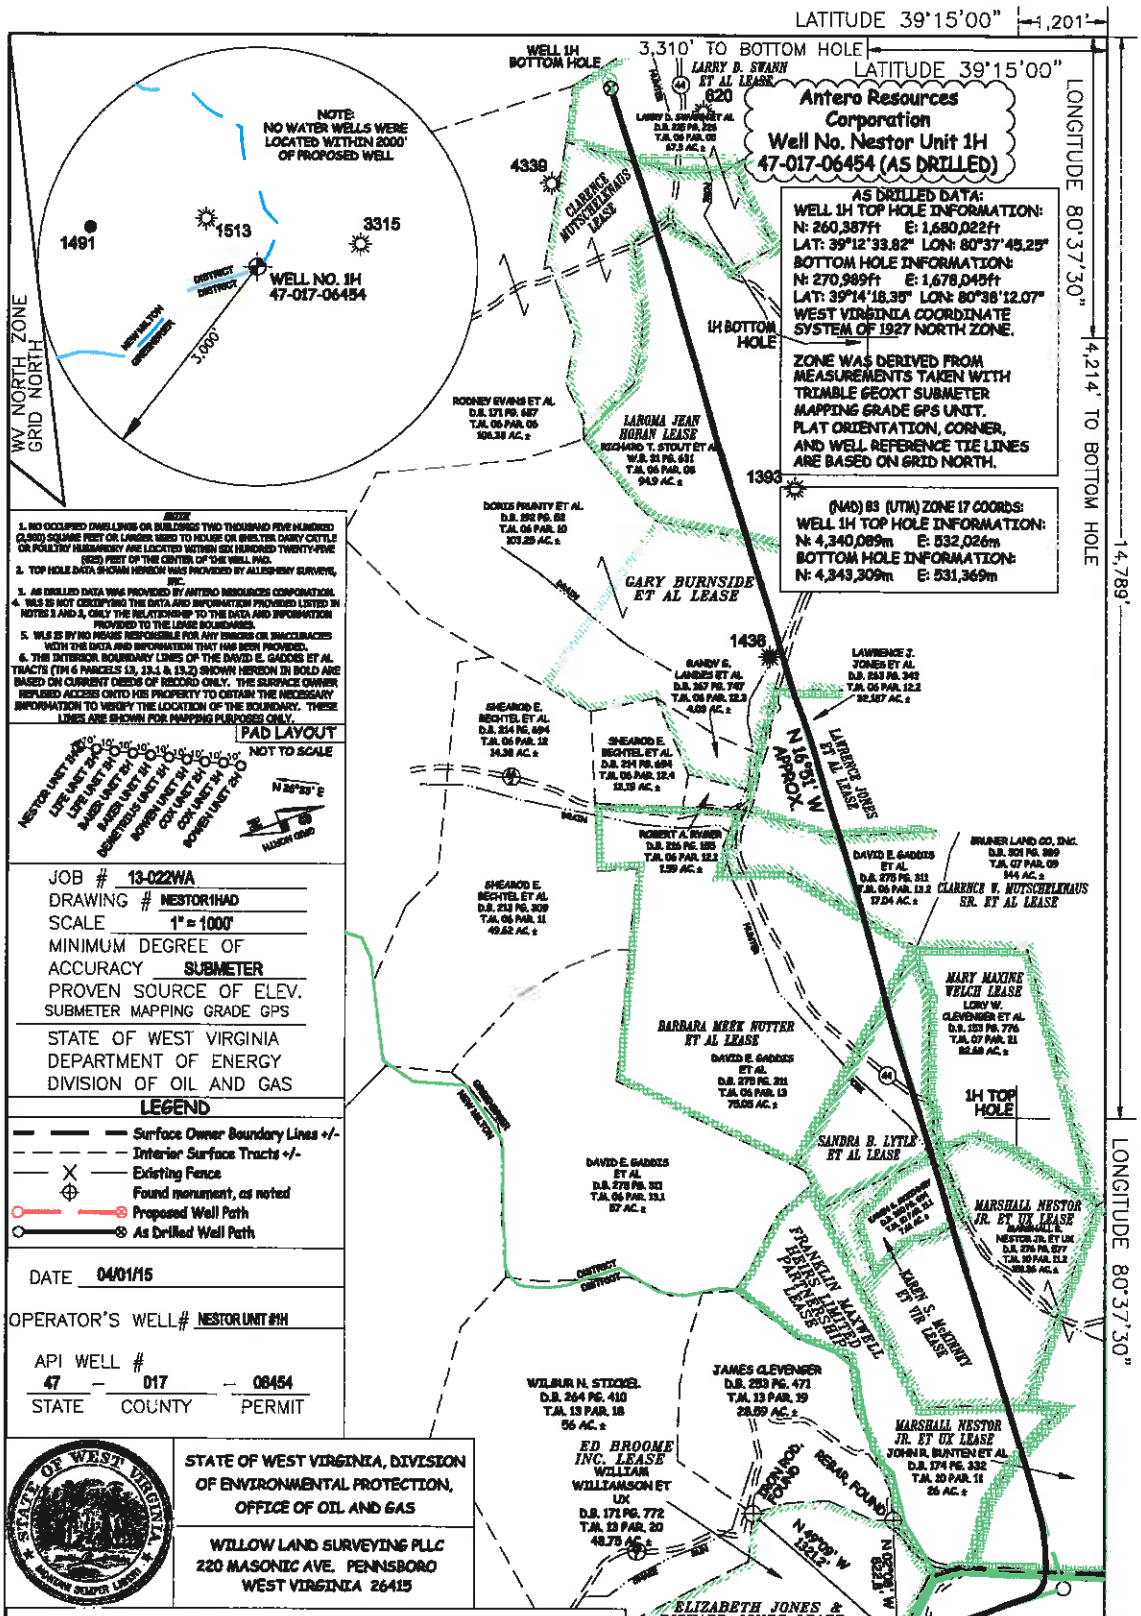

WELL TYPE: OIL ___ GAS X LIQUID INJECTION ___ WASTE DISPOSAL ___
(IF "GAS") PRODUCTION X STORAGE ___ DEEP ___ SHALLOW X
LOCATION: ELEVATION 1,420' ORIGINAL - 1,409' AS DRILLED WATERSHED HEADWATERS MIDDLE ISLAND CREEK
QUADRANGLE NEW MILTON 7.5' DISTRICT GREENBRIER COUNTY DODDRIDGE
SURFACE OWNER CLARENCE TRENT, JR. ET AL ACREAGE 155 ACRES +/-
OIL & GAS ROYALTY OWNER ELIZABETH JONES & RICHARD JONES; MARSHALL NESTOR JR. ET UX; ROBERT A. MCCONNELL ET VIR; SANDRA BARLEY LYTLE ET AL; BARBARA M. NUTTER ET AL; CLARENCE W. MUTSCHELLENAUS SR. ET AL; LAWRENCE J. JONES ET AL; GARY BURNSIDE ET AL; LAROMA JEAN HORAN; CLARENCE MUTSCHELLENAUS; LARRY D. SWANN ET AL LEASE ACREAGE 155 ACs; 90 ACs; 44.8 ACs; 42.88 ACs; 7.81 ACs; 19.75 ACs; 75.05 ACs; 100 ACs; 32.18 ACs; 84 ACs; 94.5 ACs; 31 ACs; 35.75 ACs
PROPOSED WORK: DRILL ___ CONVERT ___ DRILL DEEPER ___ REDRILL ___ FRACTURE OR STIMULATE
PLUG OFF OLD FORMATION ___ PERFORATE NEW FORMATION ___ OTHER PHYSICAL CHANGE IN WELL (SPECIFY) (X) AS DRILLED PLUG & ABANDON CLEAN OUT & REPLUG
TARGET FORMATION MARCELLUS ESTIMATED DEPTH 7,475' TVD 18,140' MD

WELL OPERATOR ANTERO RESOURCES CORPORATION DESIGNATED AGENT DIANNA STAMPER
ADDRESS 1615 WYNKOOP STREET ADDRESS 5400 D BIG TYLER ROAD
DENVER, CO 80202 CHARLESTON, WV 25313

FORM WW-6

RECEIVED
Office of Oil and Gas
NOV 21 2016
WV Department of Environmental Protection