

Latitude

39°22'30"

75'
+

88°35'00"

Longitude

Topo Location

7.5' Loc. 0.335 15' Loc. 3.215
2.07W (calc.) 2.07W

Company MERS 11058

Farm W.A. Davis

15' Quad Centropnt C
(sec.)

7.5' Quad Salem

District McClellan

WELL LOCATION PLAT

County 017 Permit 30084

Dodd 84A


McClellan District, Doddridge County, W. Va.
 By The Manufacturers Light & Heat Co., 800 Union Trust Bldg.,
 Pittsburgh, Pa.
 On 27 acres, surface owned by W. A. Davis, R. D. 1, Wallace, W. Va.,
 and mineral rights by ML&H Co., Pgh., Pa.
 Drilled prior to June 1, 1929.
 Elevation, 820' L.
 10" casing, 280'; 8 1/4", 849'; 6-5/8", 1720'; 2" tubing, 2625'.
 Coal was encountered at 420-427'.
 Abandonment reported to Dept. of Mines June 7, 1934.
 Gas well.

	Top.	Bottom.	Thickness.
Pittsburgh Coal	420	- 427	7
Little Dunkard Sand	850	- 870	20
Big Dunkard Sand	940	- 970	30
Gas Sand	1085	- 1150	65
1st Salt Sand	1158	- 1215	57
2nd Salt Sand	1310	- 1360	50
3rd Salt Sand	1405	- 1435	30
4th Salt Sand	1450	- 1483	33
Maxton Sand	1505	- 1560	55
Little Lime	1675	- 1685	10
Pencil Cave	1685	- 1705	20
Big Lime	1705	- 1770	65
Big Injun Sand (show of gas, 1775')	1770	- 1930	160
Gantz Sand	2080	- 2135	75
50-Ft. Sand	2285	- 2300	15
Gordon Stray Sand	2480	- 2505	25
Gordon Sand (gas at 2555')	2550	- 2568	18
Fourth Sand	2587	- 2590	3
Total depth			2598

THE MANUFACTURERS LIGHT & HEAT CO., OF PITTSBURGH, PA
 ON THE W.A. DAVIS FARM CONSISTING OF 27 ACRES
 LOCATED IN WETZEL DISTRICT, DOODRIDGE COUNTY, W. VA
 LEASE 4805

888-847A

G. A. DAVIS

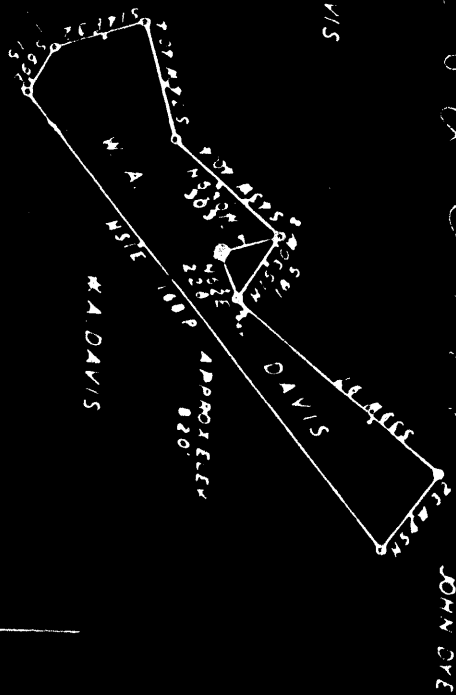

ENGINEERS CERTIFICATE

I HEREBY CERTIFY THAT THIS MAP IS CORRECT AND TRUE
 TO THE BEST OF MY KNOWLEDGE AND BELIEF REQUIRED
 BY THE LAWS AND AS SECTION OF THE MINING LAWS OF WEST VIRGINIA

[Handwritten signature]
 ENGINEER

ACKNOWLEDGED BEFORE ME A NOTARY PUBLIC OF AND FOR

APPROVANT IN TRIPLU-VATE TO TIME AND MANNER OF
 PLUMBING AND FILLING WELL
 WEST VIRGINIA DEPARTMENT OF MINES






































