

BAKER, H. O., NO. 1277.

Dod-131-A.



By W. J. Droppleman, et al.

McClellan Dist.

CAN NOT

LOCATE

Part of ...
by ...
of Coon Run, in McClellan District, Edridge County, West Virginia
well to be pulled and abandoned.

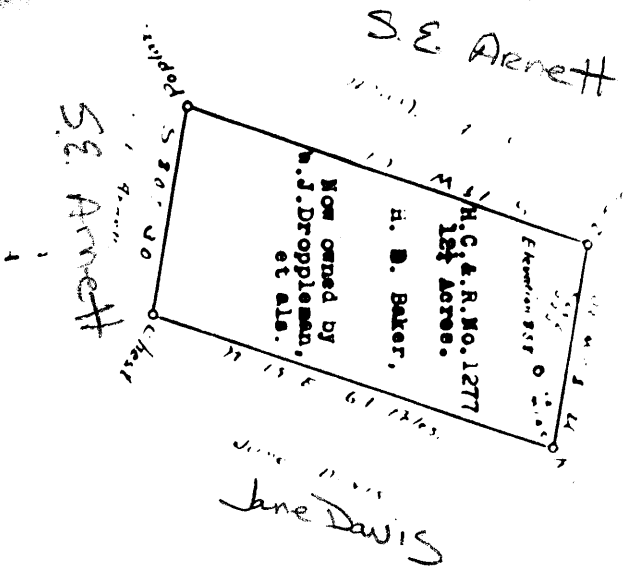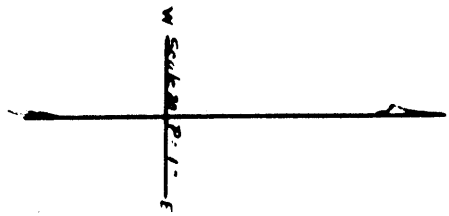

Engineers Certificate,

I, the undersigned, hereby certify that this map is correct and shows all the information to the best of my knowledge and belief required by the oil and gas section of the mining laws of West Virginia.

J. M. ..., Engineer.

Acknowledged before me a Notary Public of Doddridge County, West Virginia, this the 2nd day of September, 1935.

V. J. ..., Notary Public.
My commission expires on the 11th day of September, 1932.

