M

LATITUDE 39° 25′ 35′

LONGITUDE 80°

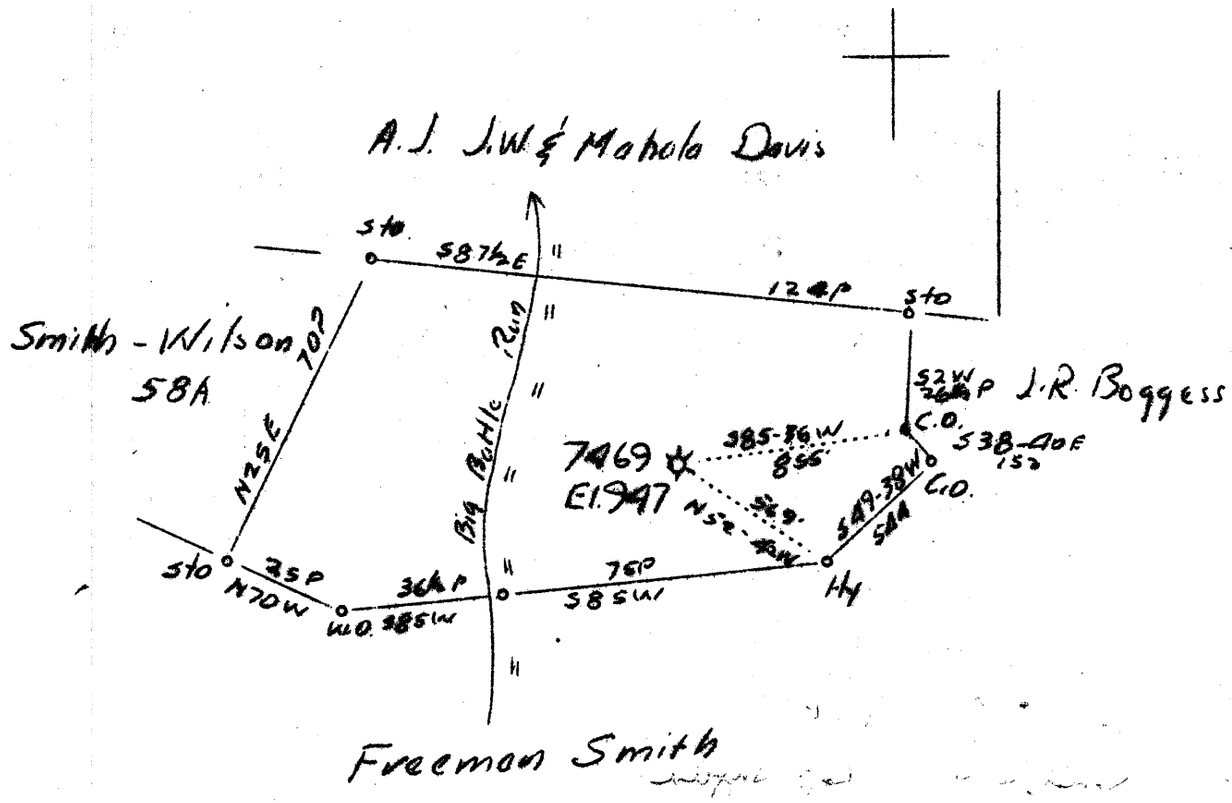

2.13 N
3.56 ✗

Abd.

F.B. 492 Pg 40

Company Hope Natural Gas Co.
Address Clarksburg, W.Va.
Farm Smith-Wilson
Tract Acres 54 Lease No. 45003
Well (Farm) No. 1 Serial No. 7469
Elevation (Spirit Level) 947
Quadrangle Centerpoint (C)
County Doddridge District McClellan
Engineer J.W.Clark
Engineer's Registration No. 744
File No. Drawing No.
Date Sept. 23,1937 Scale 1"=40 Poles

STATE OF WEST VIRGINIA
Department of Mines
OIL AND GAS DIVISION
CHARLESTON

WELL LOCATION MAP

File No. DOD-191A

+ Denotes location of well on United States Topographic Maps, scale 1 to 62,500, latitude and longitude lines being represented by border lines as shown.
72267 on CNG maps
—Denotes one inch spaces on border line of original tracing.