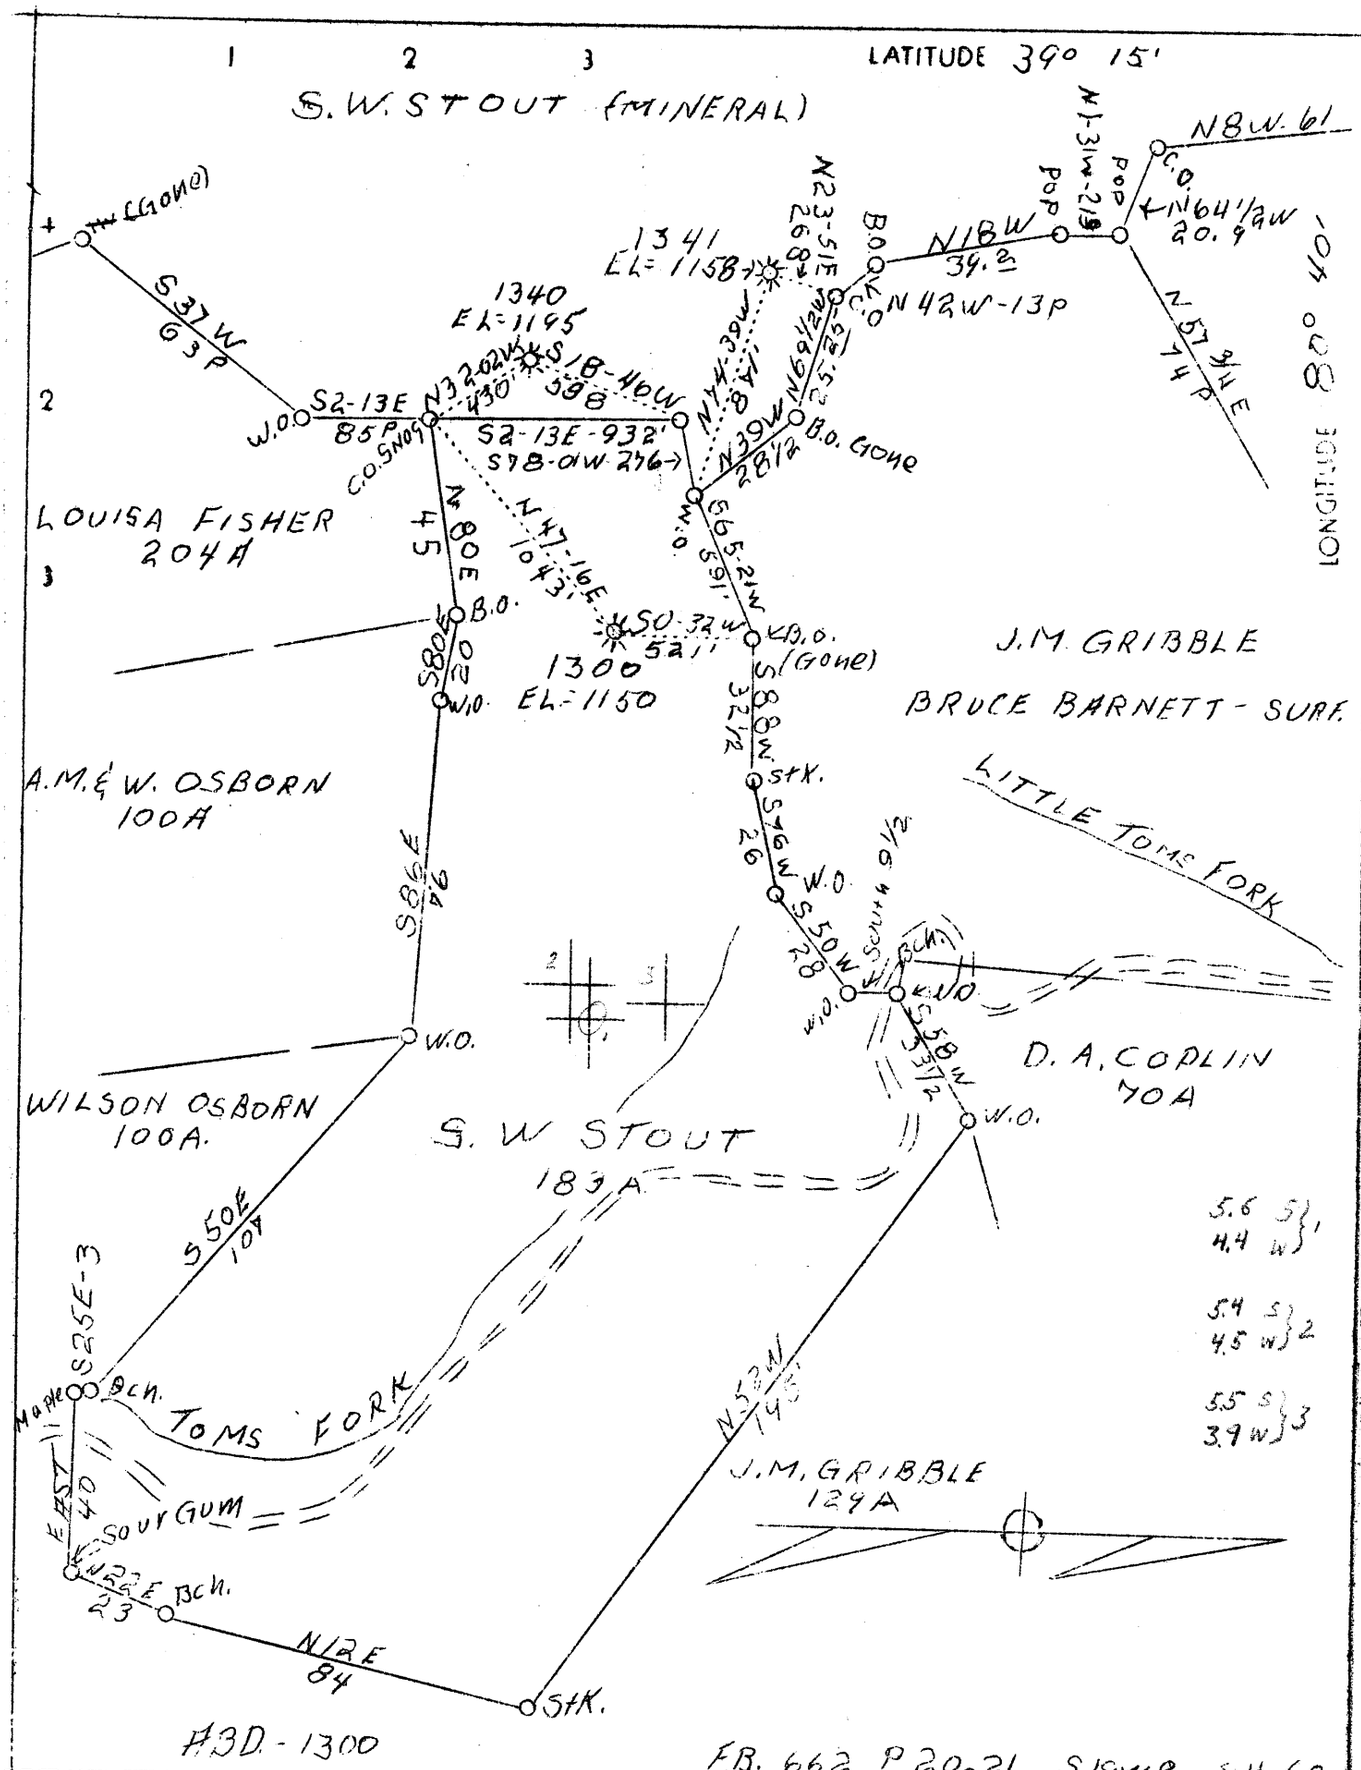

Company	Hope Constr. & Ref. Co.
Address	Clarksburg, W. Va.
Farm	S. W. Stout
Acres	1427
Lease No.	6197
Well (Farm) No.	-
Serial No.	1300 1340 1341
Elevation	Shown Above
Quadrangle	Vadis 11, W.
County	Doddridge
District	New Milton
Engineer	W. M. Bowers
Eng. Reg. No.	900
Date	June 20, 1938
Scale	1" = 40 poles

STATE OF WEST VIRGINIA
Department of Mines
OIL & GAS DIVISION
Charleston

WELL LOCATION MAP

File No. Dod-227 A

X Denotes location of well on U. S. Topographic Maps, scale 1 to 62,500, latitude and longitude lines being represented by border lines as shown.

- Denotes one inch spaces on border line of original tracing.