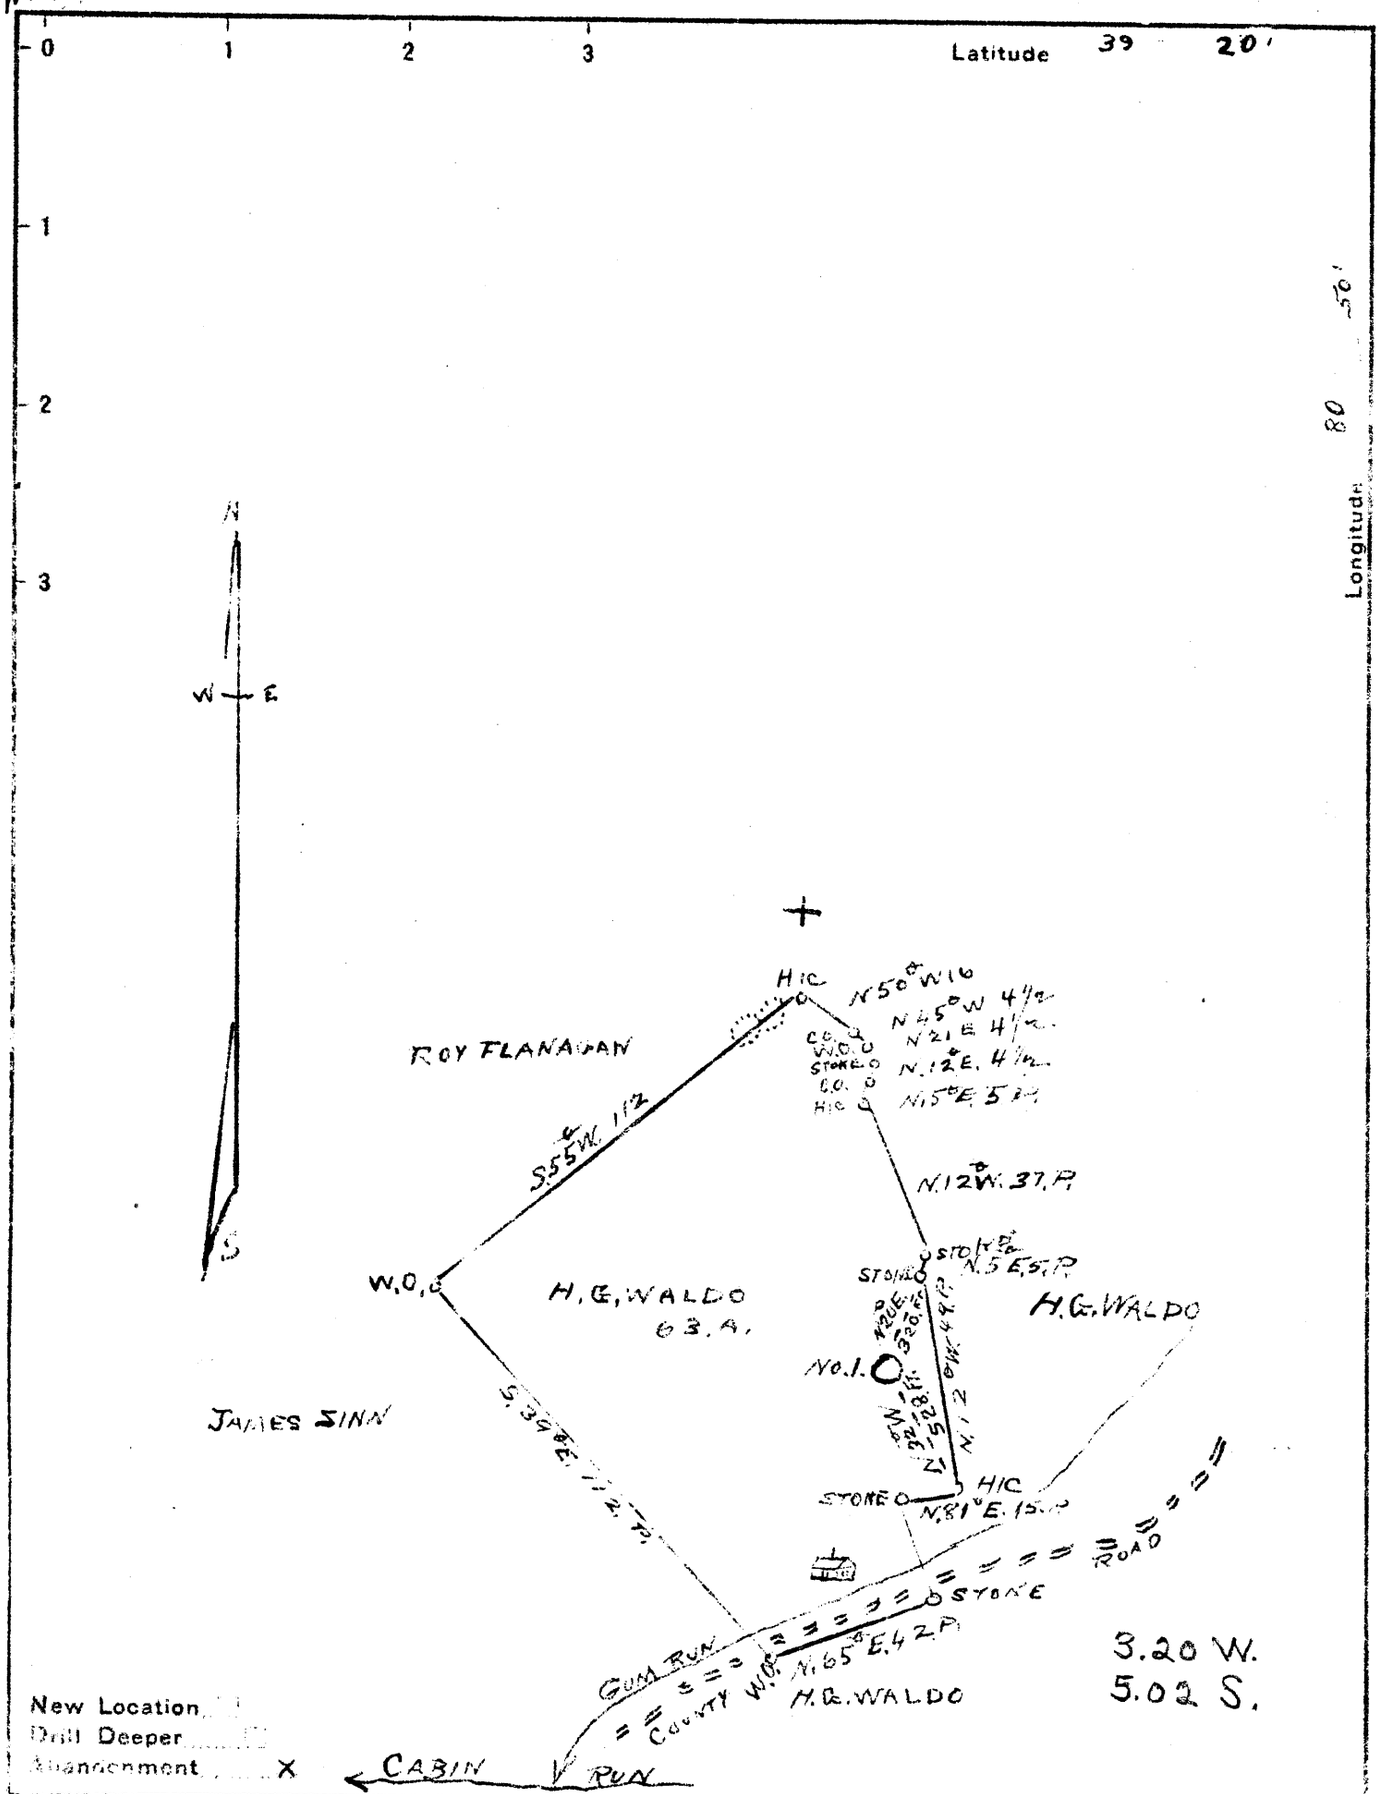


New Location
Drill Deeper
Abandonment X

Company E. S. WOODYARD
Address PENNSBORO W.VA
Farm H.G.WALDO
Tract Acres 63 Lease No.
Well (Farm) No. One Serial No.
Elevation (Spirit Level) 967
Quadrangle WEST UNION
County DODDRIDGE District CENTRAL
Engineer J. U. Dunbar
Engineer's Registration No. 65
File No. C-23-L Drawing No.
Date May 23 1940 Scale 1 INCH = 40 POLES

STATE OF WEST VIRGINIA
DEPARTMENT OF MINES
OIL AND GAS DIVISION
CHARLESTON

# WELL LOCATION MAP

FILE NO. DOD-319A

+ Denotes location of well on United States Topographic Maps, scale 1 to 62,500, latitude and longitude lines being represented by border lines as shown.

— Denotes one inch spaces on border line of original tracing.