


LATITUDE

LONGITUDE

8035

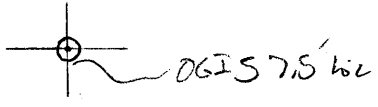

7'5 OGIS topo location

7.5' loc,	<u>2.15 S</u>	15' loc	_____
	<u>1.53 W</u>	(calc.)	_____

Company _____

Farm _____

Quad Big Isaac _____

County _____

District Greenbrier _____

WELL LOCATION MAP

File No. 017 - 328A

STATE OF WEST VIRGINIA
DEPARTMENT OF MINES
OIL AND GAS DIVISION

267

WELL RECORD

Permit No. 080 - 328 - A

Oil or Gas Well Oil
(Kind)

Company <u>William Moses</u>	Casing and Tubing	Used in Drilling	Left in Well	Packers
Address <u>189 W. Main St., Salem, W. Va.</u>	Size			
Farm <u>Stalnaker Heirs</u> Acres <u>290</u>	16			Kind of Packer
Location (waters)	13			Size of
Well No. <u>154</u> Elev. <u>1023'</u>	10		<u>1444'</u>	Depth set
District <u>Greenbriar</u> County <u>Doddridge</u>	8 1/4		<u>1995'</u>	Perf. top
The surface of tract is owned in fee by <u>Hope Construction & Refining Co.</u> Address <u>Clarksburg, W. Va.</u>	6%		<u>2082'</u>	Perf. bottom
Mineral rights are owned by <u>Wilbur Coal and Coke Co. South Bethlehem, Pennsylvania.</u>	5 3/16			Perf. top
Drilling commenced	3			Perf. bottom
Drilling completed	2			
Date shot	Liners Used			
Open Flow /10ths Water in				
/10ths Merc. in				
Volume	CASING CEMENTED	SIZE	No. Ft.	Date
Rock Pressure				
Oil	COAL WAS ENCOUNTERED AT	<u>590</u>	FEEET	INCHES
Fresh water			FEEET	INCHES
Salt water			FEEET	INCHES

Formation	Color	Hard or Soft	Top	Bottom	Oil, Gas or Water	Depth Found	Remarks
Pittsburgh Coal			590	595			
Dunkard			1040	1095			
Salt Sand			1300	1422			
Maxon			1910	1920			
Big Injun			2036	2067			
Total Depth			2072				

(Over)

1940

Greenbrier District, Doddridge County, W. Va.
 By William Moses, 189 W. Main St., Salem, W. Va.
 On 290 acres.

Elevation, 1023' L.

Surface owned by Hope Construction & Refining Co., Clarksburg, W. Va.,
 and minerals by Wilbur Coal & Coke Co., South Bethlehem, Pa.

8 $\frac{1}{4}$ " casing, 1444'; 6 $\frac{5}{8}$ ", 1995'; 2" tubing, 2082'.

Oil well. Abandonment reported to Dept. of Mines (not dated).

Record to RCT from Mrs. Griffith August 16, 1940.

Coal was encountered at 590-595'.

	Top.	Bottom.
Pittsburgh Coal	590	- 595
Dunkard Sand	1040	- 1095
Salt Sand	1300	- 1422
Maxton Sand	1910	- 1920
Big Injun Sand	2036	- 2067
Total depth		2072