


LATITUDE

80 35

LONGITUDE

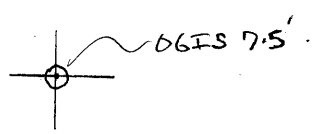

7.5 OGIS topo location

7.5' loc,	<u>2.245</u>	15' loc	_____
	<u>1.47 W</u>	(calc.)	_____

Company _____

Farm _____

Quad BIG ISAAC 7.5'

County _____

District GREENBRIER

WELL LOCATION MAP

File No. 017-331A

STATE OF WEST VIRGINIA
DEPARTMENT OF MINES
OIL AND GAS DIVISION

270

000 - 331 - A

WELL RECORD

Permit No.

Oil or Gas Well. **Oil**
(Kind)

Company William Moses	Casing and Tubing	Used in Drilling	Left in Well	Packers
Address 189 W. Main St., Salem, W. Va.	Size			
Farm Stalnaker Heirs Acres 290	16			Kind of Packer
Location (waters)	13			Size of
Well No. 162 Elev. 1243	10			Depth set
District Greenbriar County Doddridge	8 1/4			Perf. top
The surface of tract is owned in fee by Hope Construction & Logging Co. Address Clarksburg, W. Va.	6 5/8		1670'	Perf. bottom
Mineral rights are owned by Wilbur Coal and Coke Co. South Bethlehem, Pennsylvania.	5 3/16		2212'	Perf. top
Drilling commenced	3		2300'	Perf. bottom
Drilling completed	2			Perf. top
Date shot	Liners Used			Perf. bottom
Open Flow /10ths Water in				
Volume	CASING CEMENTED	SIZE	No. Ft.	Date
Rock Pressure				
Oil	COAL WAS ENCOUNTERED AT 794 FEET	INCHES	FEET	INCHES
Fresh water	FEET	INCHES	FEET	INCHES
Salt water	FEET	INCHES	FEET	INCHES

Formation	Color	Hard or Soft	Top	Bottom	Oil, Gas or Water	Depth Found	Remarks
Pittsburgh Coal			794	799			
Dunkard			1195	1302			
Salt			1575	1895			
Maxon			2055	2075			
Big Injun			2245	2276			
Total Depth			2283				

(Over)

1940

70514

Greendale District, Doddridge County, W. Va.
By William H. Wood, 209 W. Main St., Salem, W. Va.
On 200 acres.
Elevation, 1283' ±.

Surface owned by Hope Construction & Refining Co., Clarksburg, W. Va.,
and minerals by Wilbur Coal & Coke Co., South Bethlehem, Pa.

6" casing, 1570'; 5" casing, 2212'; 2" tubing, 2300'.

Coal was encountered at 79'-700'.

Oil well. Abandonment reported to Dept. of Mines August 16, 1940.
Record to BOP from Mrs. Griffith August 16, 1940.

	Top.	Bottom.
Pittsburgh Coal	794	- 799
Richard sand	1195	- 1302
Salt sand	1575	- 1895
Clinton sand	2075	- 2275
Big Injun sand	2283	- 2274
Total depth		2283