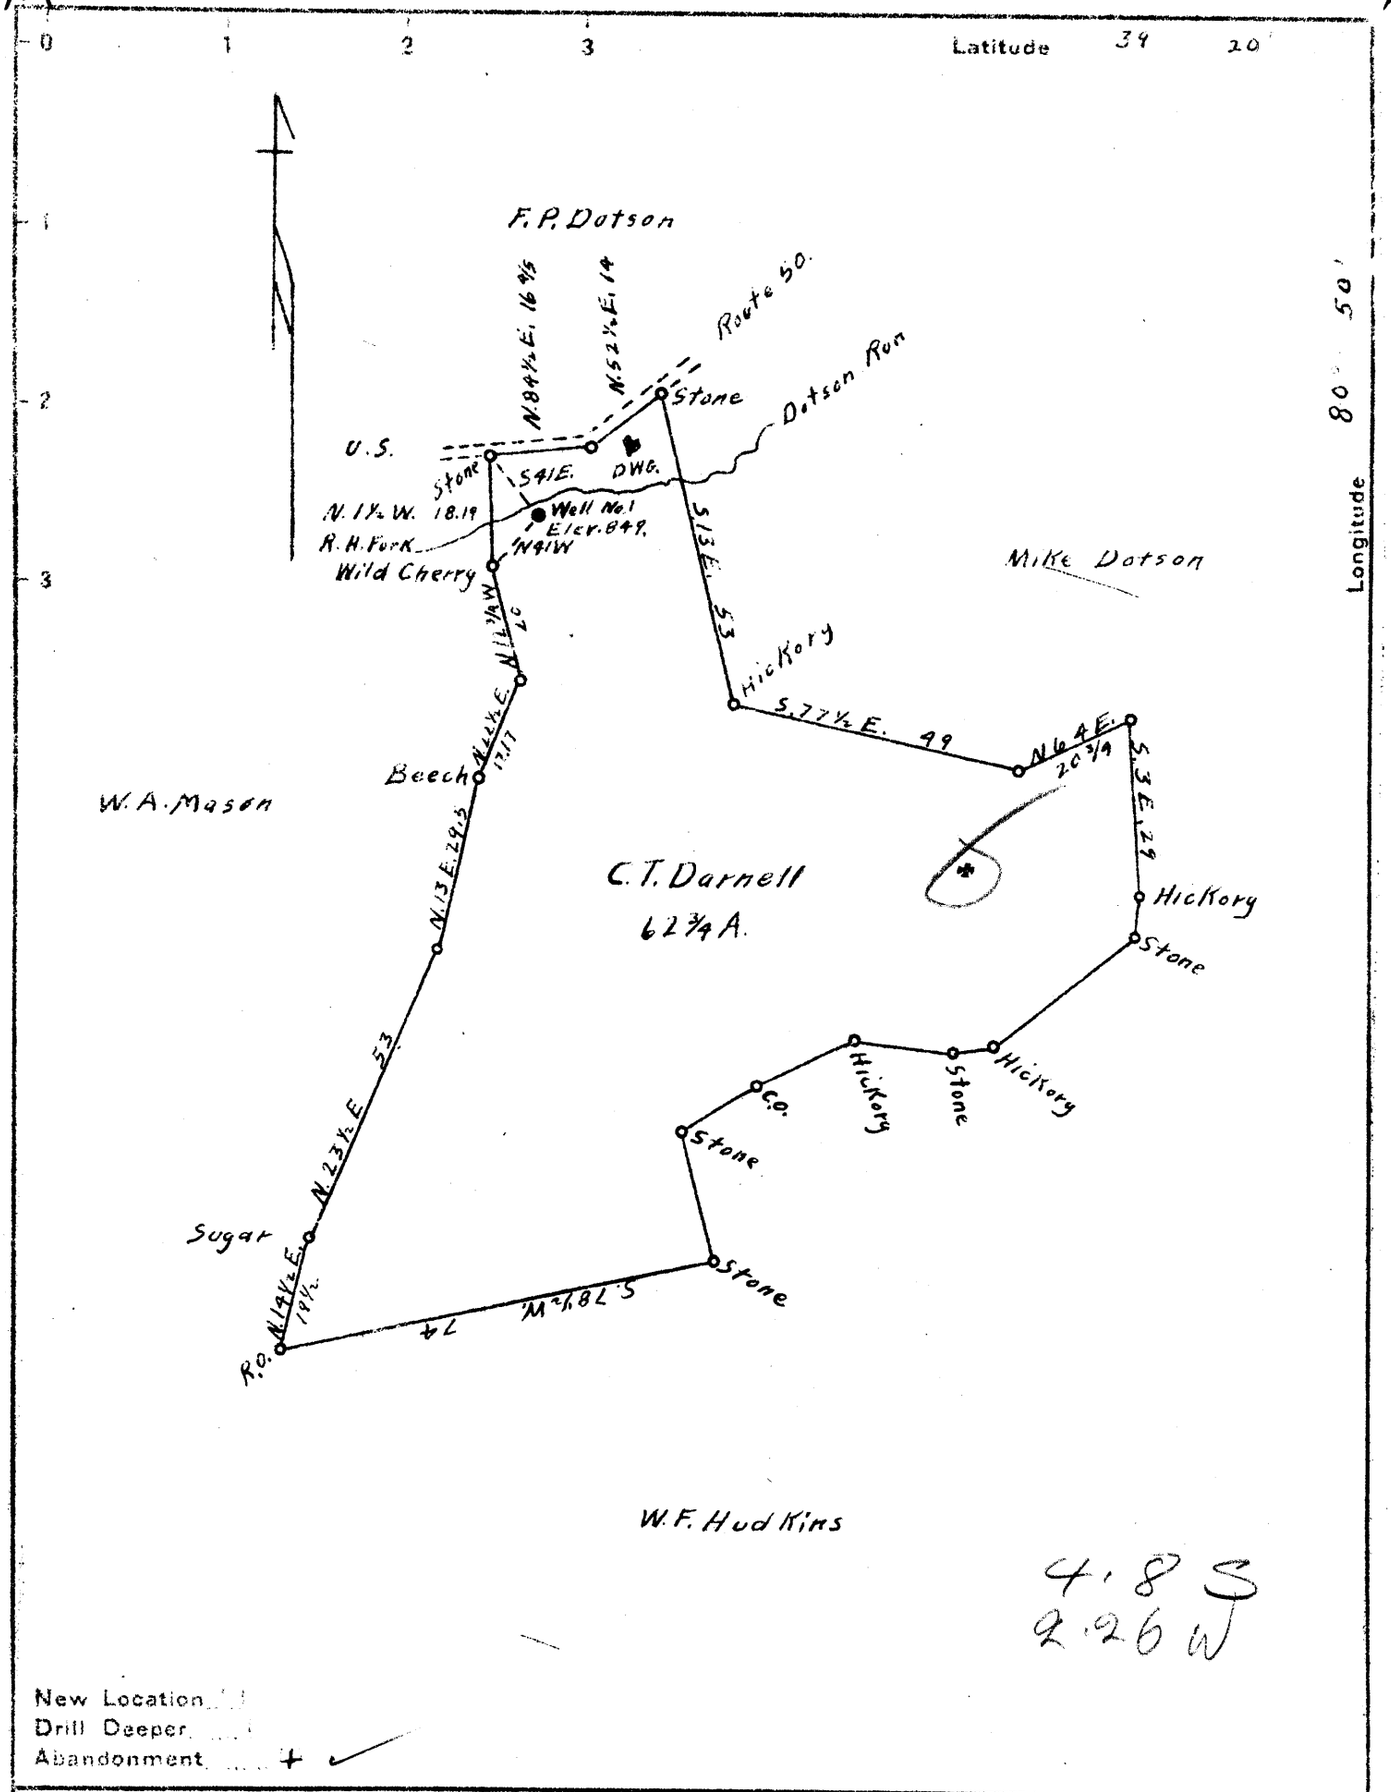

4.8 S
2.26 W

New Location (+)
Drill Deeper
Abandonment

Company Reno Oil Co.
Address Sistersville, W. Va.
Farm C. T. Darnell
Tract ____ Acres 62 3/4 Lease No. ____
Well (Farm) No. One Serial No. ____
Elevation (Spirit Level) 849
Quadrangle West Union
County Doddridge District Central
Engineer A. K. Westfall
Engineer's Registration No. Co. Surveyor, Ritchie, Co.
File No. ____ Drawing No. ____
Date June 11 1942 Scale 1" = 30 Poles

STATE OF WEST VIRGINIA
DEPARTMENT OF MINES
OIL AND GAS DIVISION
CHARLESTON

WELL LOCATION MAP

FILE NO. DOD-411-A

+ Denotes location of well on United States Topographic Maps, scale 1 to 62,500, latitude and longitude lines being represented by border lines as shown.

— Denotes one inch spaces on border line of original tracing.