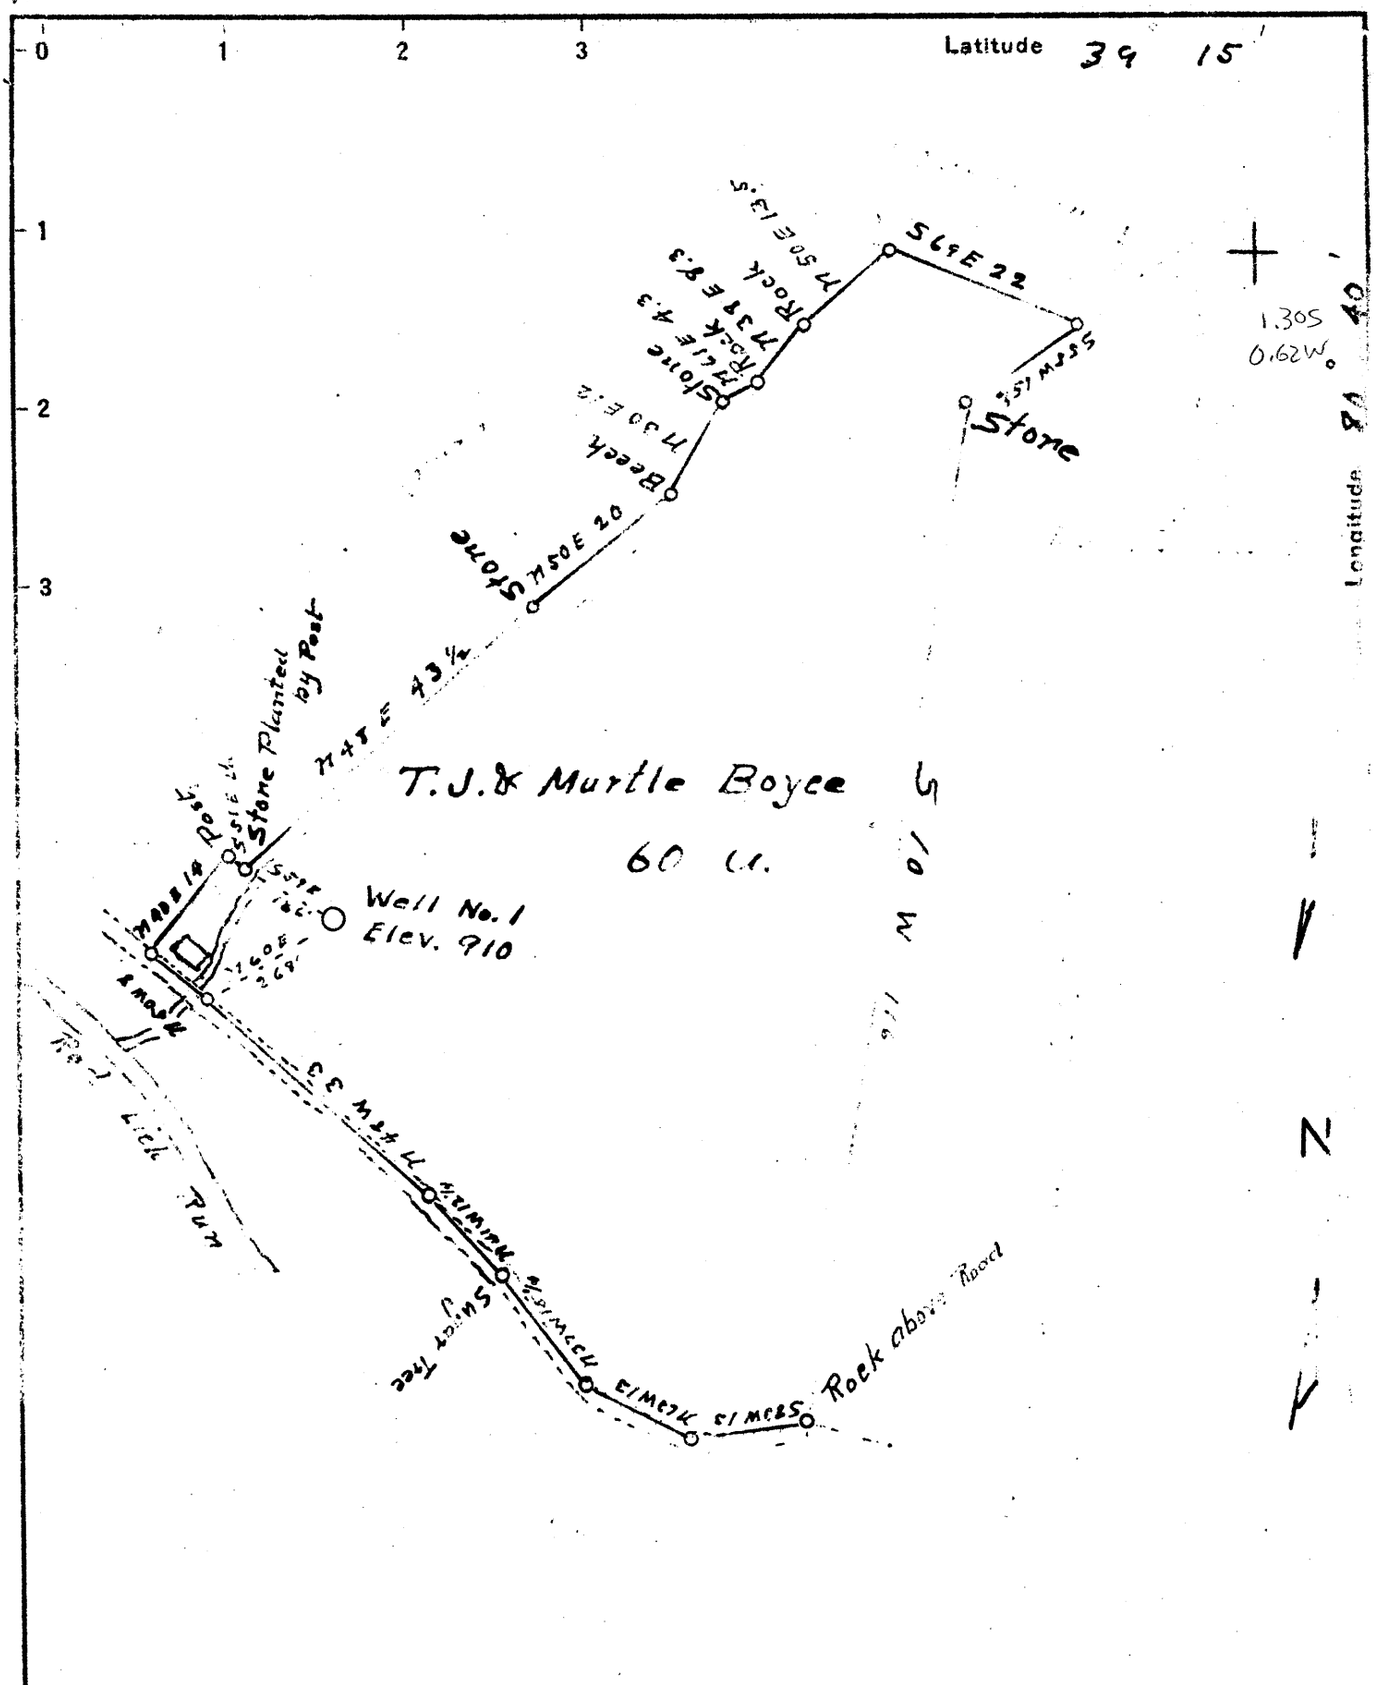

New Location ☐
Drill Deeper ☐
Abandonment ☒

Company P & M. Oil Co.
Address West Union, W.Va.
Farm T. J. & Murtle Boyce
Tract one Acres 60 Lease No.
Well (Farm) No. 1 Serial No.
Elevation (Spirit Level) 910
Quadrangle Vadis
County Doddridge District New Milton
Engineer C. M. Martin
Engineer's Registration No. 84
File No. Drawing No.
Date Feb 8 1944 Scale 20 P - 1"

STATE OF WEST VIRGINIA
DEPARTMENT OF MINES
OIL AND GAS DIVISION
CHARLESTON

WELL LOCATION MAP

FILE NO. DOD-459-A

✚ Denotes location of well on United States Topographic Maps, scale 1 to 62,500, latitude and longitude lines being represented by border lines as shown.

— Denotes one inch spaces on border line of original tracing.

"IMPERIAL" TRACING CLOTH