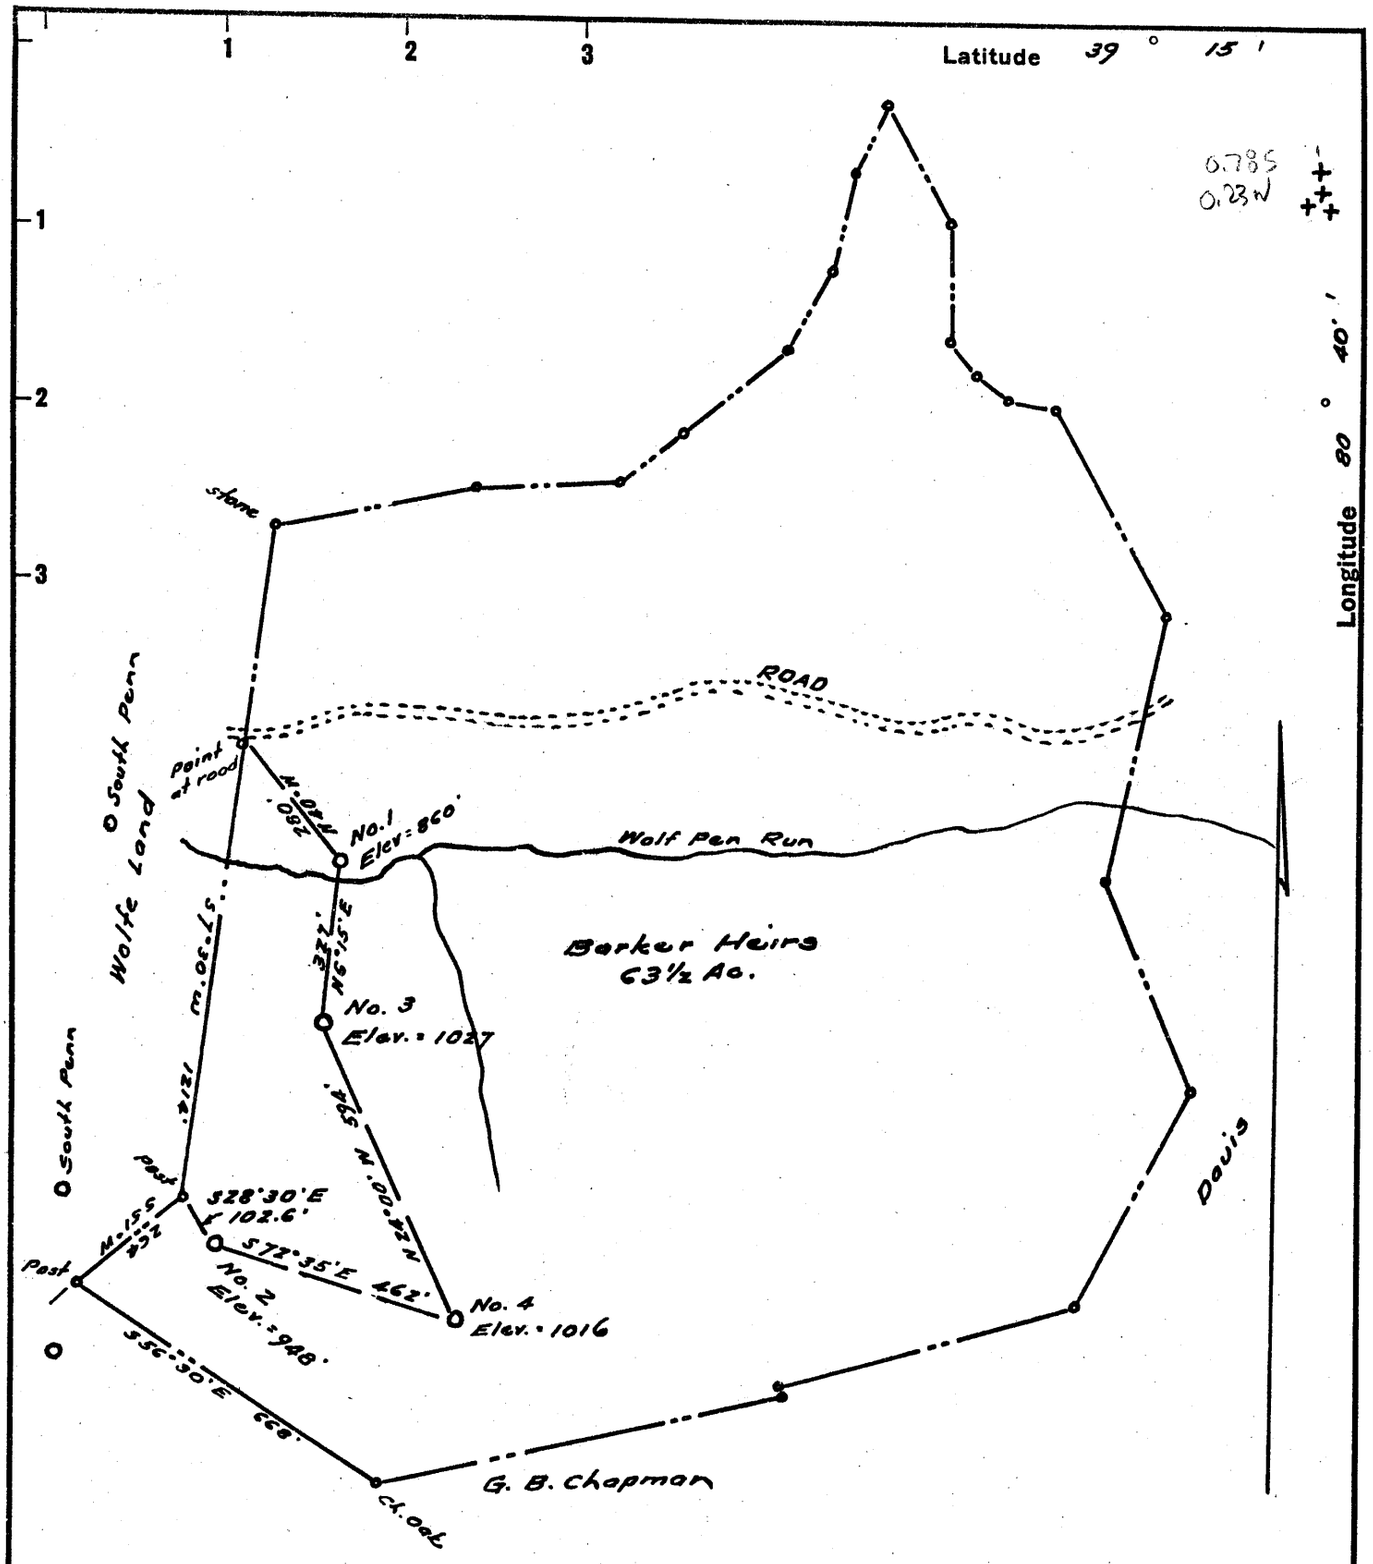

New Location ..☐
Drill Deeper .....☐
Abandonment.....☒

No coal
Surface:- Guy Kelley,
New Milton,
W.Va.

Company P. AND M. OIL CO.
Address West Union, W. Va.
Farm Barker Heirs
Tract _____ Acres 63.5 Lease No. _____
Well (Farm) No. 1, 2, 3 & 4 Serial No. _____
Elevation (Spirit Level) No.1-860, No.2-948' No.3-1027 No.4-1016'
Quadrangle Vadis
County Doddridge District New Milton
Engineer _____
Engineer's Registration No. _____
File No. _____ Drawing No. _____
Date March, 1957 Scale 1" = 20 rods

STATE OF WEST VIRGINIA
DEPARTMENT OF MINES
OIL AND GAS DIVISION
CHARLESTON

WELL LOCATION MAP

FILE NO. DOD-1070-A-#1

+ Denotes location of well on United States Topographic Maps, scale 1 to 62,500, latitude and longitude lines being represented by border lines as shown.

— Denotes one inch spaces on border line of original tracing.

11 IMPERIAL 6C046