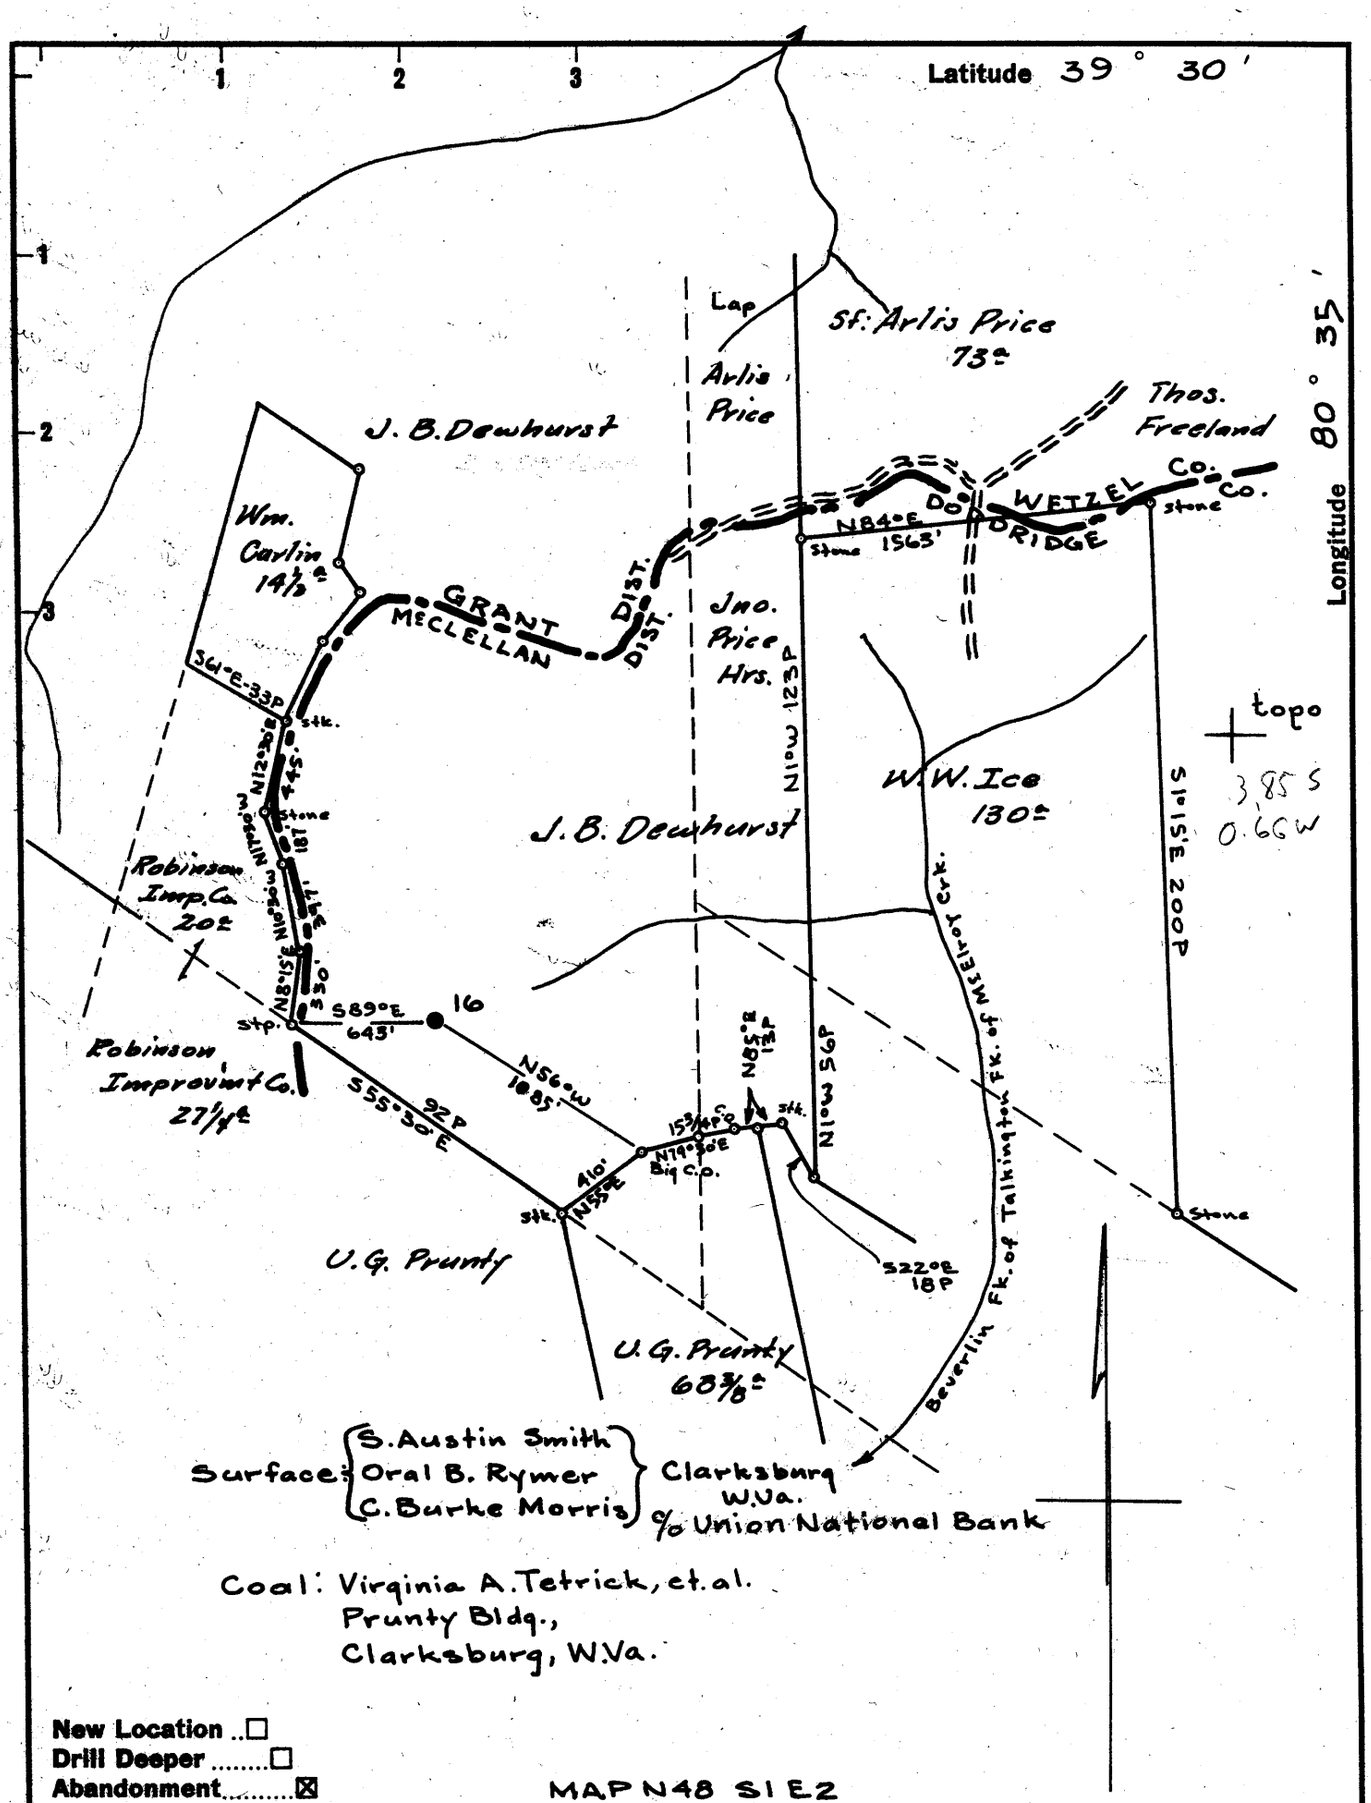

Surface: S. Austin Smith, Oral B. Rymer, C. Burke Morris } Clarksburg W.Va. c/o Union National Bank

Coal: Virginia A. Tetrick, et al.
Prunty Bldg.,
Clarksburg, W.Va.

New Location ..☐
Drill Deeper .....☐
Abandonment.....☒

MAP N48 S1 E2

Company SOUTH PENN OIL CO.
Address PARKERSBURG, W.Va.
Farm J. B. Dewhurst
Tract ____ Acres 1262 Lease No. 10253
Well (Farm) No. 16 Serial No. ____
Elevation (Spirit Level) 1227.45 ground
Quadrangle CENTERPOINT
County DODDRIDGE District MCCLELLAN
Engineer A. C. Hilbert
Engineer's Registration No. 2534
File No. 192 Drawing No. ____
Date May 31, 1962 Scale 1" = 800'

STATE OF WEST VIRGINIA
DEPARTMENT OF MINES
OIL AND GAS DIVISION
CHARLESTON

WELL LOCATION MAP

FILE NO. Dod-1168-A

+ Denotes location of well on United States Topographic Maps, scale 1 to 62,500, latitude and longitude lines being represented by border lines as shown.

— Denotes one inch spaces on border line of original tracing.

K&E 186 IMPERIAL TRACING CLOTH T.M. 66757

JBF