LATITUDE 39 ° 25 '

LONGITUDE 80 ° 30 '

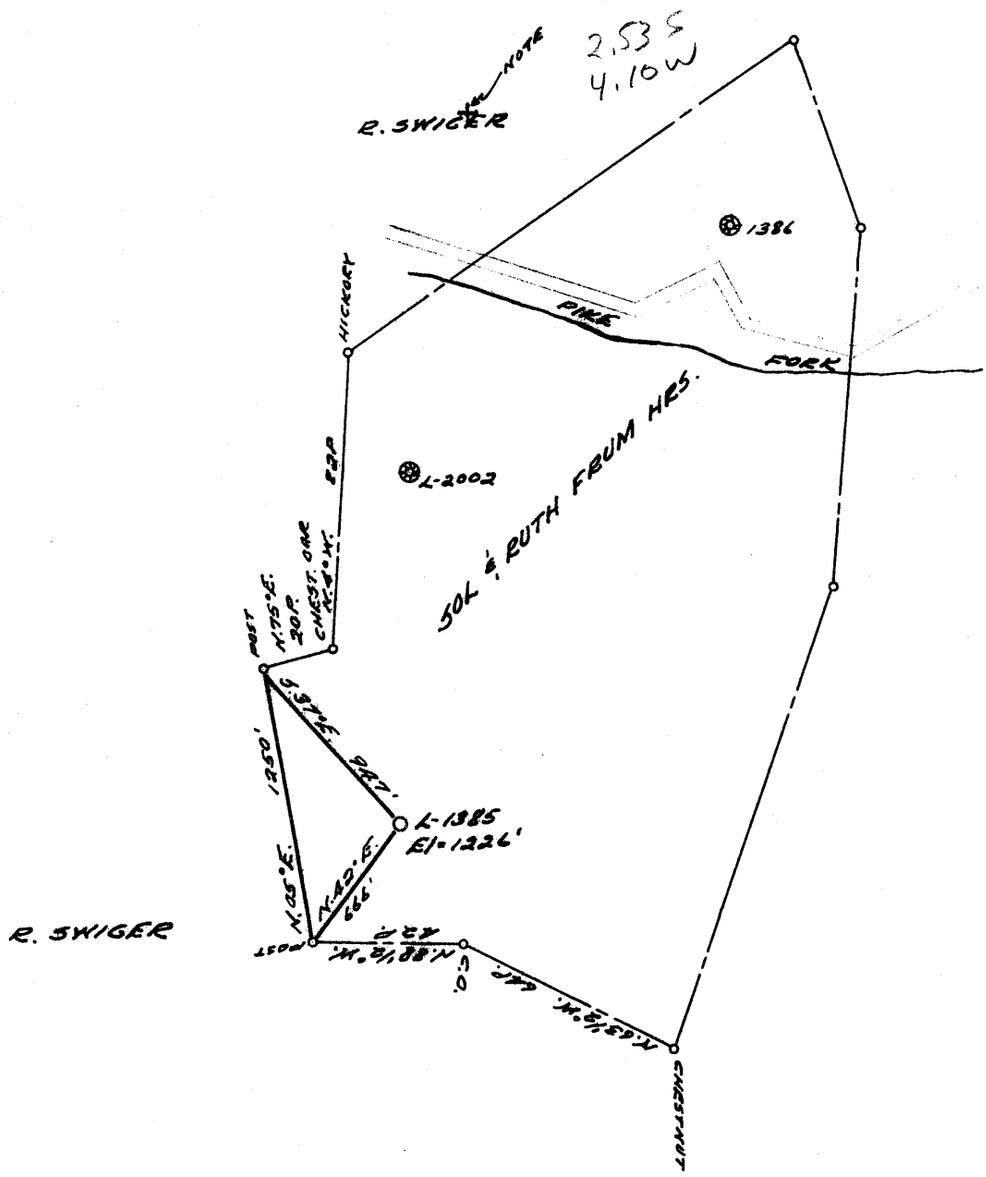

COAL OWNED BY CONSOLIDATION COAL CO. ET AL

- [ ] NEW LOCATION
- [ ] RECONDITION
- [ ] DRILL DEEPER
- [x] ABANDONMENT

"I, the undersigned, hereby certify that this map is correct to the best of my knowledge and belief and shows all the information required by paragraph 6 of the rules and regulations of the oil and gas section of the mining laws of West Virginia."

Minimum degree of accuracy is one part in 200'

Signed Robert M. Neill (D.C.)

COMPANY THE MANUFACTURERS LIGHT & HEAT CO

ADDRESS 800 UNION TRUST BLDG. PGH. PA.

FARM SOL FRUM HRS

MAP 9-25-14 ACRES 193 LEASE NO. 2795

WELL (FARM) NO. 1 SERIAL NO. 2 1385

ELEVATION (SPIRIT LEVEL) 1226'

QUANDRANGLE CENTERPOINT EC

COUNTY DODDRIDGE DISTRICT McCLELLAN

POINT OF PROVEN ELEVATION B.M. ON SYCAMORE FORK APPROX. 6500' N.W. OF WELL. B.M. El = 932'

FILE NO. DRAWING NO. V-28-386

DATE JAN. 19, 1967 SCALE 1" = 800'

STATE OF WEST VIRGINIA

DEPARTMENT OF MINES

OIL AND GAS DIVISION

CHARLESTON

WELL LOCATION MAP

FILE NO. 000-1199-9

+ DENOTES LOCATION OF WELL ON UNITED STATES TOPOGRAPHIC MAPS, SCALE 1 TO 62,500, LATITUDE AND LONGITUDE LINES BEING REPRESENTED BY BORDER LINES AS SHOWN.

— DENOTES ONE INCH SPACES ON BORDER LINE OF ORIGINAL TRACING.

17 5153 (196) IMPERIAL A. & B. SMITH CO. PGH., PA.

PR 6462-363

MAR 1 1967