Plot ✓ Log ___ Card ✓ CSD ___ Mflm ___

4-14-69-D.O.D.D.

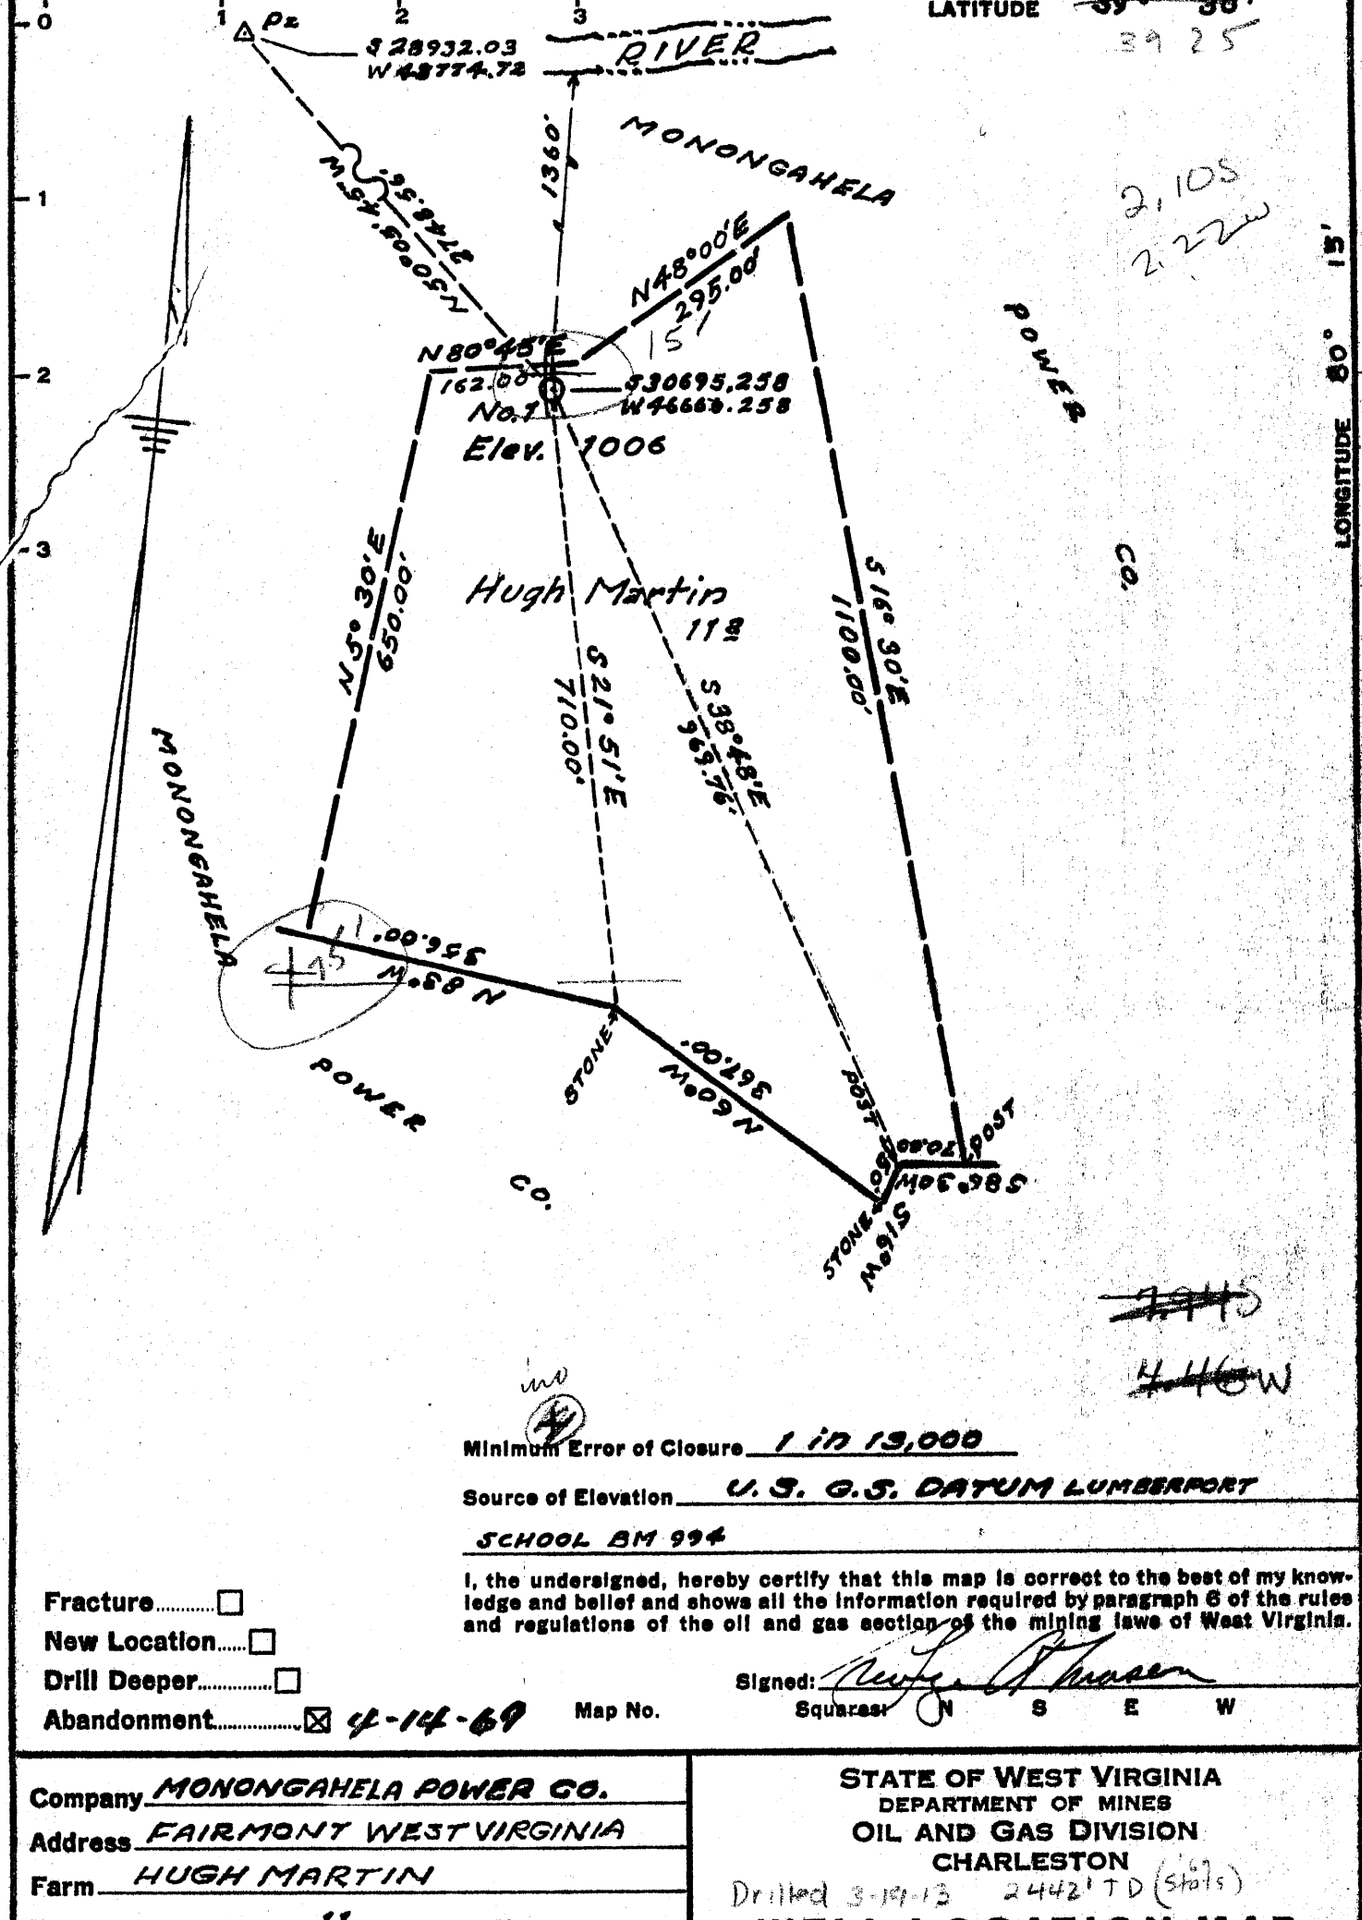

~~1445~~

~~446W~~

Minimum Error of Closure 1 in 13,000

Source of Elevation U. S. G. S. DATUM LUMBERPORT

SCHOOL BM 994

I, the undersigned, hereby certify that this map is correct to the best of my knowledge and belief and shows all the information required by paragraph 6 of the rules and regulations of the oil and gas section of the mining laws of West Virginia.

Signed: [signature]

Fracture ☐
New Location ☐
Drill Deeper ☐
Abandonment ☒ 4-14-69

Map No. Square: N S E W

Company MONONGAHELA POWER CO.
Address FAIRMONT WEST VIRGINIA
Farm HUGH MARTIN
Tract ___ Acres 11 Lease No. ___
Well (Farm) No. 1 Serial No. K-20
Elevation (Spirit Level) 1006
Quadrangle CLARKSBURG NE
County HARRISON District EAGLE
Engineer BERNARD G. SAMPSON CO. INC.
Engineer's Registration No. 3628
File No. ___ Drawing No. ___
Date 3/21/69 Scale 1" = 200'

STATE OF WEST VIRGINIA
DEPARTMENT OF MINES
OIL AND GAS DIVISION
CHARLESTON

Drilled 3-19-13 2442' TD (Stats)

WELL LOCATION MAP

FILE NO. HAR-1857 (A)

+ Denotes location of well on United States Topographic Maps, scale 1 to 62,500, latitude and longitude lines being represented by border lines as shown.

— Denotes one inch spaces on border line of original tracing.

K-E IMPERIAL TRACING CLOTH 72163

APR 20 1969