


Latitude 39° 00'

Longitude 81° 35'

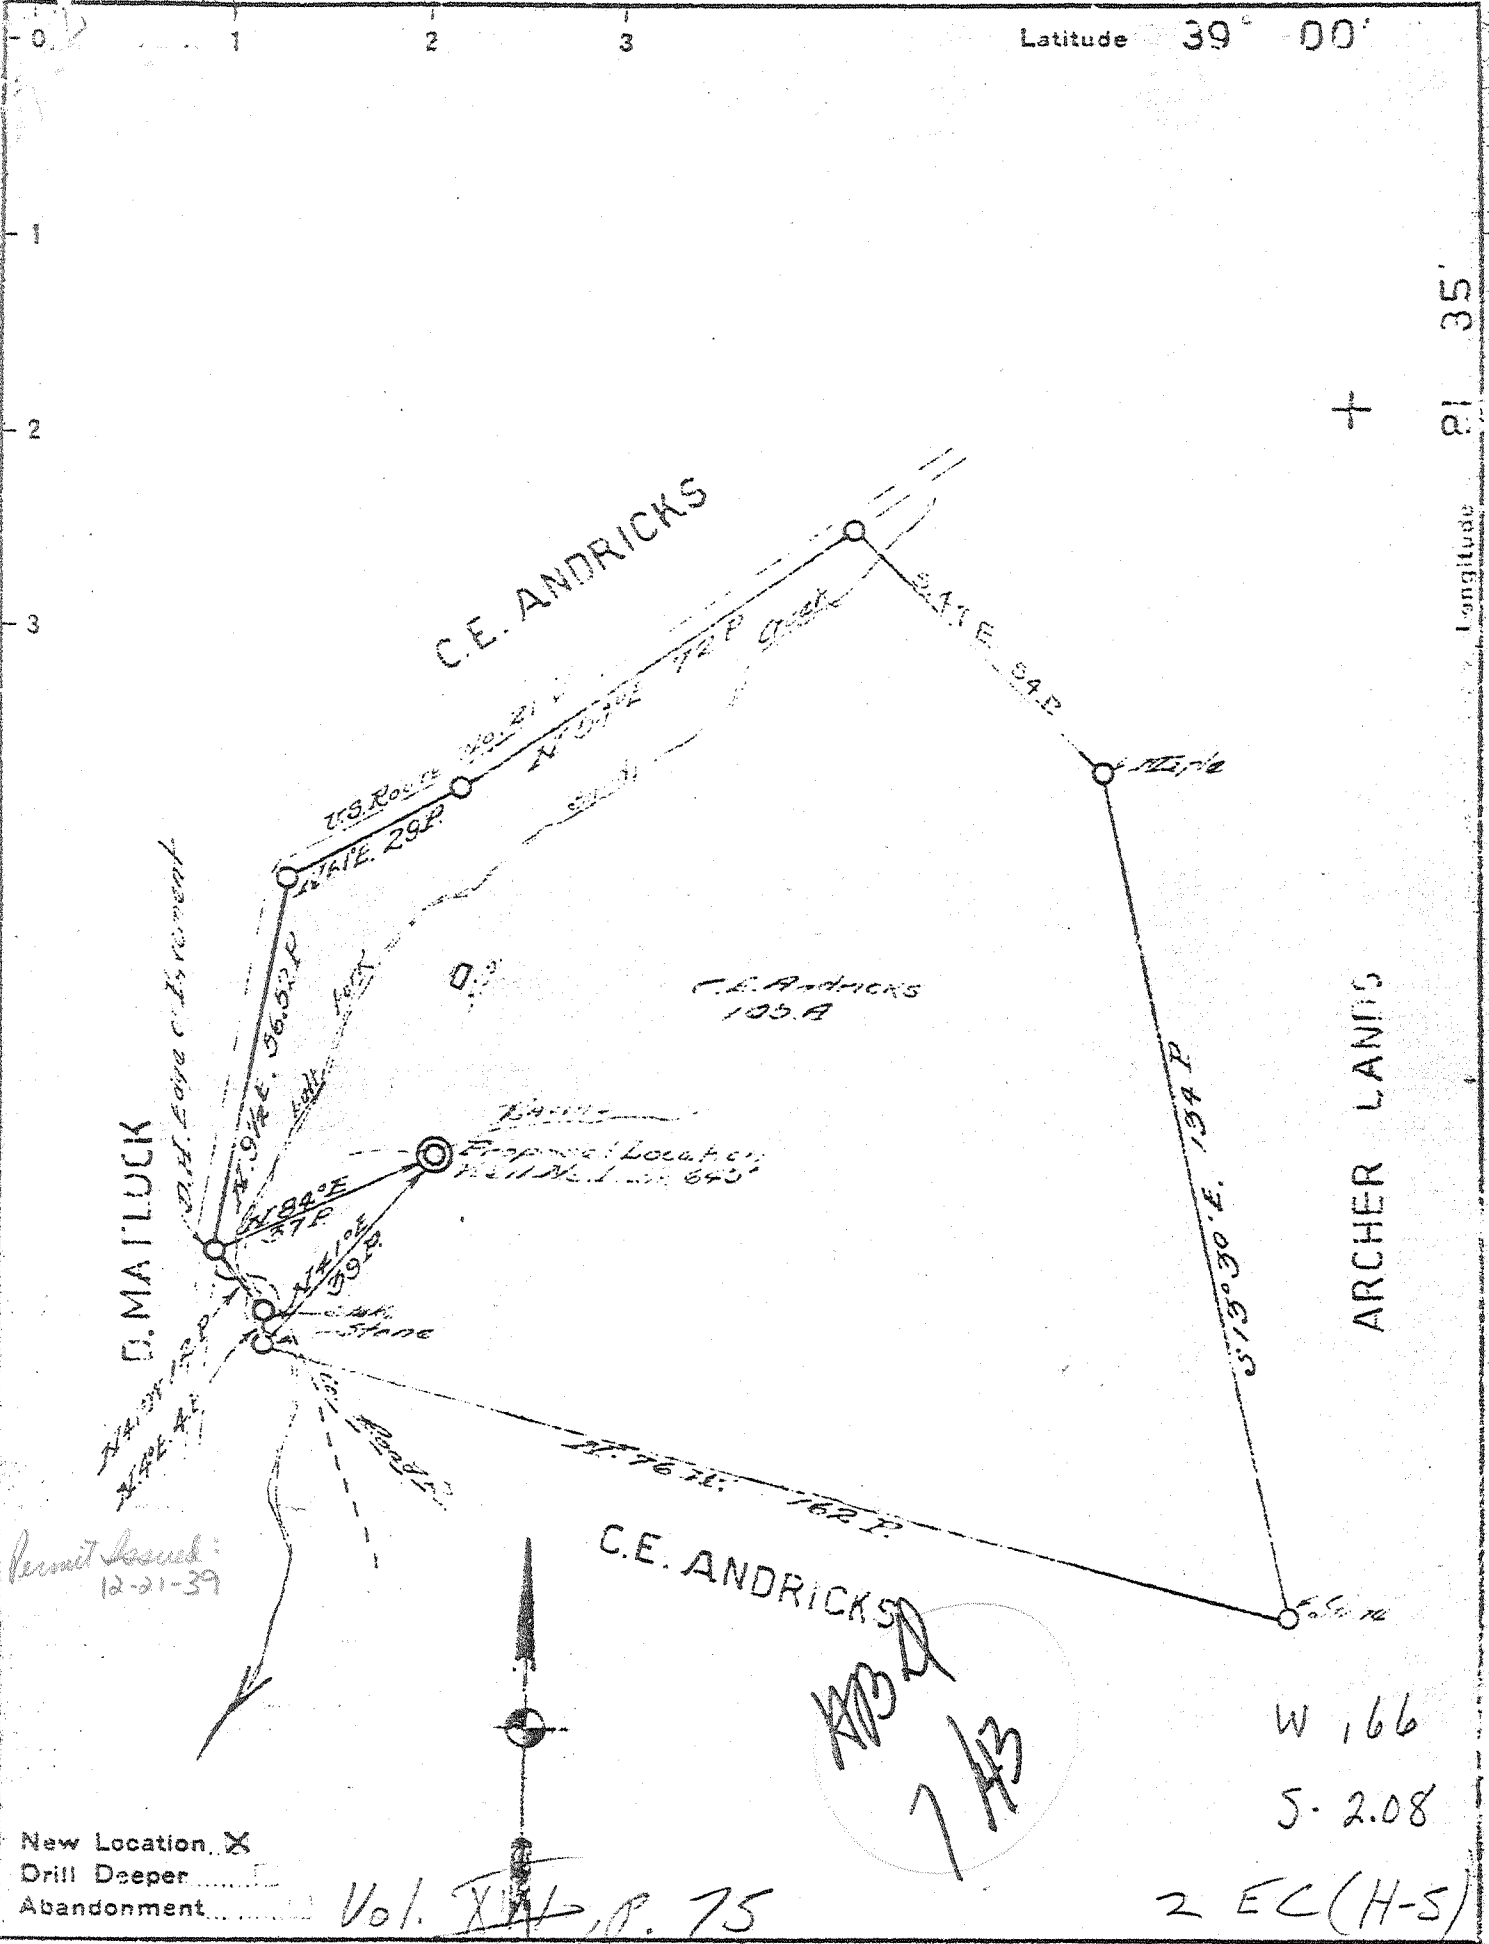

New Location
 Drill Deeper
 Abandonment

Vol. XIV, P. 75

2 EC (H-S)

Company	JOE RUBIN ET AL
Address	1900 19TH ST PARKER BURG W.VA.
Farm	C.E. ANDRICKS
Tract	1 Acres 105 Lease No.
Well (Farm) No.	1 Serial No.
Elevation (Spirit Level)	645'
Quadrangle	RIPLEY-NC.
County	JACKSON District GRANT
Engineer	J.E. ANDERTON
Engineer's Registration No.	SURVEYOR
File No.	Drawing No.
Date	NOV 30 1939 Scale 1"=30 POLES

STATE OF WEST VIRGINIA
 DEPARTMENT OF MINES
 OIL AND GAS DIVISION
 CHARLESTON

WELL LOCATION MAP
 FILE NO. JAC-63

+ Denotes location of well on United States Topographic Maps, scale 1 to 62,500, latitude and longitude lines being represented by border lines as shown.

- Denotes one inch spaces on border line of original tracing.

SAMPLES 4-K (530-5100)

10-6-1932
 Deep Well ✓

WEST VIRGINIA DEPARTMENT OF MINES
OIL & GAS DIVISION
WELL RECORD

Permit No. Jac-63
Ripley Quad.

Gas Well

CASING & TUBING

Company	Joe Rubin, et al	16	Cond.	21
Address	1900 - 19th St., Parkersburg, W. Va.	14	542	542
Farm	C. E. Andricks ACRES 105	10	946	
Location	Left Fork Sandy Creek	8-1/4	1880	
Well No.	1 ELEV. 645	5-3/16	4906	SLM
District	Grant - Jackson County			
Surface & Mineral	C. E. Andricks, Sandyville, W. Va.			
Commenced	March 17, 1940			
Completed	July 5, 1940			
Shot	7/5/40			
Open Flow	-			
Volume	- 103 MCF			
Rock Pressure	- 1675			
Water	-			

Soil	0	10	Slate	1254	1270
Sand	10	35	Sand	1270	1300
Rock - red	35	45	Slate	1300	1320
Shale - blue	45	70	Sand	1320	1350
Sand	70	85	Slate	1350	1390
Slate	85	95	Sand	1390	1400
Rock - red	95	109	Slate	1400	1410
Sand	109	135	Sandy Lime	1410	1430
Slate	135	145	Sand	1430	1471
Sand	145	179	Slate	1471	1480
Rock - red	179	185	Sand	1480	1514
Slate	185	195	Shale	1514	1581
Sand	195	240	Lime - black	1581	1587
Slate	240	255	Sand	1587	1760
Sand	255	265	Lime - Big lime	1760	1825
Slate	265	270	Sand - Inj	1825	1888
Rock - red	270	290	Lime - black	1888	1901
Slate - blue	290	325	Slate	1901	1906
Rock - red	325	335	Broken Sand - <i>work?</i>	1906	1975
Slate	335	355	Slate&Shells	1975	2160
Rock - red	355	380	Coffee Shale	2160	2170
Slate	380	435	Berea	2170	2173
Rock - red	435	445	Slate - blue	2173	2233
Slate	445	450	Slate&Shales	2233	3384
Rock - red	450	457	Shale - brown - 441	3384	3440
Slate	457	462	Slate - blue	3440	3830
Sand	462	540	Shale - brown	3830	3881
Slate	540	565	Slate	3881	4020
Rock - red	565	595	Shale - black	4020	4070
Sand	595	630	Slate - blue	4070	4570
Slate	630	670	Shale - black	4570	4854
Rock - red	670	700	Lime - black	4854	4864 S.L.M.
Slate - blue	700	705	Correction	4854	- 4886 -
Rock - red	705	765	Lime - gray & white	4864	4997
Sand	765	810	Sand - ORISKANY	4997	5065
Slate	810	845	Lime	5065	5073
Rock - red	845	865	Sand & Lime <i>Field</i>	5073	5082
Slate	865	928	Lime	5082	5100
Sand	928	950			
Slate	950	993			
Red	993	995	1 bailer of water at 115		
Slate	995	1020	5 " " 150		
Sand	1020	1098	5 " " 512 518		
Slate	1098	1109	Hole full " 1620-1625		
Sand	1109	1145			
Slate	1145	1160			
Sand	1160	1193			
Slate	1193	1219			
Sand	1219	1254			

485