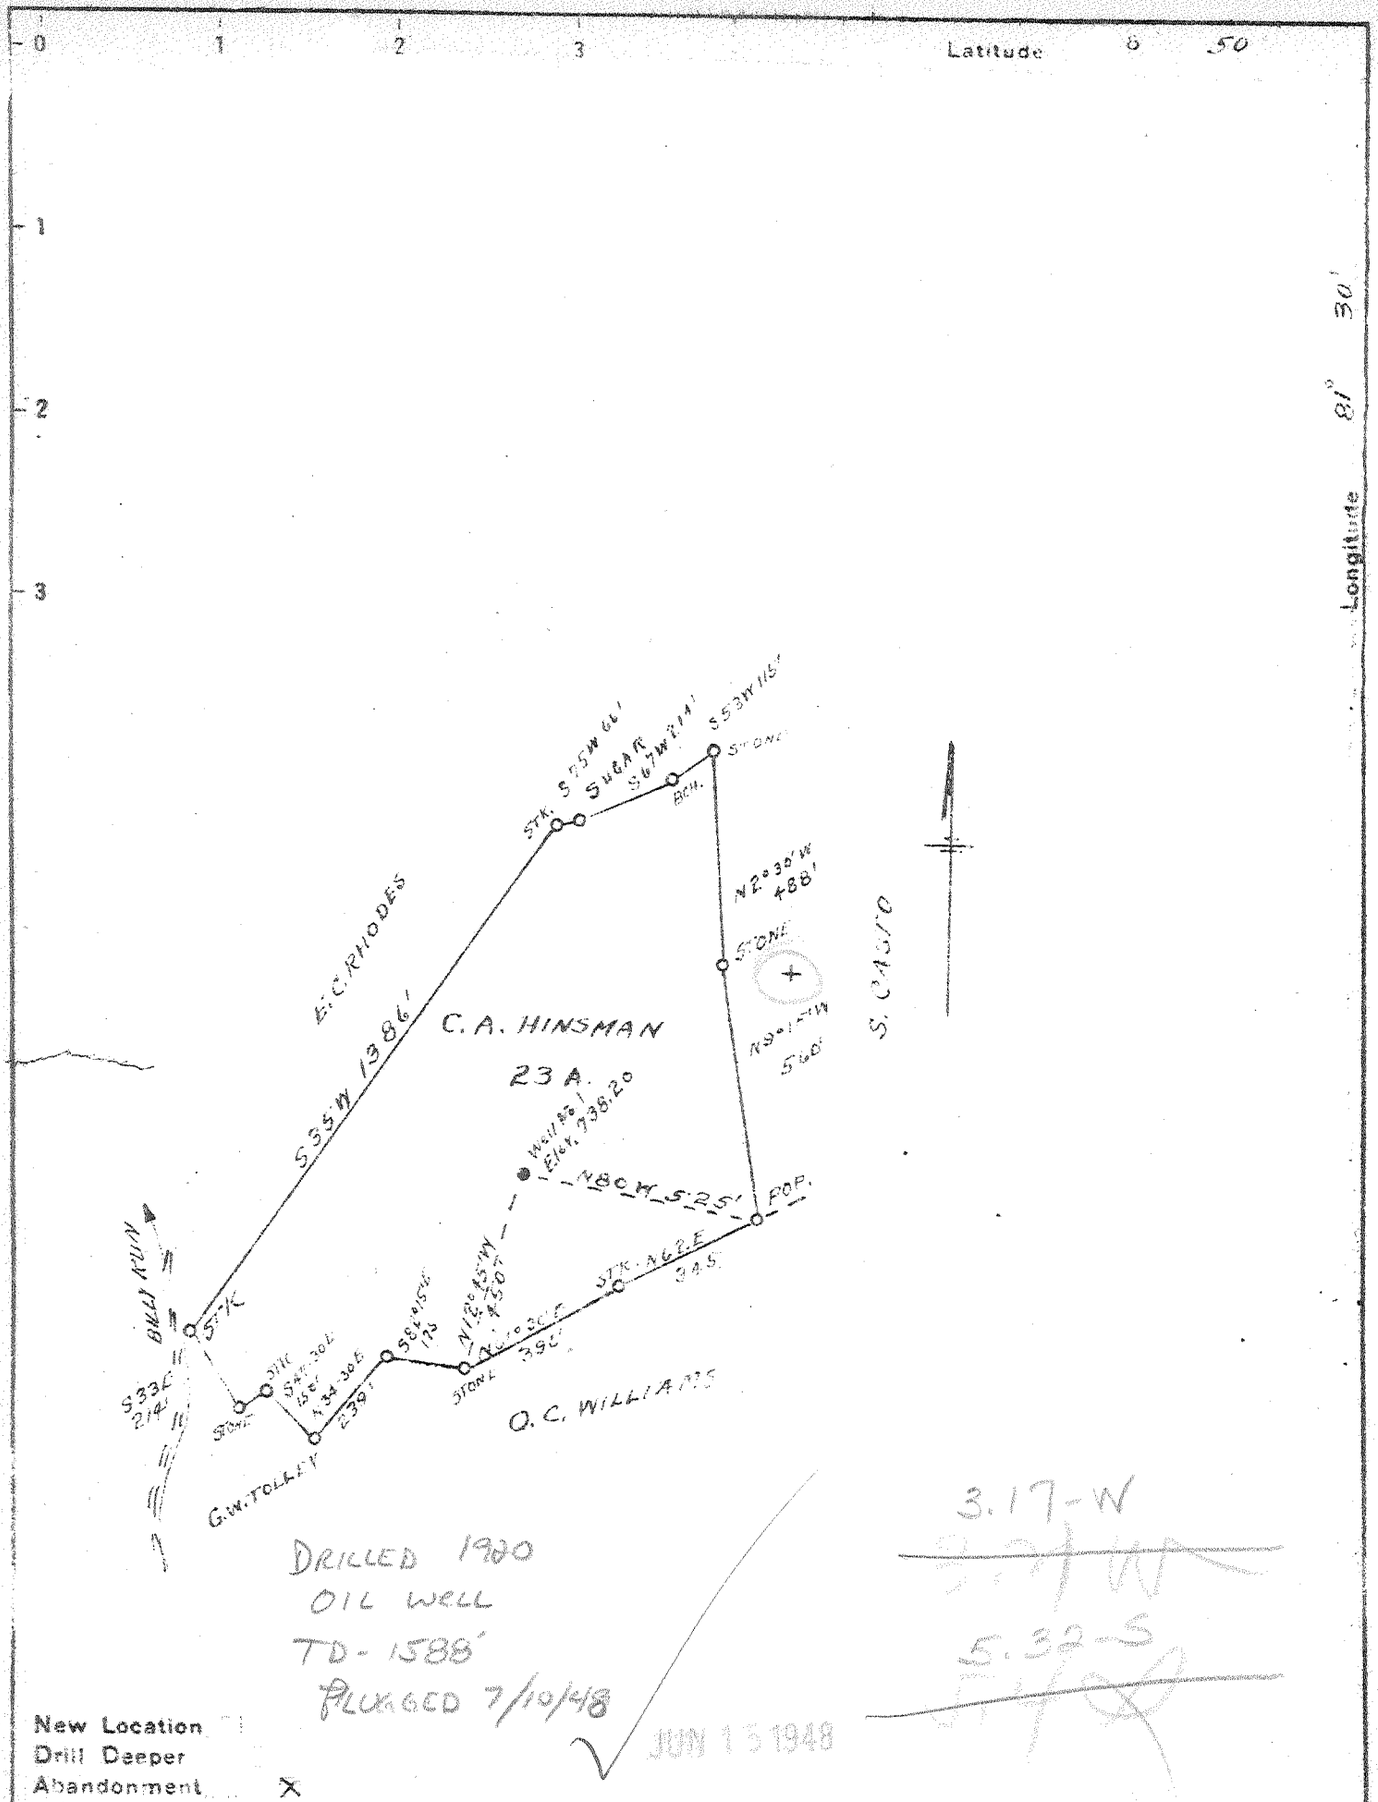

DRILLED 1900
OIL WELL
TD - 1588'
PLUGGED 7/10/48

3.17-W
5.32-S

JUN 15 1948

New Location
Drill Deeper
Abandonment X

Company WALKER BEREN OIL & GAS CO.
Address PARKERSBURG, W. VA.
Farm C. A. HINSMAN
Tract ____ Acres 2.9 Lease No. ____
Well (Farm) No. 1 Serial No. 1409
Elevation (Spirit Level) 738.20
Quadrangle RIPLEY
County JACKSON District WASHINGTON
Engineer A. G. Frye
Engineer's Registration No. 804
File No. ____ Drawing No. ____
Date 5-3-48 Scale 1" = 400'

STATE OF WEST VIRGINIA
DEPARTMENT OF MINES
OIL AND GAS DIVISION
CHARLESTON

WELL LOCATION MAP

FILE NO JAC-108-A

+ Denotes location of well on United States Topographic Maps, scale 1 to 62,500, latitude and longitude lines being represented by border lines as shown.

— Denotes one inch spaces on border line of original tracing.

6-6 Gay (163)

C. A. HINSMAN NO. 1 (A09) — WALKER-BEREN OIL & GAS CO. — JAC-108-A