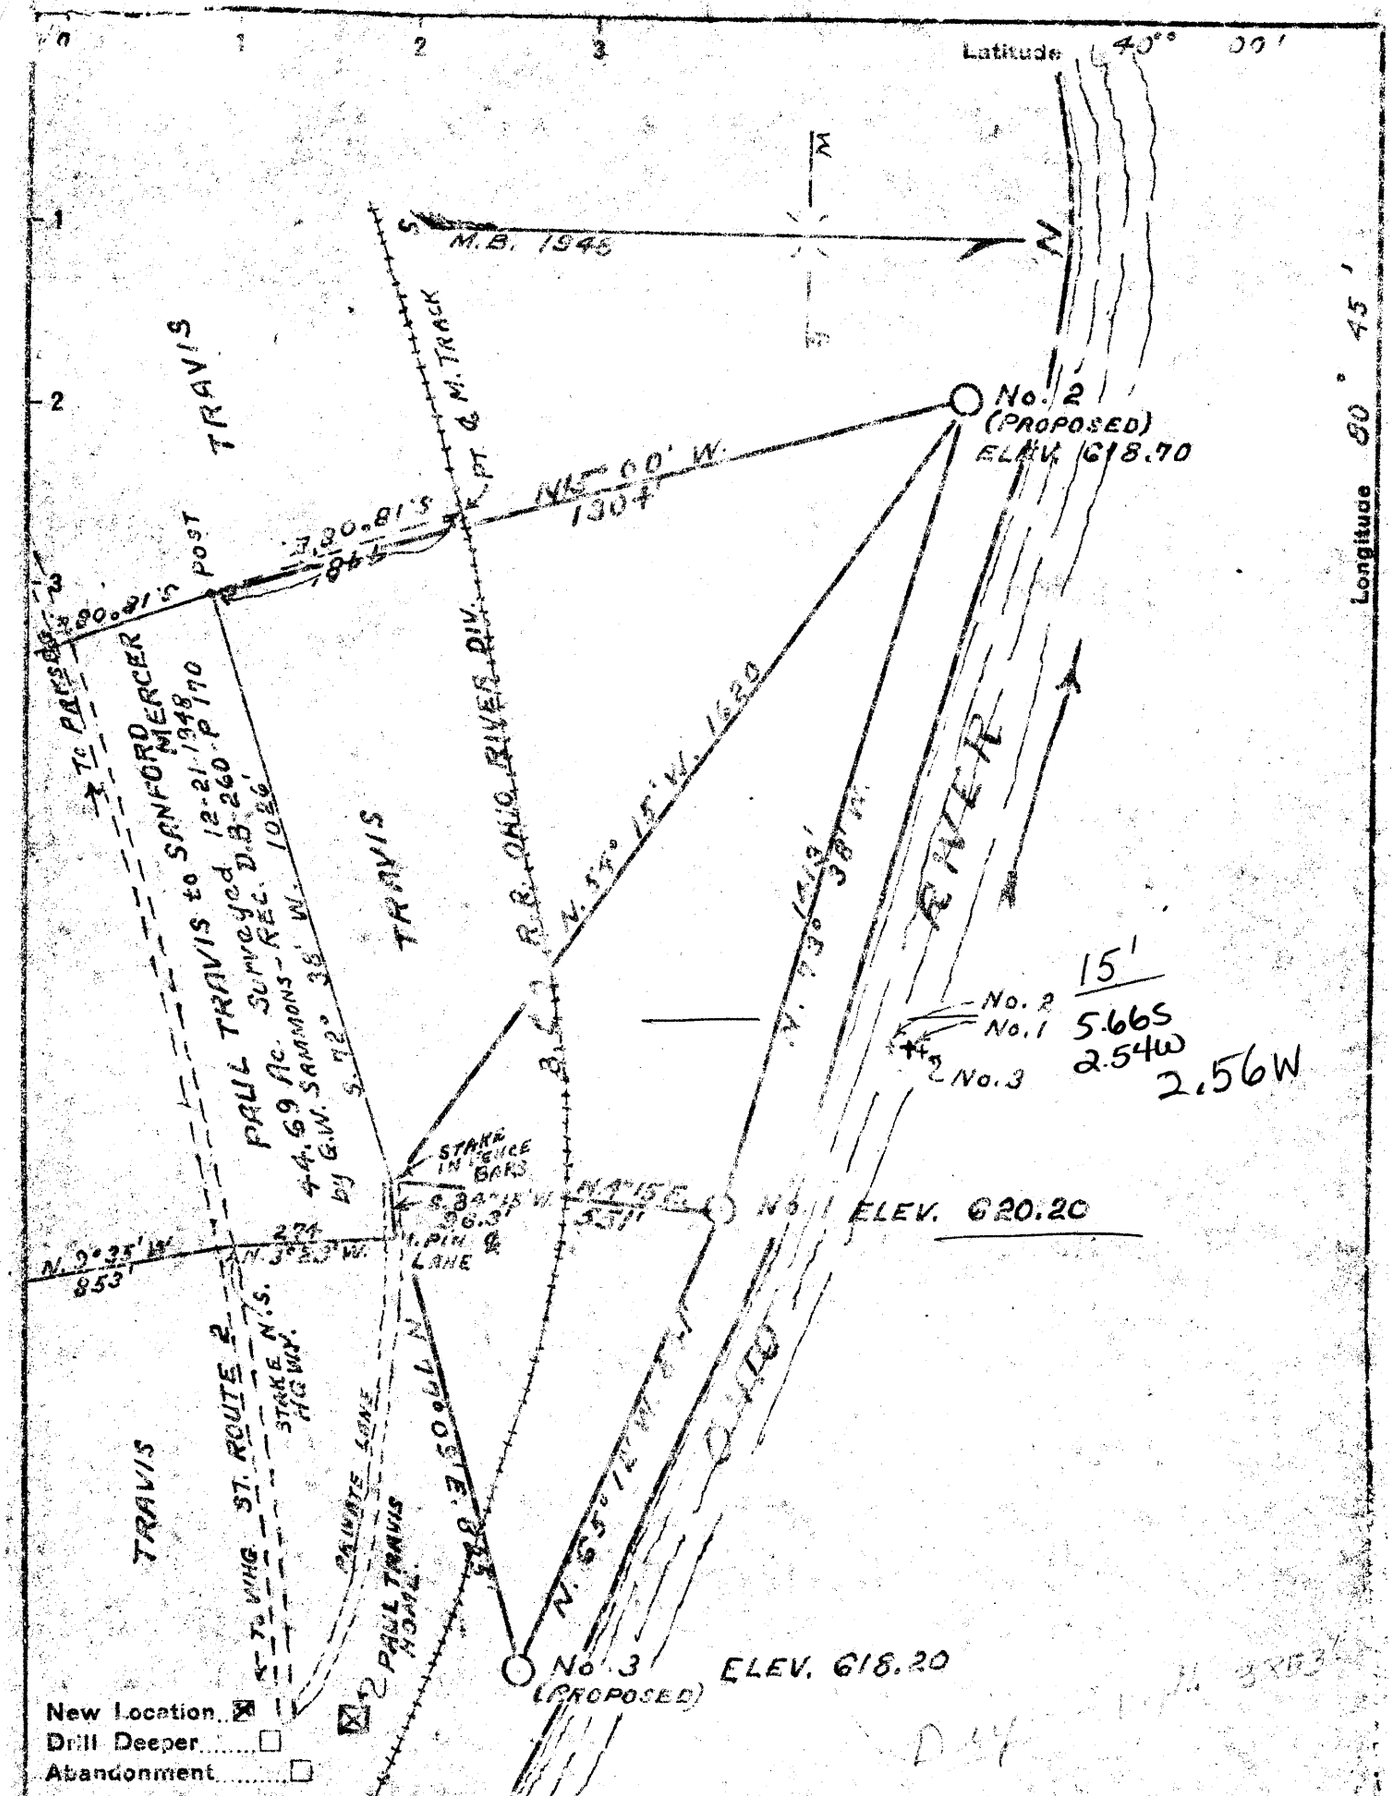

Company HARRY MASEE
Address PROCTOR, W. VA. R.D. 3
Farm PAUL TRAVIS
Tract _____ Acres 1.25 Lease No. _____
Well (Farm) No. 1 Serial No. _____
Elevation (Spirit Level) No. 1-620.20 ~~No. 2-618.70~~ ~~No. 3-618.20~~
Quadrangle CLARINGTON
County MARSHALL District CLAY
Engineer GORDON W. SAMMONS
Engineer's Registration No. 508
File No. _____ Drawing No. _____
Date MAR. 4, 1960 Scale 1 inch = 300 ft.

STATE OF WEST VIRGINIA
DEPARTMENT OF MINES
OIL AND GAS DIVISION
CHARLESTON

WELL LOCATION MAP
FILE NO. MARS 214

+ Denotes location of well on United States Topographic Maps, scale 1 to 62,500, latitude and longitude lines being represented by border lines as shown.

— Denotes one inch spaces on border line of original tracing.

D 4

6 - 6 D

OG-10

STATE OF WEST VIRGINIA
DEPARTMENT OF MINES
OIL AND GAS DIVISION

WELL RECORD

Permit No. MARS-214 Oil or Gas Well Dry hole (KIND)

Company Harry McBee
Address R. D. #3, Proctor, W. Va.
Farm Paul Travis Acres 135
Location (waters)
Well No. 1 Elev.
District Clay County Marshall
The surface of tract is owned in fee by Paul Travis
Address Moundsville
Mineral rights are owned by W. A. Hanna Co.
St. Clairsville, Ohio
Drilling commenced June 5, 1950
Drilling completed July 11, 1950
Date Shot None From To
With
Open Flow /10ths Water in Inch
/10ths Merc. in Inch
Volume Cu. Ft.
Rock Pressure lbs. hrs.
Oil bbls., 1st 24 hrs.
Fresh water 58 feet to 60 feet
Salt water 90 feet to 95 feet

Casing and Tubing	Used in Drilling	Left in Well	Packers
Size			
16			Kind of Packer
13			
10			Size of
8	8 in. 54 feet	54 ft.	
6⅝	238 "	238 "	Depth set
5 3/16			
3			Perf. top
2			Perf. bottom
Liners Used			Perf. top
			Perf. bottom

CASING CEMENTED SIZE No. Ft. Date

COAL WAS ENCOUNTERED AT 58 FEET INCHES
(PGH. 10 feet)
74 FEET INCHES FEET INCHES
FEET INCHES FEET INCHES

Formation	Color	Hard or Soft	Top	Bottom	Oil, Gas or Water	Depth Found	Remarks
Sand & Gravel			0	54'			
Lime Stone		Hard	54'	58'			
Coal			58'	60'			
Lime		Hard	60'	74'			
Coal Pgh.			74'	84'			
Lime		Soft	84'	95'			
Slate		Sofe	95'	168'			
Lime-Brown		Soft	168'	185'			
Red Rock		Soft	185'	225'			
Gray Slate		Soft	225'	238'			
Sand		Hard	238'	250'	Slight show of oil		
Slate	Gray	Soft	250'	258'			
Rock	Red	Soft	258'	275'			
Slate	Grey	Soft	275	285			
Red Rock & Slate		Soft	285	378			
Blue Shale & Slate		Soft	378	418			
Red Rock & Slate		Soft	418	475			
Blue Shale & Slate		Soft	475	515			

230

(Over)