

0100460 P

WW-7
5-02

West Virginia Department of Environmental Protection
Office of Oil & Gas

WELL LOCATION FORM: GPS

API: 47- 061 - 0460 WELL NO: No.3

FARM NAME: A.F. Conaway

RESPONSIBLE PARTY NAME: HG Energy, LLC

COUNTY: Monongalia DISTRICT: Clay

QUADRANGLE: Grant Town 7.5'

SURFACE OWNER: Albert & Terry Conaway

ROYALTY OWNER: HG Energy LLC et al.

UTM GPS NORTHING: 4,384,876

UTM GPS EASTING: 565,867 GPS ELEVATION: 401 m.


The Responsible Party named above has chosen to submit GPS coordinates in lieu of preparing a new well location plat for a plugging permit on the above well. The Office of Oil & Gas will not accept GPS coordinates that do not meet the following requirements:

1. Datum: NAD 1983, Zone: 17 North, Coordinate Units: meters, Altitude: height above mean sea level (MSL) - meters.
2. Accuracy to Datum - 3.05 meters
3. Data Collection Method:

Survey Grade GPS Post Processed Differential
 Real-Time Differential

Mapping Grade GPS Post Processed Differential
 Real-Time Differential

I the undersigned, hereby certify this data is correct to the best of my knowledge and belief and shows all the information required by law and the regulations issued and prescribed by the Office of Oil and Gas.

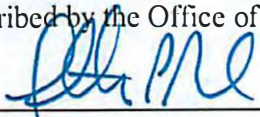

 Signature Timothy P. Roush

RECEIVED
 Office of Oil and Gas
 APR 9 2013

 Title Professional Surveyor
 West Virginia Department of Environmental Protection


_____ February 13, 2013
 Date

04/26/2013

6100460P



SUBJECT WELL
A.F. Conaway No.3
47-061-0460

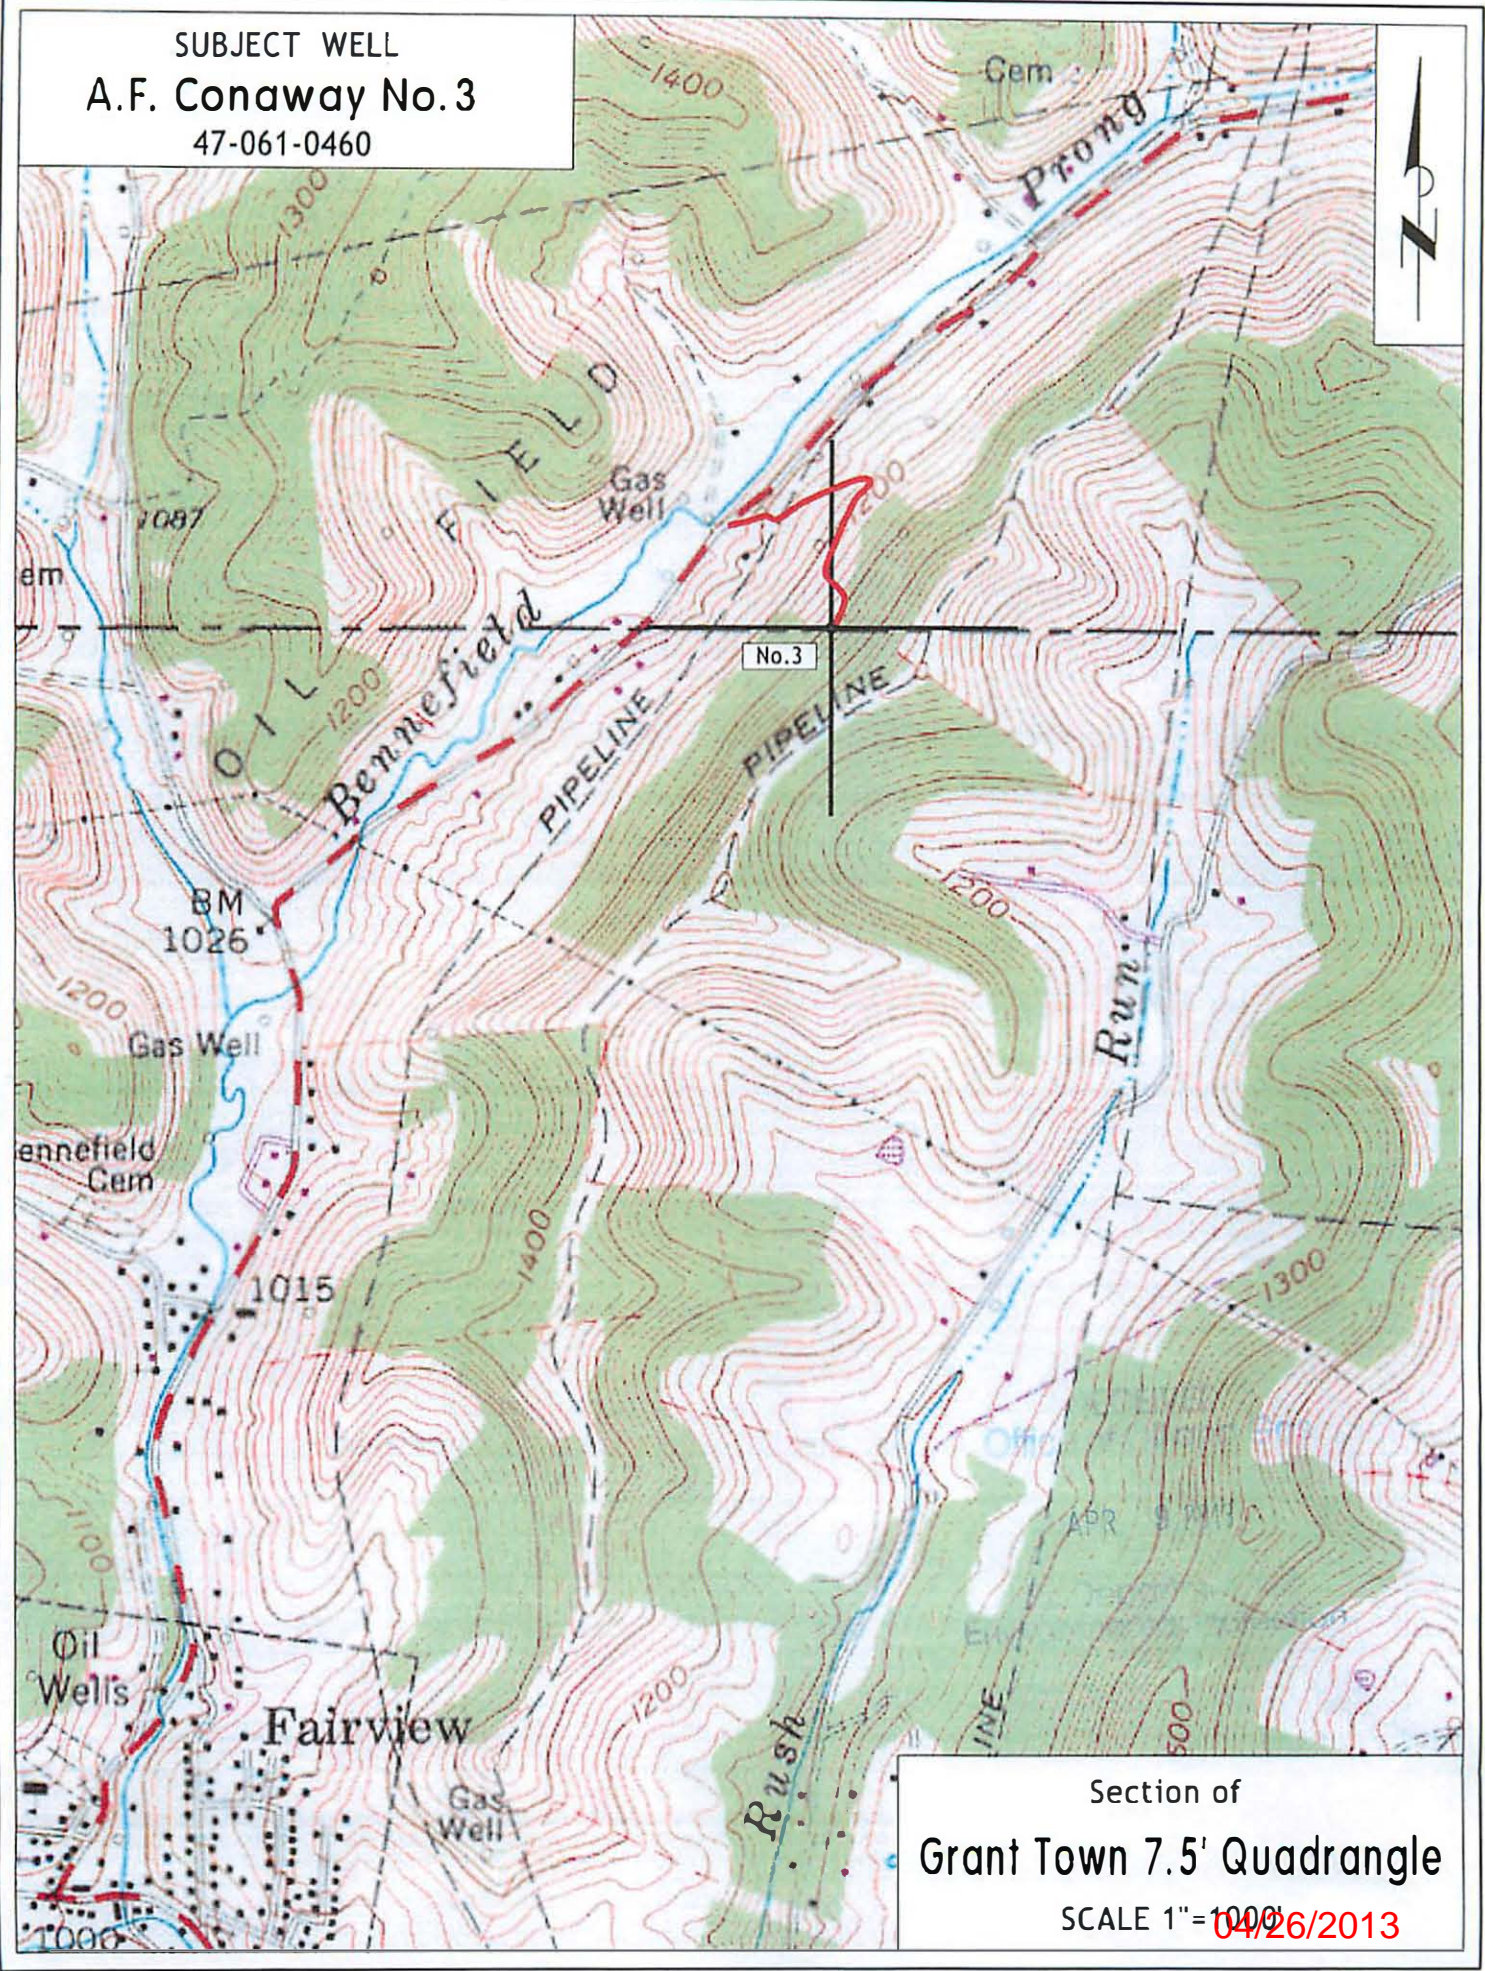

Section of
Grant Town 7.5' Quadrangle
SCALE 1" = 1000'
04/26/2013