

WW-7  
8-30-06



West Virginia Department of Environmental Protection  
Office of Oil and Gas

**WELL LOCATION FORM: GPS**

API: 47-061-00646 WELL NO.: 4189

FARM NAME: WM & E.S. YOST

RESPONSIBLE PARTY NAME: WEST VIRGINIA LAND RESOURCES INC.

COUNTY: MONONGALIA DISTRICT: BATTELLE

QUADRANGLE: WADESTOWN W.VA

SURFACE OWNER: JACK L. JR. & MARY ELLEN SHRIVER & ETAL

ROYALTY OWNER: \_\_\_\_\_

UTM GPS NORTHING: 4,386,700 m (1397')

UTM GPS EASTING: 556,067 m GPS ELEVATION: 426 m

The Responsible Party named above has chosen to submit GPS coordinates in lieu of preparing a new well location plat for a plugging permit or assigned API number on the above well. The Office of Oil and Gas will not accept GPS coordinates that do not meet the following requirements:

1. Datum: NAD 1983, Zone: 17 North, Coordinate Units: meters, Altitude: height above mean sea level (MSL) – meters.
2. Accuracy to Datum – 3.05 meters
3. Data Collection Method:

Survey grade GPS \_\_\_\_\_: Post Processed Differential \_\_\_\_\_

Real-Time Differential \_\_\_\_\_

Mapping Grade GPS X: Post Processed Differential X

Real-Time Differential \_\_\_\_\_

4. Letter size copy of the topography map showing the well location.

I the undersigned, hereby certify this data is correct to the best of my knowledge and belief and shows all the information required by law and the regulations issued and prescribed by the Office of Oil and Gas.

Signature

PS 2002

Title

SEPTEMBER 26, 2023


Date

RECEIVED  
Office of Oil and Gas

APR 16 2024

06/07/2024

4706100646T

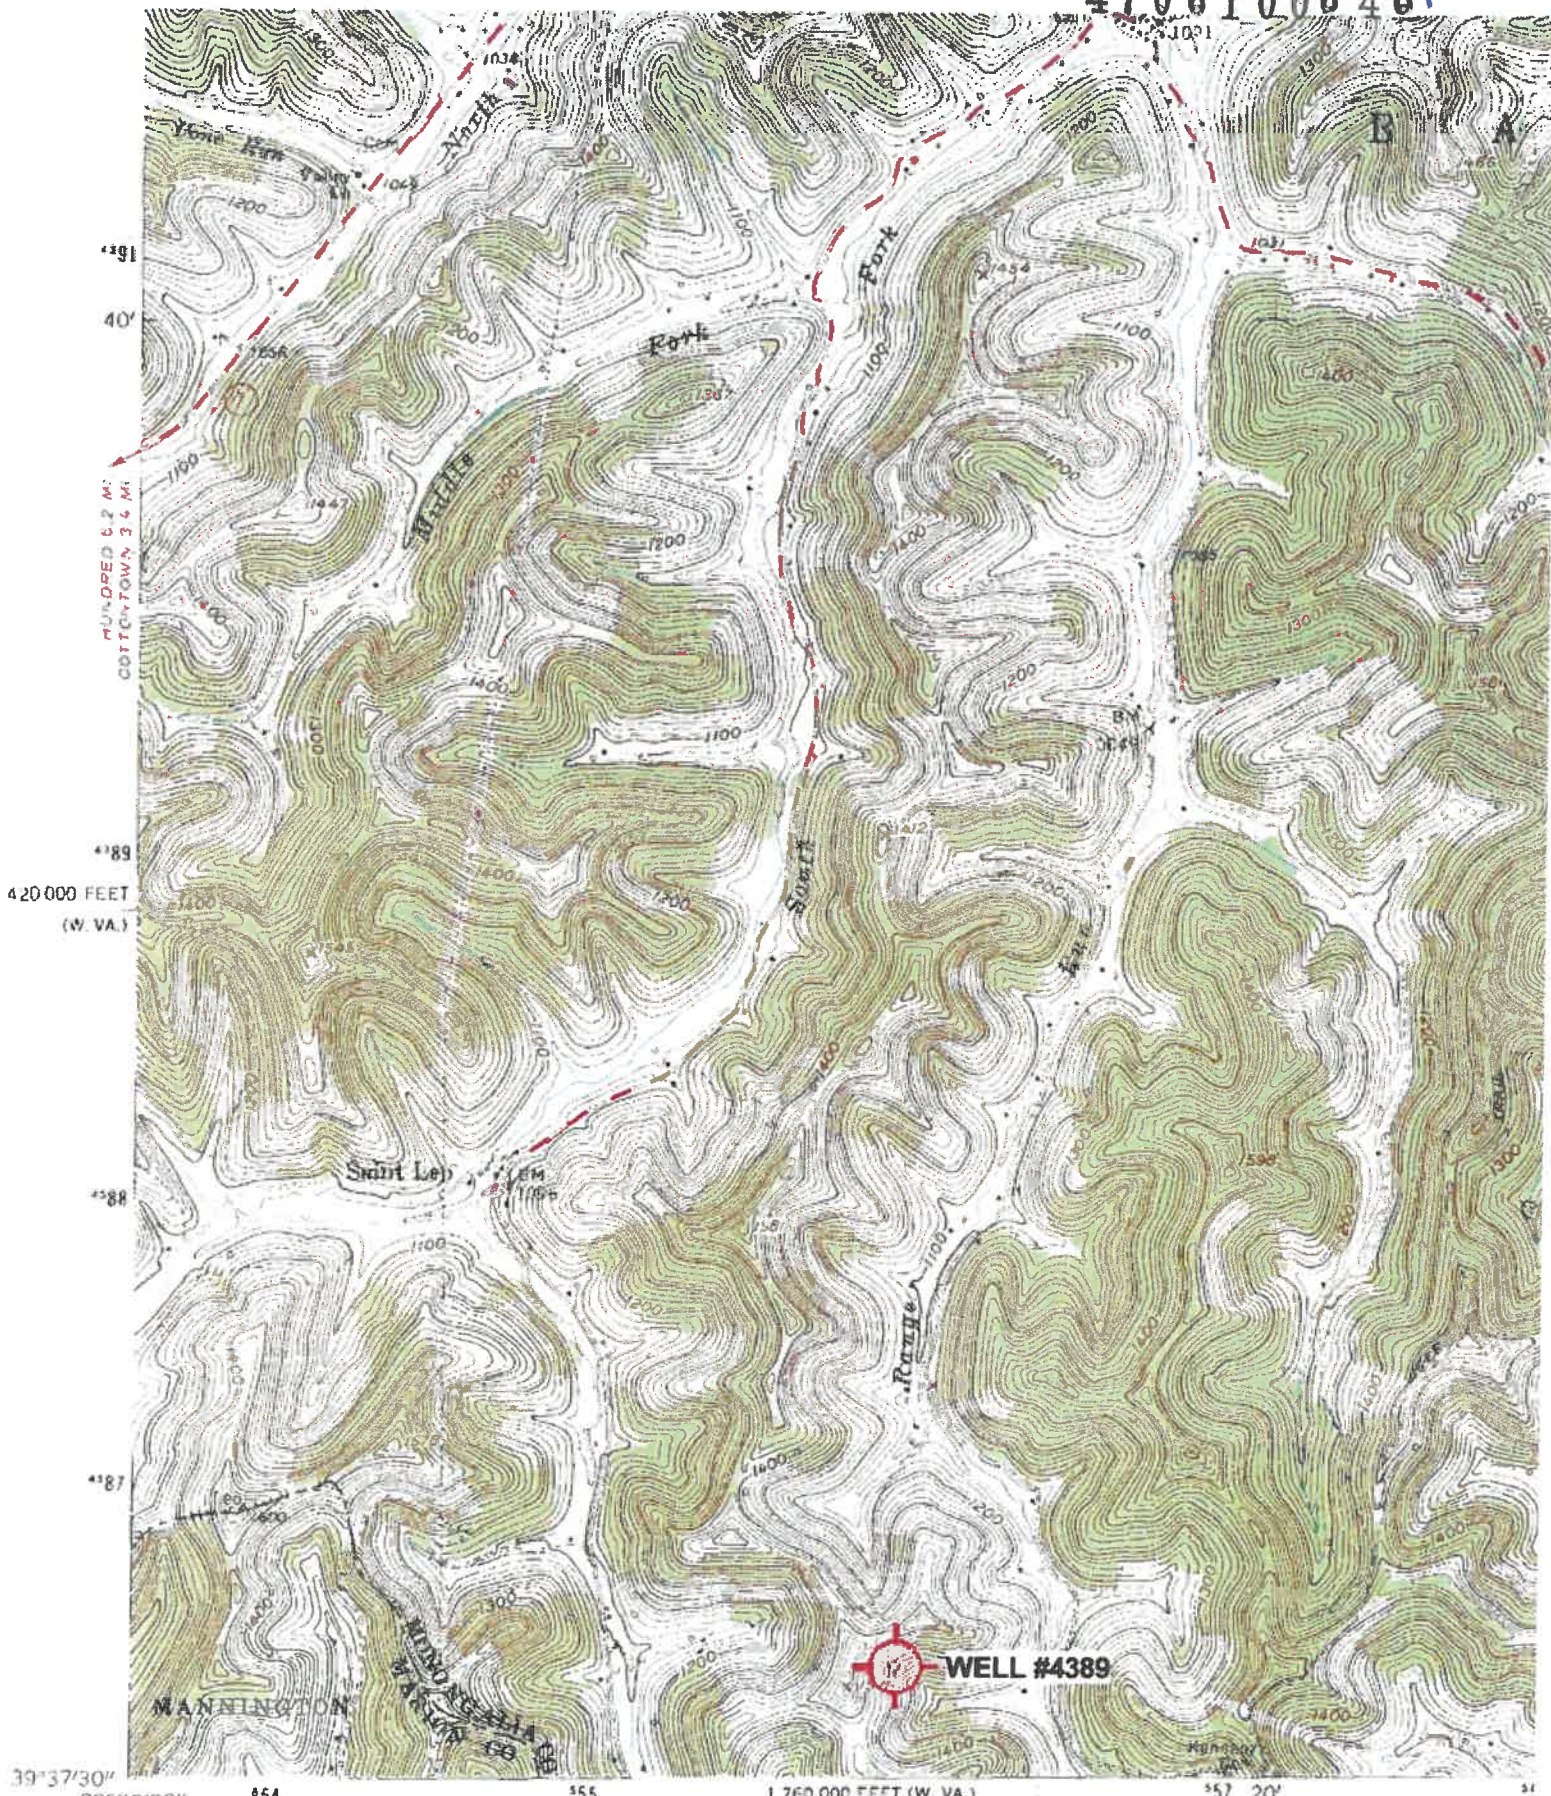


COTTONTOWN 3.4 MI.

(GLOVER GAP)  
4953 III SW

Mapped, edited, and published by the Geological Survey  
 Control by USGS and USC&GS

Topography from aerial photographs by photogrammetric methods  
 Aerial photographs taken 1956. Field check 1958

Polyconic projection. 1927 North American datum  
 10,000-foot grids based on West Virginia coordinate system,  
 north zone, and Pennsylvania coordinate system, south zone

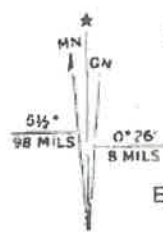

RECEIVED  
Office of Oil and Gas

APR 16 2024

WV Department of Environmental Protection  
06/07/2024