

WW-7
8-30-06



West Virginia Department of Environmental Protection
Office of Oil and Gas
WELL LOCATION FORM: GPS

API: 47-061-00992 WELL NO.: 9

FARM NAME: Barrackman

RESPONSIBLE PARTY NAME: NNE Resources LLC

COUNTY: Monongalia DISTRICT: Clay

QUADRANGLE: Blacksville 7.5'

SURFACE OWNER: Mark V. Eddy, Christopher Paul Eddy, Carol A. Tennant

ROYALTY OWNER: Trio Petroleum Corporation and Waco Oil and Gas Company, Inc., et al

UTM GPS NORTHING: 4389546.3

UTM GPS EASTING: 575003.1 GPS ELEVATION: 1382'

The Responsible Party named above has chosen to submit GPS coordinates in lieu of preparing a new well location plat for a plugging permit or assigned API number on the above well. The Office of Oil and Gas will not accept GPS coordinates that do not meet the following requirements:

- Datum: NAD 1983, Zone: 17 North, Coordinate Units: meters, Altitude: height above mean sea level (MSL) – meters.
- Accuracy to Datum – 3.05 meters
- Data Collection Method:

Survey grade GPS : Post Processed Differential
Real-Time Differential

Mapping Grade GPS : Post Processed Differential
Real-Time Differential

4. **Letter size copy of the topography map showing the well location.**


I the undersigned, hereby certify this data is correct to the best of my knowledge and belief and shows all the information required by law and the regulations issued and prescribed by the Office of Oil and Gas.

Signature

General Manager - Operations
Title

RECEIVED
Office of Oil and Gas
6/8/2016
JUN 10 2016
Date


BARRACKMAN 9
 UTM NAD 83:
 EASTING: 575003.1
 NORTHING: 4389546.3
 BLACKSVILLE 7.5' USGS QUAD
 GPS ELEVATION = 1382'

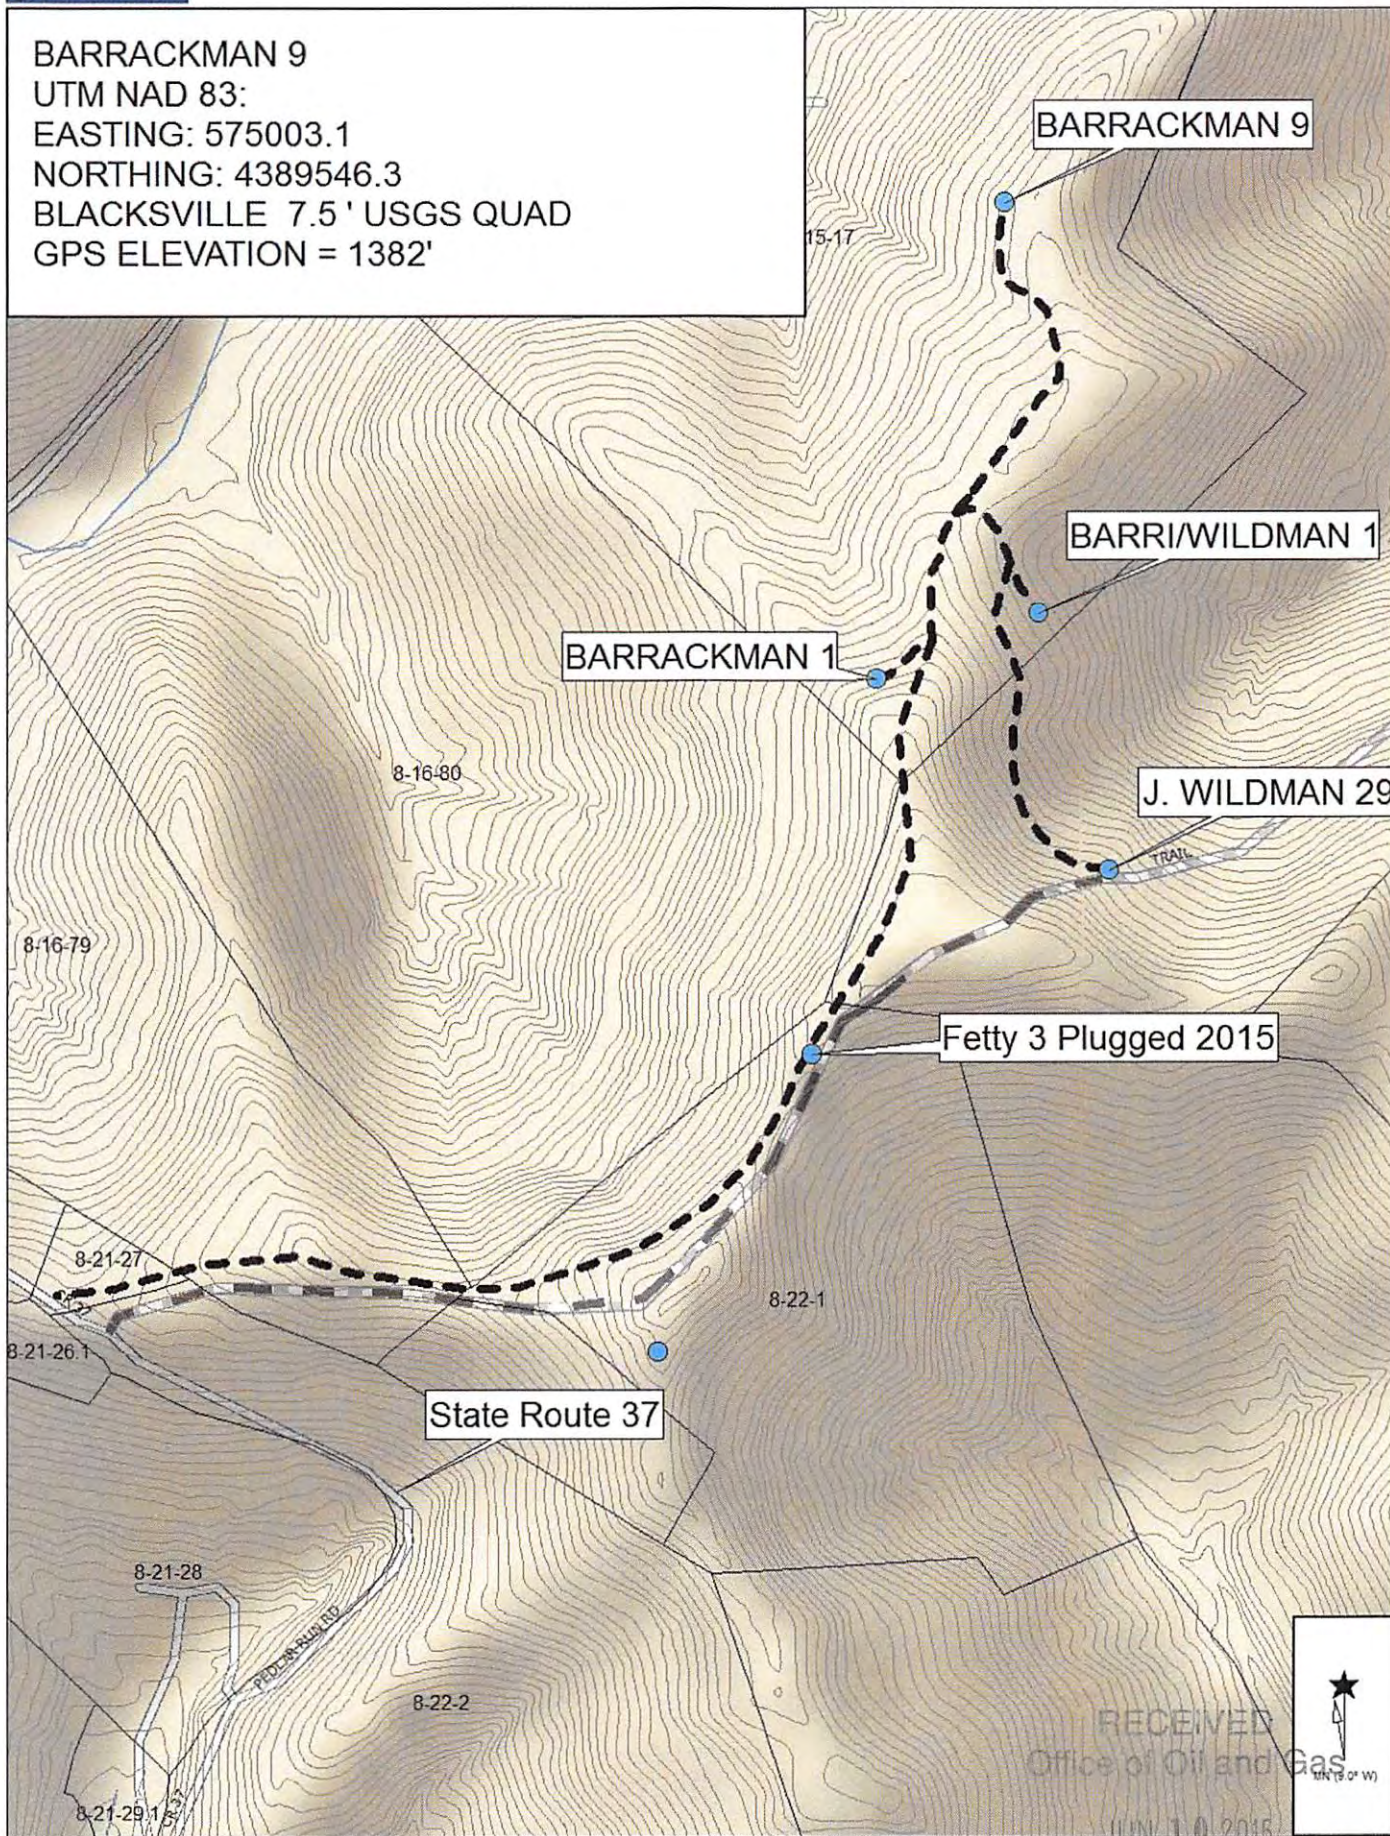

Data use subject to license.

© DeLorme. XMap® 7.

www.delorme.com

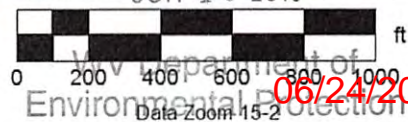

RECEIVED
 Office of Oil and Gas

JUN 10 2016

06/24/2016

Environmental Protection