

WW-7
8-30-06



West Virginia Department of Environmental Protection
Office of Oil and Gas
WELL LOCATION FORM: GPS

API: 4706101464 WELL NO.: L59

FARM NAME: Haines

RESPONSIBLE PARTY NAME: CNX Gas Company

COUNTY: Monongalia DISTRICT: Battelle

QUADRANGLE: Mannington

SURFACE OWNER: HAINES W HAROLD, SUSAN H, KENNETH A, TWYLA J; ET AL

ROYALTY OWNER: _____

UTM GPS NORTHING: 4385422.71

UTM GPS EASTING: 556171.29 GPS ELEVATION: 355.70 m / 1166.99 ft

The Responsible Party named above has chosen to submit GPS coordinates in lieu of preparing a new well location plat for a plugging permit or assigned API number on the above well. The Office of Oil and Gas will not accept GPS coordinates that do not meet the following requirements:

- Datum: NAD 1983, Zone: 17 North, Coordinate Units: meters, Altitude: height above mean sea level (MSL) – meters.
- Accuracy to Datum – 3.05 meters
- Data Collection Method:

Survey grade GPS _____: Post Processed Differential _____
Real-Time Differential _____

Mapping Grade GPS X: Post Processed Differential X
Real-Time Differential _____

4. **Letter size copy of the topography map showing the well location.**

I the undersigned, hereby certify this data is correct to the best of my knowledge and belief and shows all the information required by law and the regulations issued and prescribed by the Office of Oil and Gas.

Raymond [Signature]
Signature


PM
Title

1-6-2020
Date

RECEIVED
Office of Oil and Gas

JAN 08 2020


WV Department of
Environmental Protection

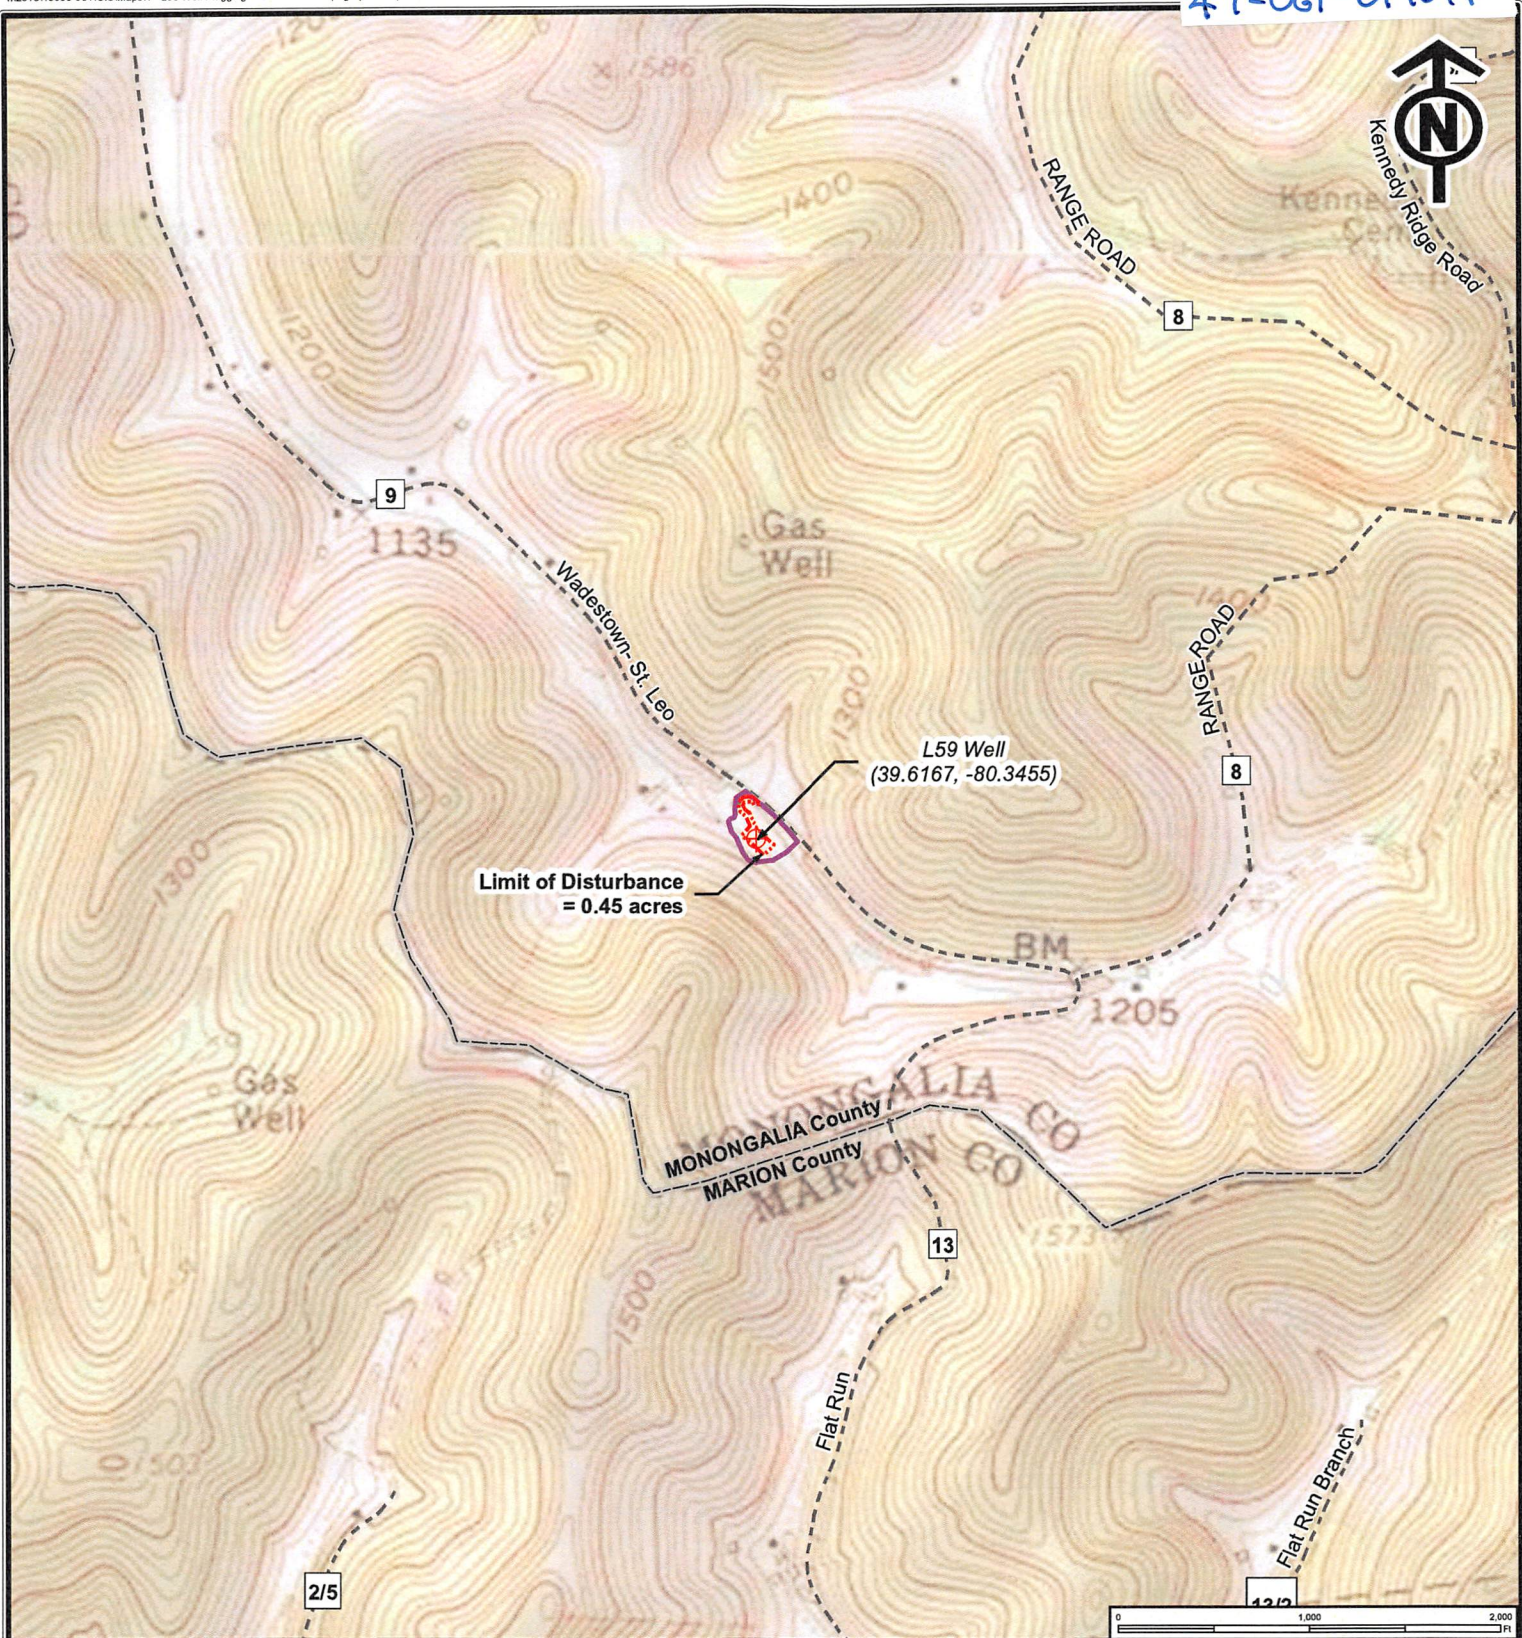

Limit of Disturbance
= 0.45 acres

L59 Well
(39.6167, -80.3455)

MONONGALIA CO
MARION CO

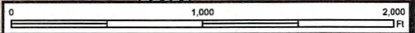

LEGEND

- Existing Well
- Limit of Disturbance
- Road
- Environmental Study
- County Boundary

Prepared By:
KEYSTONE CONSULTANTS INC
 www.keystoneconsultants.net 412-278-2100

REV	DESCRIPTION	DATE



**L59 Well Plugging
Site Location Topographic Map**

Monongalia County, WV

DRAWING NUMBER: 001

DWN BY: AMW APR BY: EAZ DATE: 12/30/19

SCALE: 1" = 1,000 feet SHEET: 1 OF 2