

6101706P

WW-7  
8-30-06



West Virginia Department of Environmental Protection  
Office of Oil and Gas  
**WELL LOCATION FORM: GPS**

API: 47-061- WELL NO.: 15

FARM NAME: W. R. Wile

RESPONSIBLE PARTY NAME: Consolidation Coal Company

COUNTY: Monongalia DISTRICT: Battelle

QUADRANGLE: Wadestown

SURFACE OWNER: Consolidation Coal Company

ROYALTY OWNER: \_\_\_\_\_

UTM GPS NORTHING: 4,396,588 m

UTM GPS EASTING: 559,601 m GPS ELEVATION: 393 m (1289')

The Responsible Party named above has chosen to submit GPS coordinates in lieu of preparing a new well location plat for a plugging permit or assigned API number on the above well. The Office of Oil and Gas will not accept GPS coordinates that do not meet the following requirements:

- Datum: NAD 1983, Zone: 17 North, Coordinate Units: meters, Altitude: height above mean sea level (MSL) – meters.
- Accuracy to Datum – 3.05 meters
- Data Collection Method:

Survey grade GPS \_\_\_\_\_: Post Processed Differential \_\_\_\_\_  
Real-Time Differential \_\_\_\_\_


Mapping Grade GPS X: Post Processed Differential X  
Real-Time Differential \_\_\_\_\_

RECEIVED  
Office of Oil and Gas  
JAN 01 2015

WV Department of  
Environmental Protection

4. Letter size copy of the topography map showing the well location.

I the undersigned, hereby certify this data is correct to the best of my knowledge and belief and shows all the information required by law and the regulations issued and prescribed by the Office of Oil and Gas.

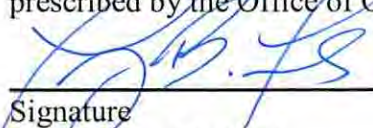

Signature

Professional Surveyor  
Title

December 26, 2014

Date

STATE OF WEST VIRGINIA GEOLOGICAL SURVEY  
AND OTHER STATE AGENCIES

6101706 P

°57 20'


°58

4963 IV SE  
(HOLBROOK) PINE BANK 0.9 MI.

°60

17'30"

°61

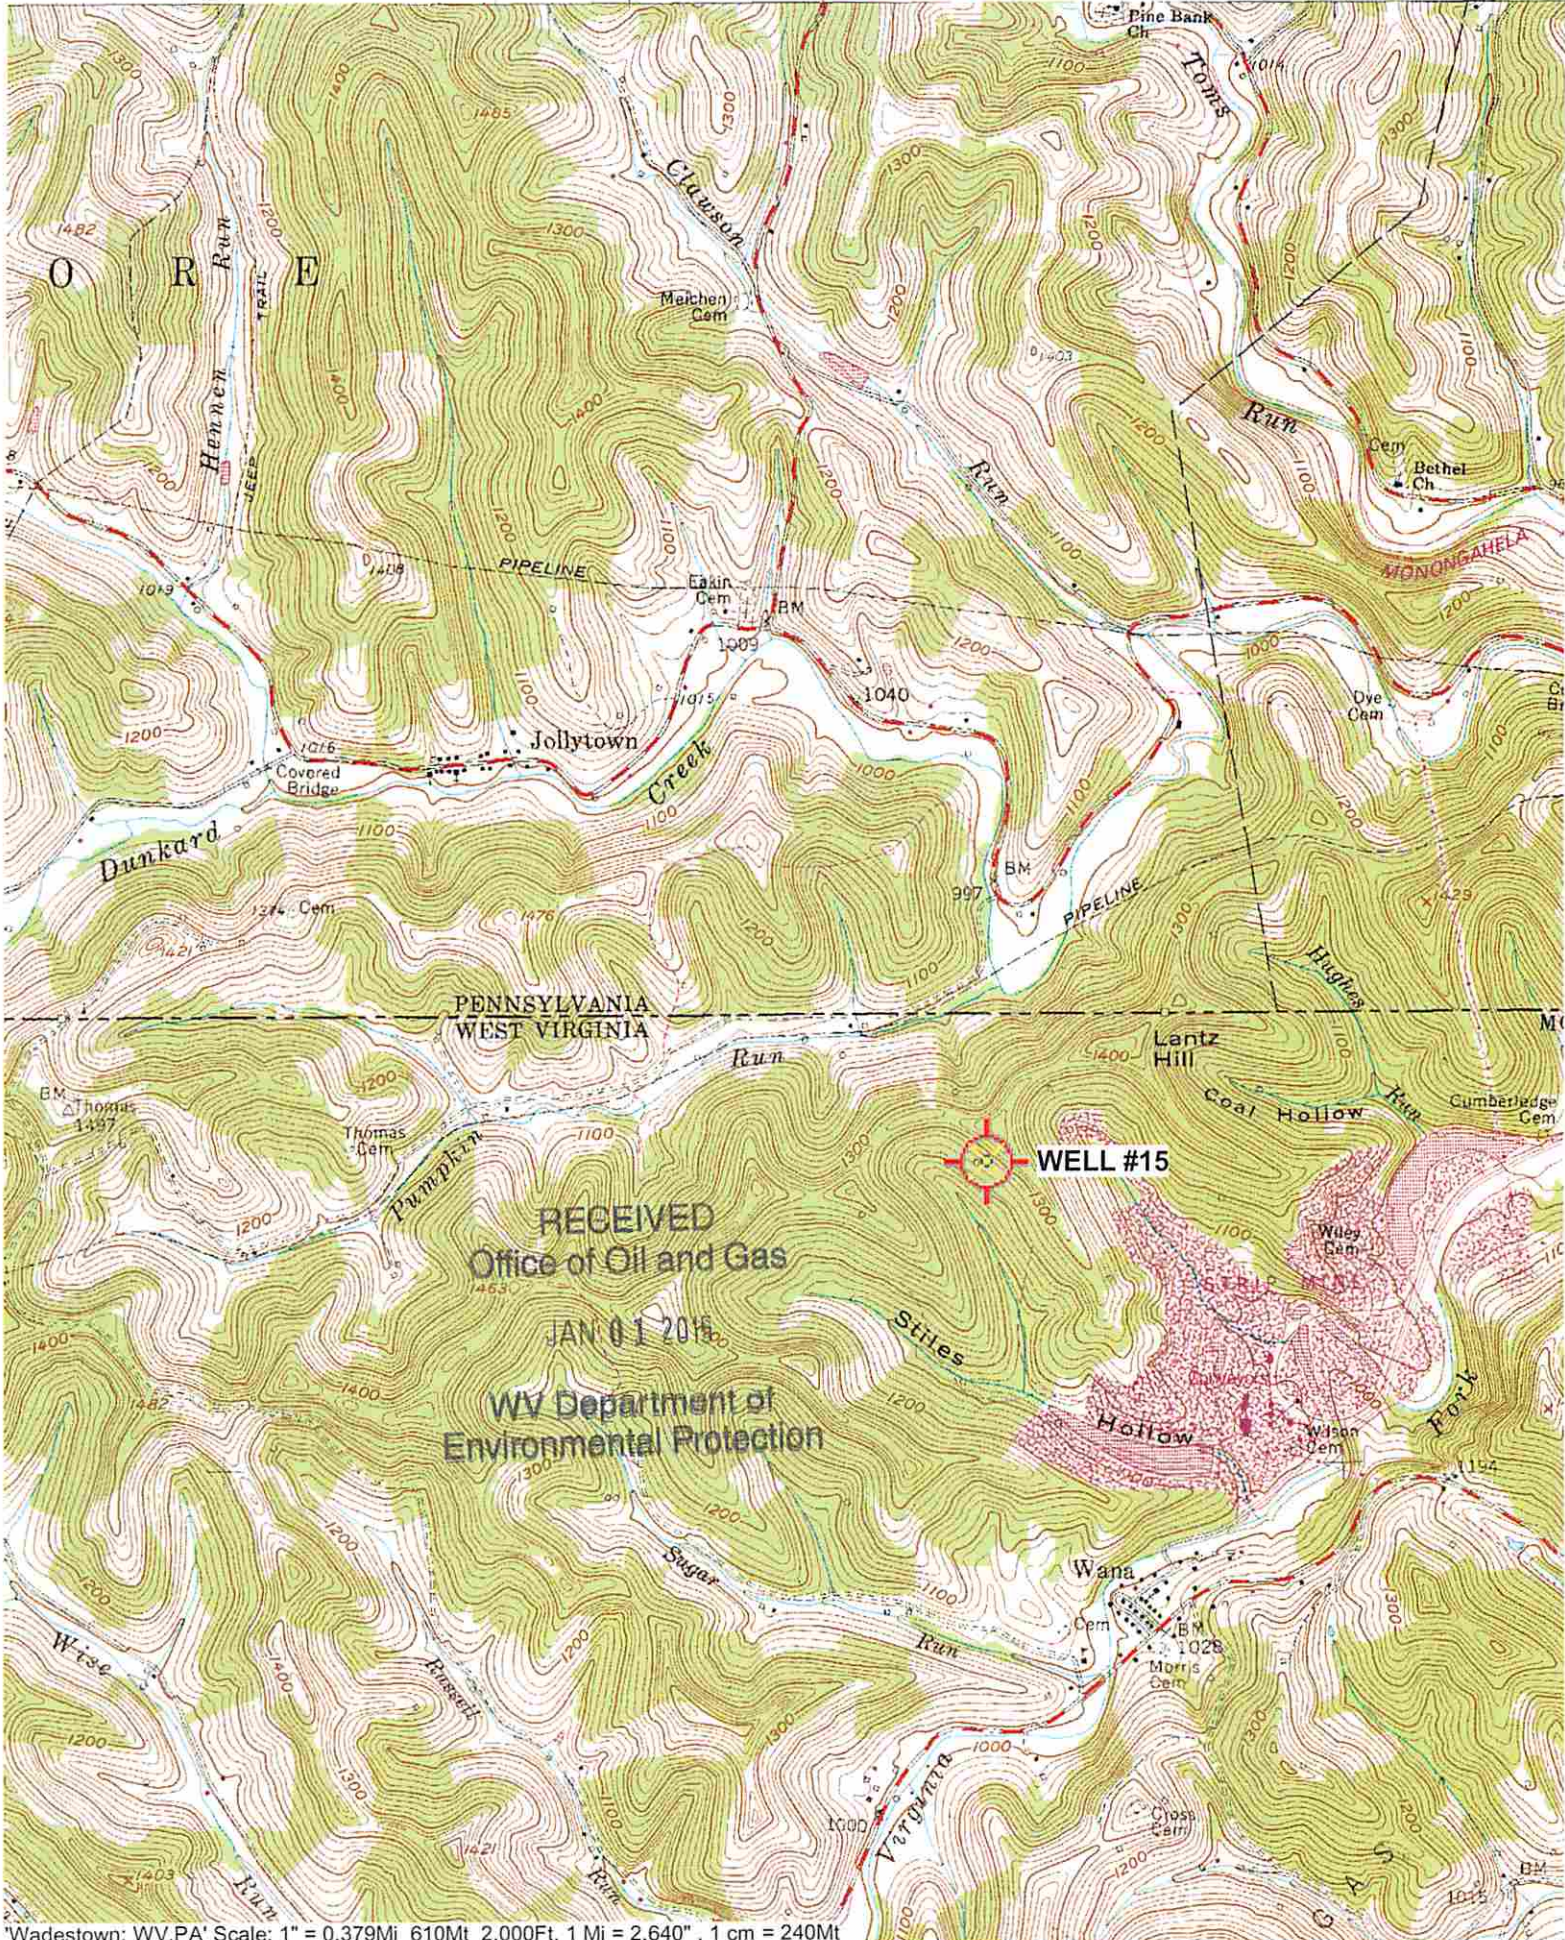

RECEIVED  
Office of Oil and Gas

JAN 01 2016

WV Department of  
Environmental Protection