

FILE #: NNE15

DRAWING #: 2606

SCALE: PLAT: 1" = 1200'
TICK: 1" = 2000'


MINIMUM DEGREE OF ACCURACY: 1/200

PROVEN SOURCE OF ELEVATION: SUBMETER MAPPING GRADE GPS

I, THE UNDERSIGNED, HEREBY CERTIFY THAT THIS PLAT IS CORRECT TO THE BEST OF MY KNOWLEDGE AND BELIEF AND SHOWS ALL THE INFORMATION REQUIRED BY LAW AND THE REGULATIONS ISSUED AND PRESCRIBED BY THE DEPARTMENT OF ENVIRONMENTAL PROTECTION.

Signed: [Signature]

L.L.S. #2124 : Ernest J. Benchek III

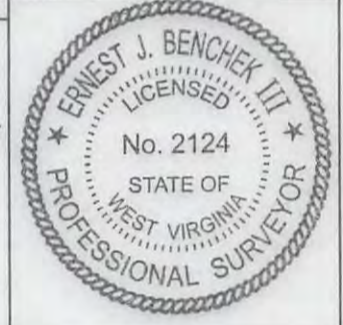

(+) DENOTES LOCATION OF WELL ON UNITED STATES TOPOGRAPHIC MAPS WYDEP

OFFICE OF OIL & GAS
601 57TH STREET
CHARLESTON, WV 25304

Well Type: Oil Waste Diposal Production Deep
 Gas Liquid Injection Storage Shallow

WATERSHED: DUNKARD CREEK AS-BUILT ELEVATION: 1,534'

COUNTY/DISTRICT: MONONGALIA / CLAY QUADRANGLE: BLACKSVILLE

SURFACE OWNER: NEHEMIAH KASSAY ACREAGE: 86.78 +/-

OIL & GAS ROYALTY OWNER: NEHEMIAH & PATTY A. KASSAY ACREAGE: 410.626 +/-

LEASE NUMBERS: _____

DATE: NOVEMBER 4, 2016

OPERATOR'S WELL #: KASSAY NO. 8H

API WELL #: 47 61 01740 HLA
STATE COUNTY PERMIT MOD

DRILL CONVERT DRILL DEEPER REDRILL FRACTURE OR STIMULATE
PLUG OFF FORMATION PERFORATE NEW FORMATION PLUG & ABANDON
CLEAN OUT & REPLUG OTHER CHANGE (SPECIFY): _____


TARGET FORMATION: MARCELLUS ESTIMATED DEPTH: TVD: 8,288.5' TMD: 16,405.87'

WELL OPERATOR: NORTHEAST NATURAL ENERGY LLC DESIGNATED AGENT: JOHN ADAMS

ADDRESS: 707 VIRGINIA STREET EAST, SUITE 1200 ADDRESS: 707 VIRGINIA STREET EAST, SUITE 1200

CITY: CHARLESTON STATE: WV ZIP CODE: 25301 CITY: CHARLESTON STATE: WV ZIP CODE: 25301

WELL NAME KASSAY No. 8H
QUAD BLACKSVILLE, WV

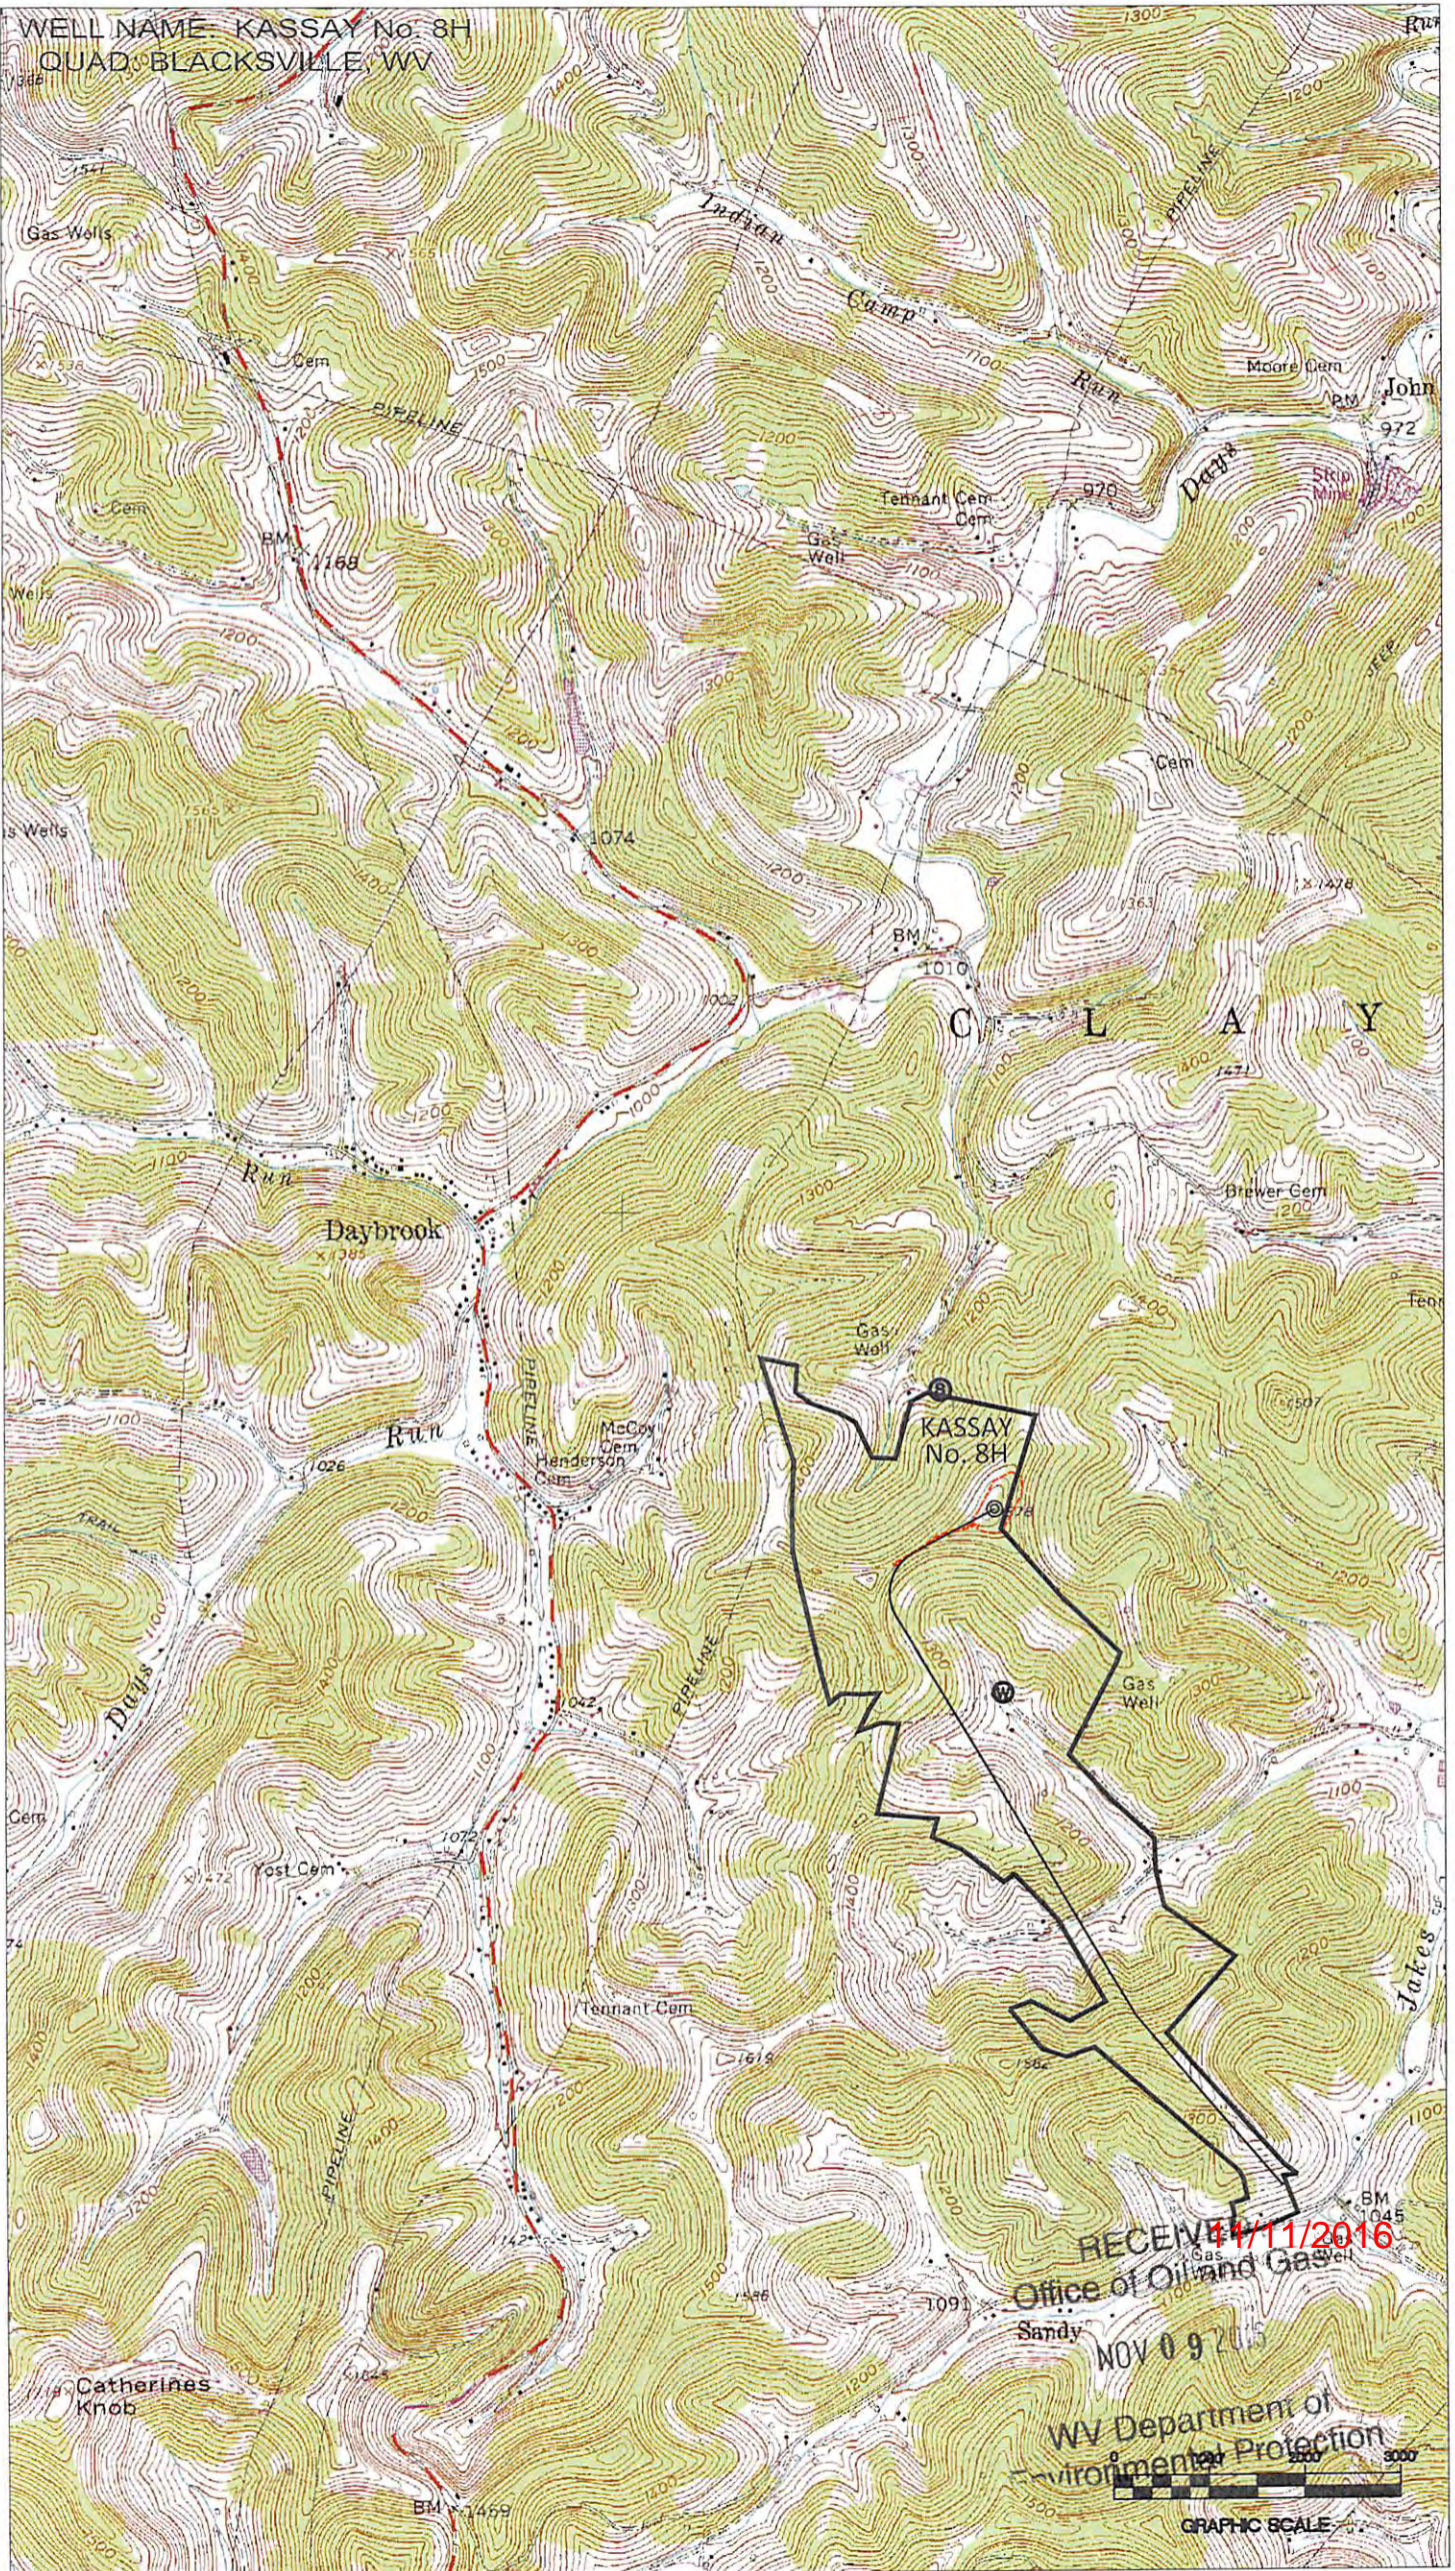

RECEIVED 11/11/2016
Office of Oil and Gas

Sandy NOV 09 2015

WV Department of Environmental Protection



GRAPHIC SCALE