



West Virginia Department of Environmental Protection
Office of Oil and Gas

WELL LOCATION FORM: GPS

API: 47-061-01750
Assigned Permit Number WELL NO.: Cordray 4

FARM NAME: Cordray

RESPONSIBLE PARTY NAME: NNE Resources LLC

COUNTY: Monongalia DISTRICT: Clay

QUADRANGLE: Blacksville

SURFACE OWNER: Mark and Betty Eddy

ROYALTY OWNER: Jack Cordray et al

UTM GPS NORTHING: 4388692.726

UTM GPS EASTING: 573891.26 GPS ELEVATION: 1380'

The Responsible Party named above has chosen to submit GPS coordinates in lieu of preparing a new well location plat for a plugging permit or assigned API number on the above well. The Office of Oil and Gas will not accept GPS coordinates that do not meet the following requirements:

1. Datum: NAD 1983, Zone: 17 North, Coordinate Units: meters, Altitude: height above mean sea level (MSL) – meters.
2. Accuracy to Datum – 3.05 meters
3. Data Collection Method:

Survey grade GPS ___ : Post Processed Differential ___

Real-Time Differential ___

Mapping Grade GPS X : Post Processed Differential ___

Real-Time Differential X

4. Letter size copy of the topography map showing the well location.

I the undersigned, hereby certify this data is correct to the best of my knowledge and belief and shows all the information required by law and the regulations issued and prescribed by the Office of Oil and Gas.

Hellmeyer
Signature

Regulatory Coordinator
Title


4/15/16
Date




Data use subject to license.

© DeLorme. XMap® 7.

www.delorme.com

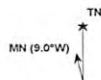

Scale 1 : 20,800

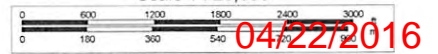

1" = 1,733.3 ft

Data Zoom 13-3