

WW-7  
8-30-06



West Virginia Department of Environmental Protection  
Office of Oil and Gas

**WELL LOCATION FORM: GPS**

API: 47-061-01796 WELL NO.: 6H

FARM NAME: Kassay

RESPONSIBLE PARTY NAME: Northeast Natural Energy LLC

COUNTY: Monongalia DISTRICT: Clay

QUADRANGLE: Blacksville, WV

SURFACE OWNER: Patty A. Kassay

ROYALTY OWNER: Patty A. Kassay, et al

UTM GPS NORTHING: 4390167.9

UTM GPS EASTING: 569109.5 GPS ELEVATION: 1,534'

The Responsible Party named above has chosen to submit GPS coordinates in lieu of preparing a new well location plat for a plugging permit or assigned API number on the above well. The Office of Oil and Gas will not accept GPS coordinates that do not meet the following requirements:

1. Datum: NAD 1983, Zone: 17 North, Coordinate Units: meters, Altitude: height above mean sea level (MSL) – meters.
2. Accuracy to Datum – 3.05 meters
3. Data Collection Method:

Survey grade GPS  : Post Processed Differential \_\_\_\_\_  
Real-Time Differential

Mapping Grade GPS \_\_\_\_\_ : Post Processed Differential \_\_\_\_\_  
Real-Time Differential \_\_\_\_\_

4. **Letter size copy of the topography map showing the well location.**

I the undersigned, hereby certify this data is correct to the best of my knowledge and belief and shows all the information required by law and the regulations issued and prescribed by the Office of Oil and Gas.

Hollimmedy  
Signature

Regulatory Manager  
Title

1-23-19  
Date

RECEIVED  
Office of Oil and Gas  
FEB - 5 2019  
WV Department of  
Environmental Protection



# Northeast Natural Resources LLC.

Proposed Plugging of  
KASSAY 6H (061-01796)  
Clay District  
Monongalia County, WV

TOP HOLE (NAD 83)  
N) 422723.8  
E) 1773009.4  
LAT.) 39°39'30.7"  
LONG.) 80°11'39.8"  
DEC. LAT.) 39.658524  
DEC. LONG.) 80.194378

TOP HOLE (NAD 27)  
N) 422686.8  
E) 1804446.4  
LAT.) 39°39'30.4"  
LONG.) 80°11'40.5"  
DEC. LAT.) 39.658443  
DEC. LONG.) 80.194581

TOP HOLE (UTM NAD 83)  
N) 4390167.9  
E) 569109.5




Gas Well

PATTY A, KASSAY  
86.78 ACRES  
LEASE NUMBER  
WV-061-003302-002  
TAX MAP & PARCEL  
31-04-0017-0048-0000

PRECISION OIL & GAS INC  
32.03 ACRES  
LEASE NUMBER  
WV-061-003542-001  
TAX MAP & PARCEL  
31-04-0017-0062-0000

KASSAY 6H

BOORD, BENCHEK and ASSOC., INC.  
Engineering, Surveying, Construction,  
and Mining Services  
Southpointe, PA 15317 Phone: 724-746-1055

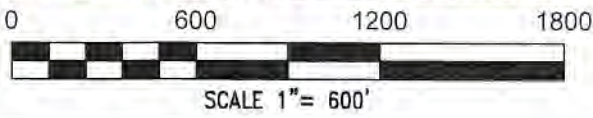

FEB 5 2019  
JANUARY 23, 2019  
WV Department of Environmental Protection