

WW-7
8-30-06



West Virginia Department of Environmental Protection
Office of Oil and Gas

WELL LOCATION FORM: GPS

API: 47-061-01797 WELL NO.: 10H

FARM NAME: Kassay

RESPONSIBLE PARTY NAME: Northeast Natural Energy LLC

COUNTY: Monongalia DISTRICT: Clay

QUADRANGLE: Blacksville, WV

SURFACE OWNER: Patty A. Kassay

ROYALTY OWNER: Patty A. Kassay, et al

UTM GPS NORTHING: 4390167.9

UTM GPS EASTING: 569109.5 GPS ELEVATION: 1,534'

The Responsible Party named above has chosen to submit GPS coordinates in lieu of preparing a new well location plat for a plugging permit or assigned API number on the above well. The Office of Oil and Gas will not accept GPS coordinates that do not meet the following requirements:

1. Datum: NAD 1983, Zone: 17 North, Coordinate Units: meters, Altitude: height above mean sea level (MSL) – meters.
2. Accuracy to Datum – 3.05 meters
3. Data Collection Method:

Survey grade GPS : Post Processed Differential _____
Real-Time Differential

Mapping Grade GPS _____ : Post Processed Differential _____
Real-Time Differential _____

4. **Letter size copy of the topography map showing the well location.**

I the undersigned, hereby certify this data is correct to the best of my knowledge and belief and shows all the information required by law and the regulations issued and prescribed by the Office of Oil and Gas.

Holl: m medy
Signature

Regulatory Manager
Title

1-23-19
Date

RECEIVED
Office of Oil and Gas

FEB -5 2019

WV Department of
Environmental Protection

Northeast Natural Resources LLC.

Proposed Plugging of
KASSAY 10H (061-01797)
Clay District
Monongalia County, WV

TOP HOLE (NAD 83)
N) 422759.2
E) 1773027.9
LAT.) 39°39'31.0"
LONG.) 80°11'39.5"
DEC. LAT.) 39.658621
DEC. LONG.) 80.194311

TOP HOLE (NAD 27)
N) 422722.2
E) 1804465.0
LAT.) 39°39'30.7"
LONG.) 80°11'40.3"
DEC. LAT.) 39.658541
DEC. LONG.) 80.194516

TOP HOLE (UTM NAD 83)
N) 4390178.8
E) 569115.0




PATTY A. KASSAY
86.78 ACRES
LEASE NUMBER
WV-061-003302-002
TAX MAP & PARCEL
31-04-0017-0048-0000

PRECISION OIL & GAS INC
32.03 ACRES
LEASE NUMBER
WV-061-003542-001
TAX MAP & PARCEL
31-04-0017-0062-0000

KASSAY 10H

BOORD, BENCHEK and ASSOC., INC.
Engineering, Surveying, Construction,
and Mining Services
Southpointe, PA 15317 Phone: 724-746-1055

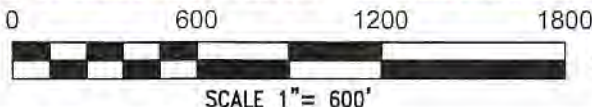

RECEIVED
of Oil and Gas
JANUARY 23, 2019
FEB - 5 2019

WV Department of
Environmental Protection