



# CNX WDTN19EHSM Surveys 0ft to 23054ft MD Survey Geodetic Report

(Def Survey)

Report Date: February 21, 2023 - 02:39 PM  
 Client: CNX  
 Field: WV Monongalia County (NAD 27)  
 Structure / Slot: CNX WDTN19 Pad / WDTN19EHSM  
 Well: WDTN19EHSM  
 Borehole: Original Borehole  
 UWI / API#: Unknown / Unknown  
 Survey Name: CNX WDTN19EHSM Surveys 0ft to 23054ft MD  
 Survey Date: December 02, 2022  
 Tort / AHD / DDI / ERD Ratio: 321.099' / 16179.573 ft / 7.175 / 2.020  
 Coordinate Reference System: NAD27 West Virginia State Plane, Northern Zone, US Feet  
 Location Lat / Long: N 39° 41' 36.11824", W 80° 20' 7.70710"  
 Location Grid N/E Y/X: N 435744.198 RUS, E 1764898.448 RUS  
 CRS Grid Convergence Angle: -0.5328"  
 Grid Scale Factor: 0.99994143  
 Version / Patch: 2.10.834.0

Survey / DLS Computation: Minimum Curvature / Lubinski  
 Vertical Section Azimuth: 145.000 ° (Grid North)  
 Vertical Section Origin: 0.000 ft, 0.000 ft  
 TVD Reference Datum: KB  
 TVD Reference Elevation: 1293.000 ft above MSL  
 Seabed / Ground Elevation: 1264.000 ft above MSL  
 Magnetic Declination: -8.913 °  
 Total Gravity Field Strength: 999.3417mgal (9.80665 Based)  
 Gravity Model: GARM  
 Total Magnetic Field Strength: 51783.096 nT  
 Magnetic Dip Angle: 66.370 °  
 Declination Date: December 02, 2022  
 Magnetic Declination Model: HDGM 2022  
 North Reference: Grid North  
 Grid Convergence Used: -0.5328"  
 Total Corr Mag North->Grid North: -8.3804"  
 Local Coord Referenced To: Well Head

Comments	MD (ft)	Incl (°)	Azim Grid (°)	TVD (ft)	TVDSS (ft)	VSEC (ft)	NS (ft)	EW (ft)	DLS ("/100ft)	BR ("/100ft)	TR ("/100ft)	Northing (RUS)	Easting (RUS)	Latitude (°)	Longitude (°)
Surface	0.00	0.00	0.00	0.00	-1293.00	0.00	0.00	0.00	N/A	N/A	N/A	435744.20	1764898.45	39.69336618	-80.33547419
	100.00	0.72	253.17	100.00	-1193.00	-0.20	-0.18	-0.60	0.72	0.00	0.00	435744.02	1764897.85	39.69336566	-80.33547633
	125.00	0.25	247.69	125.00	-1168.00	-0.26	-0.25	-0.80	1.89	-1.88	-21.92	435743.95	1764897.65	39.69336548	-80.33547704
	150.00	0.16	212.95	150.00	-1143.00	-0.26	-0.30	-0.87	0.60	-0.36	-138.96	435743.90	1764897.58	39.69336534	-80.33547728
	175.00	0.21	184.51	175.00	-1118.00	-0.21	-0.37	-0.89	0.41	0.20	-113.76	435743.82	1764897.55	39.69336513	-80.33547736
	200.00	0.24	192.02	200.00	-1093.00	-0.14	-0.47	-0.91	0.17	0.12	30.04	435743.73	1764897.54	39.69336486	-80.33547741
	225.00	0.23	204.37	225.00	-1068.00	-0.08	-0.57	-0.94	0.21	-0.04	49.40	435743.63	1764897.51	39.69336460	-80.33547752
	250.00	0.21	210.19	250.00	-1043.00	-0.03	-0.65	-0.98	0.12	-0.08	23.28	435743.55	1764897.46	39.69336436	-80.33547767
	275.00	0.25	228.05	275.00	-1018.00	-0.01	-0.73	-1.05	0.34	0.16	75.44	435743.47	1764897.40	39.69336415	-80.33547790
	300.00	0.25	223.43	300.00	-993.00	0.01	-0.80	-1.13	0.10	0.00	-22.48	435743.40	1764897.32	39.69336394	-80.33547817
	325.00	0.28	206.43	324.99	-968.01	0.05	-0.90	-1.19	0.34	0.12	-68.00	435743.30	1764897.26	39.69336368	-80.33547840
	350.00	0.27	197.99	349.99	-943.01	0.12	-1.01	-1.24	0.17	-0.04	-33.76	435743.19	1764897.21	39.69336338	-80.33547866
	375.00	0.22	195.05	374.99	-918.01	0.18	-1.11	-1.27	0.21	-0.20	-11.76	435743.09	1764897.18	39.69336310	-80.33547886
	400.00	0.31	190.56	399.99	-893.01	0.26	-1.22	-1.29	0.37	0.36	-17.96	435742.97	1764897.16	39.69336279	-80.33547875
	425.00	0.44	212.48	424.99	-868.01	0.34	-1.37	-1.36	0.77	0.52	87.68	435742.83	1764897.09	39.69336238	-80.33547897
	450.00	0.57	228.76	449.99	-843.01	0.39	-1.53	-1.50	0.77	0.52	65.12	435742.66	1764896.95	39.69336193	-80.33547948
	475.00	0.65	241.72	474.99	-818.01	0.39	-1.68	-1.72	0.64	0.32	51.84	435742.52	1764896.73	39.69336151	-80.33548025
	500.00	0.60	240.78	499.99	-793.01	0.36	-1.81	-1.96	0.20	-0.20	-3.76	435742.38	1764896.49	39.69336115	-80.33548110
	525.00	0.39	219.67	524.99	-768.01	0.37	-1.94	-2.13	1.10	-0.84	-84.44	435742.25	1764896.32	39.69336079	-80.33548169
	550.00	0.39	189.59	549.99	-743.01	0.45	-2.09	-2.20	0.81	0.00	-120.32	435742.11	1764896.25	39.69336038	-80.33548193
	575.00	0.41	172.87	574.99	-718.01	0.59	-2.27	-2.20	0.47	0.08	-66.88	435741.93	1764896.25	39.69335990	-80.33548193
	600.00	0.43	181.96	599.99	-693.01	0.75	-2.45	-2.19	0.28	0.08	36.36	435741.75	1764896.26	39.69335940	-80.33548190
	625.00	0.50	181.89	624.99	-668.01	0.91	-2.65	-2.20	0.28	0.28	-0.28	435741.55	1764896.25	39.69335884	-80.33548192
	650.00	0.58	178.57	649.98	-643.02	1.10	-2.89	-2.20	0.34	0.32	-13.28	435741.31	1764896.25	39.69335820	-80.33548195
	675.00	0.60	187.09	674.98	-618.02	1.31	-3.14	-2.21	0.36	0.08	34.08	435741.06	1764896.24	39.69335749	-80.33548195
	700.00	0.68	188.84	699.98	-593.02	1.51	-3.42	-2.25	0.33	0.32	7.00	435740.78	1764896.20	39.69335673	-80.33548208
	725.00	0.82	194.99	724.98	-568.02	1.73	-3.74	-2.32	0.65	0.56	24.60	435740.46	1764896.13	39.69335586	-80.33548231
	750.00	0.68	188.24	749.98	-543.02	1.95	-4.06	-2.39	0.66	-0.56	-27.00	435740.14	1764896.06	39.69335498	-80.33548254
	775.00	0.67	181.68	774.98	-518.02	2.18	-4.35	-2.41	0.31	-0.04	-26.24	435739.85	1764896.04	39.69335417	-80.33548262
	800.00	0.71	188.47	799.97	-493.03	2.41	-4.65	-2.44	0.36	0.16	27.16	435739.55	1764896.01	39.69335335	-80.33548271
	825.00	0.67	194.06	824.97	-468.03	2.62	-4.95	-2.50	0.31	-0.16	22.36	435739.25	1764895.95	39.69335254	-80.33548291
	850.00	0.59	198.45	849.97	-443.03	2.79	-5.21	-2.57	0.37	-0.32	17.56	435738.99	1764895.87	39.69335181	-80.33548317
	875.00	0.53	205.50	874.97	-418.03	2.92	-5.44	-2.66	0.37	-0.24	28.20	435738.76	1764895.78	39.69335119	-80.33548348
	900.00	0.47	200.00	899.97	-393.03	3.04	-5.64	-2.75	0.31	-0.24	-22.00	435738.56	1764895.70	39.69335063	-80.33548378
	925.00	0.50	180.59	924.97	-368.03	3.19	-5.84	-2.79	0.66	0.12	-77.64	435738.36	1764895.66	39.69335007	-80.33548390
	950.00	0.48	183.63	949.97	-343.03	3.36	-6.06	-2.79	0.13	-0.08	12.16	435738.14	1764895.65	39.69334948	-80.33548392
	975.00	0.47	184.57	974.97	-318.03	3.52	-6.26	-2.81	0.05	-0.04	3.76	435737.94	1764895.64	39.69334892	-80.33548397
	1000.00	0.57	179.55	999.97	-293.03	3.70	-6.49	-2.82	0.44	0.40	-20.08	435737.71	1764895.63	39.69334829	-80.33548399
	1025.00	0.62	182.67	1024.96	-268.04	3.91	-6.75	-2.82	0.24	0.20	12.48	435737.45	1764895.63	39.69334758	-80.33548400
	1050.00	0.55	176.21	1049.96	-243.04	4.12	-7.00	-2.82	0.38	-0.28	-25.84	435737.20	1764895.63	39.69334688	-80.33548398
	1075.00	0.44	180.45	1074.96	-218.04	4.30	-7.22	-2.81	0.46	-0.44	16.96	435736.98	1764895.64	39.69334629	-80.33548395
	1100.00	0.40	185.62	1099.96	-193.04	4.44	-7.40	-2.82	0.22	-0.16	20.68	435736.80	1764895.63	39.69334579	-80.33548398

...CNX WDTN19 Pad\WDTN19EHSM\Original Borehole\CNX WDTN19EHSM Surveys 0ft to 23054ft MD

Comments	MD (ft)	Incl (°)	Azim Grid (°)	TVD (ft)	TVDSS (ft)	VSEC (ft)	NS (ft)	EW (ft)	DLS (*100ft)	BR (*100ft)	TR (*100ft)	Northing (ftUS)	Easting (ftUS)	Latitude (°)	Longitude (°)
Final Gyro	1125.00	0.46	185.10	1124.96	-168.04	4.59	-7.59	-2.84	0.24	0.24	-2.08	435736.61	1764895.61	39.69334527	-80.33548403
	1150.00	0.42	182.58	1149.96	-143.04	4.74	-7.78	-2.85	0.18	-0.16	-10.08	435736.42	1764895.60	39.69334475	-80.33548407
	1155.00	0.35	157.05	1154.96	-138.04	4.77	-7.81	-2.85	3.67	-1.40	-510.60	435736.39	1764895.60	39.69334466	-80.33548405
	1267.00	0.39	186.24	1266.96	-26.04	5.39	-8.51	-2.75	0.17	0.04	26.06	435735.69	1764895.69	39.69334276	-80.33548370
	1361.00	0.34	215.06	1360.96	67.96	5.72	-9.05	-2.95	0.20	-0.05	30.66	435735.15	1764895.50	39.69334125	-80.33548438
	1455.00	0.24	247.02	1454.95	161.95	5.78	-9.36	-3.29	0.20	-0.11	34.00	435734.84	1764895.16	39.69334041	-80.33548558
	1548.00	0.08	30.69	1547.95	254.95	5.71	-9.38	-3.44	0.33	-0.17	154.48	435734.82	1764895.01	39.69334035	-80.33548610
	1642.00	0.50	52.74	1641.95	348.95	5.67	-9.07	-3.08	0.45	0.45	23.46	435735.13	1764895.37	39.69334119	-80.33548483
	1736.00	0.84	35.67	1735.95	442.95	5.42	-8.26	-2.35	0.42	0.36	-18.16	435735.93	1764896.10	39.69334343	-80.33548227
	1831.00	1.12	41.19	1830.93	537.93	4.97	-7.00	-1.33	0.31	0.29	5.81	435737.20	1764897.12	39.69334693	-80.33547870
	1926.00	0.76	18.35	1925.92	632.92	4.37	-5.70	-0.52	0.54	-0.38	-24.04	435738.49	1764897.93	39.69335051	-80.33547586
	2020.00	0.41	344.77	2019.91	726.91	3.68	-4.79	-0.41	0.51	-0.37	-35.72	435739.41	1764898.03	39.69335302	-80.33547551
	2115.00	0.44	356.95	2114.91	821.91	3.05	-4.10	-0.52	0.10	0.03	12.82	435740.10	1764897.93	39.69335492	-80.33547592
	2210.00	0.99	3.37	2209.90	916.90	2.10	-2.91	-0.49	0.58	0.58	6.76	435741.29	1764897.95	39.69335817	-80.33547585
	2304.00	1.33	358.72	2303.88	1010.88	0.56	-1.01	-0.47	0.38	0.36	-4.95	435743.19	1764897.98	39.69336339	-80.33547583
	2399.00	1.08	340.31	2398.86	1105.86	-1.22	0.93	-0.80	0.48	-0.26	-19.38	435745.13	1764897.65	39.69336872	-80.33547706
	2494.00	1.05	331.63	2493.85	1200.85	-2.95	2.54	-1.51	0.17	-0.03	-9.14	435746.74	1764896.94	39.69337312	-80.33547965
	2592.00	0.45	302.78	2591.84	1298.84	-4.20	3.54	-2.26	0.70	-0.61	-29.44	435747.74	1764896.19	39.69337584	-80.33548235
	2686.00	0.40	189.33	2685.84	1392.84	-4.31	3.42	-2.63	0.76	-0.05	-120.69	435747.62	1764895.82	39.69337549	-80.33548364
	2781.00	0.59	152.16	2780.83	1487.83	-3.58	2.66	-2.45	0.38	0.20	-39.13	435746.86	1764896.00	39.69337341	-80.33548299
	2876.00	0.98	150.13	2875.83	1582.83	-2.29	1.52	-1.82	0.41	0.41	-2.14	435745.72	1764896.63	39.69337031	-80.33548071
	2971.00	1.11	108.21	2970.81	1677.81	-0.74	0.53	-0.54	0.80	0.14	-44.13	435744.73	1764897.91	39.69336762	-80.33547613
	3062.00	1.75	88.83	3061.78	1768.78	0.74	0.28	1.69	0.87	0.70	-21.30	435744.48	1764900.13	39.69336700	-80.33546821
	3160.00	1.17	49.65	3159.75	1866.75	1.48	0.96	3.95	1.14	-0.59	-39.98	435745.16	1764902.39	39.69336892	-80.33546021
	3254.00	0.99	317.62	3253.74	1960.74	0.58	2.18	4.13	1.66	-0.19	-97.90	435746.38	1764902.58	39.69337227	-80.33545959
	3349.00	2.27	299.43	3348.70	2055.70	-1.93	3.71	1.94	1.44	1.35	-19.15	435747.91	1764900.39	39.69337642	-80.33546743
	3443.00	3.06	302.54	3442.60	2149.60	-5.93	5.98	-1.80	0.85	0.84	3.31	435750.17	1764896.65	39.69338254	-80.33548078
	3538.00	3.83	309.00	3537.43	2244.43	-11.32	9.34	-6.40	0.91	0.81	6.80	435753.54	1764892.05	39.69339165	-80.33549725
	3632.00	4.59	310.00	3631.17	2338.17	-17.97	13.73	-11.72	0.81	0.81	1.06	435757.93	1764886.73	39.69340357	-80.33551630
	3727.00	5.86	311.00	3725.78	2432.78	-26.35	19.36	-18.30	1.34	1.34	1.05	435763.55	1764880.15	39.69341885	-80.33553984
	3821.00	7.11	313.20	3819.17	2526.17	-36.70	26.49	-26.16	1.36	1.33	2.34	435770.68	1764872.29	39.69343822	-80.33556802
	3916.00	7.58	312.48	3913.39	2620.39	-48.57	34.74	-35.07	0.50	0.49	-0.76	435778.94	1764863.39	39.69346066	-80.33559994
	4011.00	8.67	308.94	4007.44	2714.44	-61.57	43.48	-45.26	1.26	1.15	-3.73	435787.67	1764853.19	39.69348437	-80.33563644
	4105.00	8.32	309.89	4100.41	2807.41	-74.94	52.29	-55.98	0.40	-0.37	1.01	435796.48	1764842.47	39.69350829	-80.33567485
	4199.00	8.42	296.74	4193.42	2900.42	-87.57	59.75	-67.35	2.03	0.11	-13.99	435803.94	1764831.10	39.69352848	-80.33571548
	4292.00	8.39	286.62	4285.42	2992.42	-98.89	64.75	-79.93	1.59	-0.03	-10.88	435808.95	1764818.52	39.69354189	-80.33576036
	4387.00	8.05	279.29	4379.45	3086.45	-108.97	67.81	-93.14	1.16	-0.36	-7.72	435812.00	1764805.31	39.69354995	-80.33580738
	4485.00	8.82	271.82	4476.39	3183.39	-118.26	69.16	-107.42	1.36	0.79	-7.62	435813.35	1764791.03	39.69355328	-80.33585818
	4580.00	9.21	264.87	4570.22	3277.22	-126.41	68.71	-122.27	1.22	0.41	-7.32	435812.90	1764776.18	39.69355167	-80.33591093
	4674.00	8.29	262.35	4663.12	3370.12	-133.27	67.13	-136.48	1.06	-0.98	-1.08	435811.33	1764761.97	39.69354698	-80.33596137
	4769.00	8.93	261.02	4757.05	3464.05	-139.66	65.07	-150.55	0.71	0.67	-1.40	435809.26	1764747.90	39.69354096	-80.33601130
	4863.00	9.57	260.45	4849.83	3556.83	-146.21	62.63	-165.47	0.69	0.68	-0.61	435806.83	1764732.99	39.69353389	-80.33606421
	4958.00	10.56	261.25	4943.37	3650.37	-153.46	60.00	-181.86	1.05	1.04	0.84	435804.19	1764716.60	39.69352624	-80.33612236
	5052.00	11.74	262.62	5035.59	3742.59	-161.70	57.46	-199.85	1.29	1.26	1.46	435801.66	1764698.61	39.69351881	-80.33618623
	5147.00	11.96	262.58	5128.57	3835.57	-170.74	54.95	-219.20	0.23	0.23	-0.04	435799.14	1764679.26	39.69351142	-80.33625489
5241.00	12.55	256.88	5220.43	3927.43	-179.06	51.37	-238.81	1.43	0.63	-6.06	435795.57	1764659.66	39.69350110	-80.33632443	
5336.00	12.04	262.02	5313.25	4020.25	-187.40	47.65	-258.67	1.27	-0.54	5.41	435791.85	1764639.79	39.69349039	-80.33639489	
5431.00	12.87	265.03	5406.02	4113.02	-197.20	45.36	-279.02	1.11	0.87	3.17	435789.56	1764619.44	39.69348358	-80.33646714	
5525.00	11.51	262.12	5497.90	4204.90	-206.71	43.17	-298.74	1.59	-1.45	-3.10	435787.36	1764599.72	39.69347705	-80.33653714	
5620.00	13.47	262.54	5590.64	4297.64	-216.15	40.43	-319.11	2.07	2.06	0.44	435784.63	1764579.36	39.69346902	-80.33660940	
5715.00	13.08	260.39	5683.10	4390.10	-225.88	37.20	-340.68	0.66	-0.41	-2.26	435781.40	1764557.79	39.69345960	-80.33668593	
5810.00	11.71	256.21	5775.89	4482.89	-233.97	33.11	-360.64	1.72	-1.44	-4.40	435777.30	1764537.83	39.69344785	-80.33675673	
Final 3rd Party MWD	5904.00	12.58	254.44	5867.79	4574.79	-240.83	28.09	-379.76	1.01	0.93	-1.88	435772.29	1764518.71	39.69343358	-80.33682452
First SLB_MWD	5953.00	12.74	251.83	5915.59	4622.59	-244.17	24.97	-390.04	1.21	0.33	-5.33	435769.17	1764508.43	39.69342477	-80.33686093
KOP	6047.00	12.69	237.31	6007.31	4714.31	-247.59	16.16	-408.58	3.39	-0.05	-15.45	435760.36	1764489.89	39.69340010	-80.33692652
	6237.00	14.61	268.56	6192.19	4899.19	-261.70	4.27	-450.16	3.96	1.01	16.45	435748.47	1764448.32	39.69336640	-80.33707387
	6331.00	14.60	269.16	6283.15	4990.15	-274.91	3.80	-473.86	0.16	-0.01	0.64	435748.00	1764424.62	39.69336450	-80.33715805
	6426.00	14.79	266.96	6375.04	5082.04	-288.05	2.98	-497.94	0.62	0.20	-2.32	435747.18	1764400.54	39.69336164	-80.33724359
	6521.00	13.73	261.24	6467.12	5174.12	-299.45	0.62	-521.19	1.85	-1.12	-6.02	435744.82	1764377.29	39.69335456	-80.33732614
	6616.00	13.85	260.64	6559.38	5266.38	-309.36	-2.95	-543.55	0.20	0.13	-0.63	435741.25	1764354.93	39.69334420	-80.33740548
	6710.00	13.76	259.92	6650.66	5357.66	-318.93	-6.73	-565.66	0.21	-0.10	-0.77	435737.47	1764332.82	39.69333324	-80.33748390
	6804.00	13.90	258.89	6741.94	5448.94	-328.22	-10.86	-587.75	0.30	0.15	-1.10	435733.33	1764310.74	39.69332133	-80.33756224
	6899.00	13.89	259.79	6834.16	5541.16	-337.62	-15.08	-610.16	0.23	-0.01	0.95	435729.11	1764288.32	39.69330917	-80.33764176
	7089.00	13.95	255.63	7018.58	5725.58	-355.25	-24.81	-654.80	0.53	0.03	-2.19	435719.39	1764243.69	39.69328133	-80.33780003
	7183.00	13.63	255.04	7109.87	5816.87	-363.04	-30.48	-676.47	0.37	-0.34	-0.63	435713.72	1764222.02	39.69326520	-80.33787686
	7278.00	11.24	206.41	7202.88	5909.88	-362.44	-41.69	-691.45	10.95	-2.52	-51.19	435702.51	1764207.04	39.69323404	-80.33792969
	7373.00	18.45	158.05	7294.97	6001.97	-343.28	-64.04	-689.94	14.46	7.59	-50.91	435680.16	1764208.55	39.69317274	-80.33792359
	7468.00	18.75	149.32	7385.03	6092.03	-313.40	-91.12	-676.53	2.95	0.3					

Comments	MD (ft)	Incl (°)	Azim Grid (°)	TVD (ft)	TVDSS (ft)	VSEC (ft)	NS (ft)	EW (ft)	DLS (°/100ft)	BR (°/100ft)	TR (°/100ft)	Northing (ftUS)	Easting (ftUS)	Latitude (°)	Longitude (°)
	7752.00	39.84	154.13	7634.89	6341.89	-185.54	-211.61	-625.70	9.03	8.66	-4.38	435532.60	1764272.78	39.69276927	-80.33769046
	7847.00	48.14	152.34	7703.18	6410.18	-120.30	-270.43	-595.95	8.83	8.74	-1.88	435473.78	1764302.54	39.69260856	-80.33758279
	7941.00	56.84	152.17	7760.37	6467.37	-46.40	-336.36	-561.26	9.26	9.26	-0.18	435407.86	1764337.22	39.69242847	-80.33745736
	8036.00	66.50	154.10	7805.40	6512.40	36.27	-410.89	-523.58	10.32	10.17	2.03	435333.33	1764374.90	39.69222483	-80.33732100
	8131.00	74.80	155.25	7836.85	6543.85	124.55	-491.85	-485.29	8.81	8.74	1.21	435252.38	1764413.18	39.69200357	-80.33718228
	8226.00	76.48	150.35	7860.42	6567.42	215.69	-573.67	-443.23	5.30	1.77	-5.16	435170.57	1764455.25	39.69178004	-80.33703010
	8320.00	82.50	149.62	7877.56	6584.56	307.72	-653.65	-397.01	6.45	6.40	-0.78	435090.58	1764501.46	39.69156164	-80.33686324
	8415.00	82.33	149.72	7890.10	6597.10	401.58	-734.93	-349.46	0.21	-0.18	0.11	435009.31	1764549.01	39.69133973	-80.33669159
	8509.00	83.20	149.41	7901.94	6608.94	494.54	-815.33	-302.22	0.98	0.93	-0.33	434928.91	1764596.24	39.69112023	-80.33652109
Landing Point	8604.00	88.18	146.75	7909.08	6616.08	589.09	-895.70	-252.15	5.94	5.24	-2.80	434848.55	1764646.31	39.69090088	-80.33634051
	8699.00	90.33	144.23	7910.31	6617.31	684.07	-973.97	-198.34	3.49	2.26	-2.65	434770.29	1764700.12	39.69068740	-80.33614673
	8794.00	90.41	145.81	7909.70	6616.70	779.06	-1051.80	-143.88	1.67	0.08	1.66	434692.46	1764754.58	39.69047512	-80.33595065
	8889.00	90.08	145.51	7909.29	6616.29	874.05	-1130.25	-90.29	0.47	-0.35	-0.32	434614.02	1764808.16	39.69026116	-80.33575765
	8984.00	89.89	144.59	7909.32	6616.32	969.05	-1208.11	-35.87	0.99	-0.20	-0.97	434536.16	1764862.58	39.69004879	-80.33556171
	9079.00	89.78	144.69	7909.59	6616.59	1064.05	-1285.59	19.11	0.16	-0.12	0.11	434458.69	1764917.56	39.68983752	-80.33536382
	9174.00	90.79	144.70	7909.12	6616.12	1159.05	-1363.11	74.01	1.06	1.06	0.01	434381.17	1764972.46	39.68962609	-80.33516618
	9268.00	88.78	146.03	7909.47	6616.47	1253.04	-1440.45	127.43	2.56	-2.14	1.41	434303.84	1765025.87	39.68941516	-80.33497382
	9363.00	87.84	145.26	7912.27	6619.27	1347.99	-1518.84	181.02	1.28	-0.99	-0.99	434225.45	1765079.45	39.68920132	-80.33478084
	9458.00	88.13	145.62	7915.61	6622.61	1442.93	-1597.03	234.87	0.49	0.31	0.38	434147.27	1765133.31	39.68898806	-80.33458691
	9553.00	88.63	144.89	7918.32	6625.32	1537.89	-1675.06	289.00	0.92	0.51	-0.77	434069.24	1765187.43	39.68877524	-80.33439204
	9649.00	89.02	144.45	7920.30	6627.30	1633.86	-1753.36	344.50	0.63	0.43	-0.46	433990.94	1765242.93	39.68856170	-80.33419225
	9744.00	88.58	144.04	7922.29	6629.29	1728.84	-1830.44	400.00	0.63	-0.46	-0.43	433913.87	1765298.42	39.68835152	-80.33399252
	9839.00	88.85	143.35	7924.42	6631.42	1823.79	-1906.98	456.23	0.78	0.28	-0.73	433837.34	1765354.65	39.68814284	-80.33379020
	9934.00	87.94	144.48	7927.08	6634.08	1918.73	-1983.72	512.16	1.53	-0.96	1.19	433760.60	1765410.58	39.68793360	-80.33358895
	10029.00	87.30	143.21	7931.03	6638.03	2013.63	-2060.35	568.16	1.50	-0.67	-1.34	433683.97	1765466.57	39.68772464	-80.33338747
	10124.00	87.15	143.65	7935.63	6642.63	2108.48	-2136.56	624.69	0.49	-0.16	0.46	433607.77	1765523.10	39.68751688	-80.33318409
	10219.00	87.81	144.99	7939.80	6646.80	2203.38	-2213.65	680.05	1.57	0.69	1.41	433530.68	1765578.45	39.68730666	-80.33298488
	10314.00	87.71	145.57	7943.52	6650.52	2298.30	-2291.68	734.11	0.62	-0.11	0.61	433452.66	1765632.52	39.68709385	-80.33279021
	10409.00	87.52	145.84	7947.47	6654.47	2393.21	-2370.09	787.60	0.35	-0.20	0.28	433374.25	1765686.00	39.68687994	-80.33259762
	10504.00	87.14	144.98	7951.90	6658.90	2488.11	-2448.21	841.47	0.99	-0.40	-0.91	433296.13	1765739.86	39.68666686	-80.33240364
	10599.00	87.08	144.95	7956.69	6663.69	2582.99	-2525.90	895.94	0.07	-0.06	-0.91	433218.45	1765794.33	39.68645498	-80.33220756
	10694.00	87.12	144.45	7961.49	6668.49	2677.86	-2603.34	950.76	0.53	0.04	-0.53	433141.02	1765849.15	39.68624380	-80.33201022
	10789.00	86.99	144.51	7966.37	6673.37	2772.73	-2680.56	1005.88	0.15	-0.14	0.06	433063.81	1765904.27	39.68603322	-80.33181185
	10884.00	86.98	144.85	7971.37	6678.37	2867.60	-2757.96	1060.73	0.36	-0.01	0.36	432986.40	1765959.11	39.68582212	-80.33161443
	10979.00	87.18	144.05	7976.21	6683.21	2962.47	-2835.15	1115.89	0.87	0.21	-0.84	432909.22	1766014.27	39.68561162	-80.33141591
	11073.00	86.91	145.88	7981.06	6688.06	3056.34	-2912.02	1169.78	1.97	-0.29	1.95	432832.36	1766068.16	39.68540199	-80.33122192
	11168.00	88.26	144.65	7985.06	6692.06	3151.25	-2990.01	1223.86	1.92	1.42	-1.29	432754.37	1766122.23	39.68518925	-80.33102722
	11262.00	88.46	145.38	7989.75	6696.75	3245.21	-3067.00	1277.73	0.80	0.21	-1.29	432677.39	1766176.10	39.68497929	-80.33083329
	11357.00	87.90	146.40	7990.77	6697.77	3340.15	-3145.61	1330.98	1.22	-0.59	1.07	432598.78	1766229.35	39.68476483	-80.33064153
	11451.00	87.91	145.17	7994.20	6701.20	3434.08	-3223.29	1383.80	1.31	0.01	-1.31	432521.10	1766282.16	39.68455293	-80.33045132
	11545.00	88.11	144.97	7997.47	6704.47	3528.02	-3300.31	1437.59	0.30	0.21	-0.21	432444.09	1766335.95	39.68434286	-80.33025769
	11640.00	88.18	144.61	8000.54	6707.54	3622.97	-3377.89	1492.34	0.39	0.07	-0.38	432366.52	1766390.69	39.68413128	-80.33006064
	11734.00	87.74	145.19	8003.89	6710.89	3716.91	-3454.74	1546.35	0.77	-0.47	0.62	432289.66	1766444.71	39.68392167	-80.32986621
	11828.00	89.15	144.40	8006.44	6713.44	3810.87	-3531.52	1600.52	1.72	1.50	-0.84	432212.89	1766498.87	39.68371228	-80.32967124
	11923.00	89.10	144.30	8007.89	6714.89	3905.86	-3608.71	1655.88	0.12	-0.05	-0.11	432135.71	1766554.23	39.68350179	-80.32947202
	12017.00	89.15	145.18	8009.33	6716.33	3999.84	-3685.45	1710.14	0.94	0.05	0.94	432058.97	1766608.49	39.68329248	-80.32927674
	12112.00	89.09	144.50	8010.78	6717.78	4094.83	-3763.11	1764.84	0.72	-0.06	-0.72	431981.32	1766663.18	39.68308069	-80.32907985
	12206.00	89.96	142.99	8011.56	6718.56	4188.80	-3838.90	1820.43	1.85	0.93	-1.61	431905.53	1766718.77	39.68287402	-80.32887989
	12301.00	89.97	144.65	8011.62	6718.62	4283.78	-3915.58	1876.51	1.75	0.01	1.75	431828.85	1766774.84	39.68266495	-80.32867814
	12395.00	90.30	144.29	8011.40	6718.40	4377.77	-3992.08	1931.13	0.52	0.35	-0.38	431752.36	1766829.46	39.68245633	-80.32848157
	12490.00	90.33	141.28	8010.88	6717.88	4472.69	-4067.73	1988.58	3.17	0.03	-3.17	431676.72	1766886.91	39.68225013	-80.32827499
	12584.00	90.42	144.95	8010.26	6717.26	4566.62	-4142.90	2044.99	3.91	0.10	3.90	431601.55	1766943.32	39.68204520	-80.32807212
	12679.00	90.63	144.31	8009.39	6716.39	4661.61	-4220.36	2099.98	0.71	0.22	-0.67	431524.09	1766998.30	39.68183394	-80.32787423
	12773.00	91.09	144.70	8007.98	6714.98	4755.60	-4296.88	2154.55	0.64	0.49	0.41	431447.58	1767052.87	39.68162525	-80.32767785
	12867.00	90.95	144.49	8006.31	6713.31	4849.58	-4373.49	2209.00	0.27	-0.15	-0.22	431370.98	1767107.32	39.68141634	-80.32748190
	12962.00	91.85	144.89	8003.99	6710.99	4944.55	-4450.99	2263.90	1.04	0.95	0.42	431293.48	1767162.21	39.68120497	-80.32728435
	13057.00	91.93	144.77	8000.85	6707.85	5039.50	-4528.60	2318.59	0.15	0.08	-0.13	431215.87	1767216.89	39.68099329	-80.32708751
	13151.00	91.93	143.63	7997.69	6704.69	5133.44	-4604.80	2373.54	1.21	0.00	-1.21	431139.68	1767271.85	39.68078551	-80.32688979
	13245.00	92.10	146.08	7994.38	6701.38	5227.37	-4681.61	2427.61	2.61	0.18	2.61	431062.87	1767325.92	39.68057602	-80.32669518
	13340.00	92.44	147.36	7990.62	6697.62	5322.25	-4760.96	2479.70	1.39	0.36	1.35	430983.52	1767378.00	39.68035949	-80.32650754
	13434.00	92.09	144.50	7986.90	6693.90	5416.15	-4838.76	2532.31	3.06	-0.37	-3.04	430905.73	1767430.61	39.68014725	-80.32631808
	13529.00	91.79	144.95	7983.69	6690.69	5511.10	-4916.27	2587.15	0.57	-0.32	0.47	430828.23	1767485.44	39.67993585	-80.32612076
	13624.00	91.73	144.92	7980.77	6687.77	5606.05	-4993.99	2641.70	0.07	-0.06	-0.03	430750.51	1767539.99	39.67972387	-80.32592442
	13719.00	91.70	145.10	7977.93	6684.93	5701.01	-5071.79	2696.15	0.19	-0.03	0.19	430672.72	1767594.43	39.67951169	-80.32572844

Comments	MD (ft)	Incl (°)	Azlm Grid (°)	TVD (ft)	TVDSS (ft)	VSEC (ft)	NS (ft)	EW (ft)	DLS (°/100R)	BR (°/100R)	TR (°/100R)	Northing (ftUS)	Easting (ftUS)	Latitude (°)	Longitude (°)
	14667.00	92.05	144.37	7943.35	6650.35	6648.14	-5852.98	3231.74	0.20	-0.18	-0.07	429891.57	1768129.99	39.67738086	-80.32380027
	14762.00	91.70	144.62	7940.24	6647.24	6743.08	-5930.28	3286.89	0.45	-0.37	0.26	429814.28	1768185.14	39.67716986	-80.32360186
	14857.00	91.32	144.70	7937.74	6644.74	6838.05	-6007.75	3341.82	0.40	0.08	0.08	429736.82	1768240.06	39.67695858	-80.32340419
	14952.00	91.54	144.76	7935.36	6642.36	6933.01	-6085.28	3396.66	0.24	0.23	0.06	429659.28	1768294.90	39.67674470	-80.32320686
	15047.00	91.44	145.27	7932.89	6639.89	7027.98	-6163.09	3451.11	0.55	-0.11	0.54	429581.48	1768349.35	39.67653488	-80.32301089
	15142.00	91.42	146.15	7930.52	6637.52	7122.94	-6241.55	3504.61	0.93	-0.02	0.93	429503.02	1768402.85	39.67632083	-80.32281827
	15237.00	91.61	145.11	7928.01	6635.01	7217.90	-6319.94	3558.22	1.11	0.20	-1.09	429424.64	1768456.45	39.67610699	-80.32262528
	15332.00	91.95	145.74	7925.06	6632.06	7312.86	-6398.12	3612.11	0.75	0.36	0.66	429346.46	1768510.34	39.67589372	-80.32243132
	15427.00	91.29	145.00	7922.38	6629.38	7407.81	-6476.26	3666.07	1.04	-0.69	-0.78	429268.33	1768564.30	39.67568058	-80.32223708
	15522.00	91.20	144.81	7920.31	6627.31	7502.79	-6553.97	3720.88	0.22	-0.09	-0.20	429190.62	1768618.90	39.67546862	-80.32204057
	15617.00	90.98	145.32	7918.50	6625.50	7597.77	-6631.84	3775.07	0.58	-0.23	0.54	429112.76	1768673.29	39.67525623	-80.32184482
	15712.00	90.64	144.97	7917.16	6624.16	7692.76	-6709.79	3829.36	0.51	-0.36	-0.37	429034.82	1768727.57	39.67504360	-80.32164944
	15807.00	90.32	143.88	7916.37	6623.37	7787.75	-6787.05	3884.62	1.20	-0.34	-1.15	428957.56	1768782.83	39.67483289	-80.32145062
	15902.00	90.51	145.14	7915.68	6622.68	7882.75	-6864.40	3939.77	1.34	0.20	1.33	428880.22	1768837.98	39.67462194	-80.32125219
	15997.00	90.93	144.70	7914.48	6621.48	7977.74	-6942.14	3994.36	0.64	0.44	-0.46	428802.48	1768892.57	39.67440991	-80.32105573
	16092.00	90.72	146.29	7913.12	6620.12	8072.72	-7020.41	4048.17	1.69	-0.22	1.67	428724.21	1768946.38	39.67419637	-80.32086205
	16187.00	90.31	144.22	7912.26	6619.26	8167.71	-7098.47	4102.31	2.22	-0.43	-2.18	428646.16	1769000.51	39.67398346	-80.32066721
	16282.00	90.42	146.29	7911.66	6618.66	8262.70	-7176.52	4156.45	2.18	0.12	2.18	428568.11	1769054.65	39.67377054	-80.32047236
	16377.00	90.10	144.64	7911.22	6618.22	8357.70	-7254.78	4210.30	1.77	-0.34	-1.74	428489.86	1769108.50	39.67355707	-80.32027852
	16471.00	90.61	144.42	7910.64	6617.64	8451.69	-7331.33	4264.85	0.59	0.54	-0.23	428413.31	1769163.04	39.67334828	-80.32008228
	16566.00	90.54	145.10	7909.69	6616.69	8546.68	-7408.92	4319.66	0.72	-0.07	0.72	428335.73	1769217.85	39.67313667	-80.31988506
	16661.00	90.34	145.16	7908.96	6615.96	8641.68	-7486.86	4373.97	0.22	-0.21	0.06	428257.79	1769272.15	39.67292407	-80.31968960
	16756.00	90.45	144.08	7908.30	6615.30	8736.68	-7564.31	4428.97	1.14	0.12	-1.14	428180.35	1769327.15	39.67271282	-80.31949171
	16850.00	90.58	145.35	7907.46	6614.46	8830.67	-7641.04	4483.27	1.36	0.14	1.35	428103.62	1769381.45	39.67250355	-80.31929636
	16944.00	90.44	145.16	7906.62	6613.62	8924.66	-7718.27	4536.84	0.25	-0.15	-0.20	428026.39	1769435.01	39.67229286	-80.31910357
	17039.00	90.54	145.33	7905.81	6612.81	9019.66	-7796.32	4590.99	0.21	0.11	0.18	427948.35	1769489.16	39.67207996	-80.31890867
	17134.00	90.67	145.20	7904.81	6611.81	9114.65	-7874.39	4645.12	0.19	0.14	-0.14	427870.29	1769543.29	39.67186701	-80.31871388
	17228.00	90.55	147.35	7903.81	6610.81	9208.62	-7952.56	4697.30	2.29	-0.13	2.29	427792.12	1769595.47	39.67165372	-80.31852598
	17323.00	90.38	141.67	7903.04	6610.04	9303.57	-8029.88	4752.43	5.98	-0.18	-5.98	427714.81	1769650.59	39.67144285	-80.31832766
	17417.00	90.57	144.76	7902.26	6609.26	9397.51	-8105.15	4808.71	3.29	0.20	3.29	427639.54	1769706.87	39.67123762	-80.31812531
	17511.00	90.30	146.22	7901.54	6608.54	9491.50	-8182.60	4861.97	1.58	-0.29	1.55	427562.09	1769760.12	39.67102633	-80.31793364
	17606.00	90.36	141.69	7900.99	6607.99	9586.46	-8259.39	4917.85	4.77	0.06	-4.77	427485.30	1769816.00	39.67081692	-80.31773265
	17701.00	89.92	141.44	7900.76	6607.76	9681.29	-8333.81	4976.90	0.53	-0.46	-0.26	427410.89	1769875.05	39.67061411	-80.31752048
	17795.00	90.60	144.20	7900.34	6607.34	9775.21	-8408.69	5033.70	3.02	0.72	2.94	427336.01	1769931.85	39.67040996	-80.31731630
	17890.00	90.35	145.41	7899.55	6606.55	9870.21	-8486.32	5088.46	1.30	-0.26	1.27	427258.39	1769986.60	39.67021182	-80.31711931
	17985.00	90.03	145.41	7899.23	6606.23	9965.20	-8564.53	5142.39	0.34	-0.34	0.00	427180.19	1770040.52	39.66998467	-80.31692522
	18080.00	90.48	145.72	7898.81	6605.81	10060.20	-8642.88	5196.11	0.58	0.47	0.33	427101.84	1770094.24	39.66977112	-80.31673187
	18175.00	89.95	145.93	7898.45	6605.45	10155.19	-8721.48	5249.47	0.60	-0.56	0.22	427023.25	1770147.48	39.66955670	-80.31653979
	18270.00	89.72	145.24	7898.73	6605.73	10250.18	-8799.85	5303.16	0.77	-0.24	-0.73	426944.88	1770201.29	39.66934289	-80.31634654
	18365.00	89.75	144.90	7898.17	6605.17	10345.18	-8877.73	5357.55	0.36	0.03	-0.36	426867.00	1770255.68	39.66913044	-80.31615082
	18460.00	89.45	145.37	7898.83	6606.83	10440.18	-8955.68	5411.86	0.59	-0.32	0.49	426789.06	1770309.98	39.66891782	-80.31595542
	18555.00	90.15	145.06	7900.16	6607.16	10535.17	-9033.70	5466.06	0.81	0.74	0.81	426711.05	1770364.17	39.66870499	-80.31576039
	18650.00	90.25	145.07	7899.83	6606.83	10630.17	-9111.58	5520.46	0.11	0.11	0.01	426633.17	1770418.57	39.66849254	-80.31556465
	18745.00	90.08	144.53	7899.29	6606.29	10719.17	-9266.02	5629.40	0.30	-0.09	-0.29	426478.74	1770527.51	39.66828013	-80.31537270
	18839.00	89.93	145.22	7899.28	6606.28	10814.17	-9343.72	5684.06	0.74	-0.16	0.73	426401.04	1770582.16	39.66806765	-80.31518095
	18934.00	89.75	145.61	7899.54	6606.54	10909.17	-9421.93	5737.99	0.45	-0.19	0.41	426322.84	1770636.09	39.66785519	-80.31497609
	19029.00	89.65	145.20	7899.03	6606.03	11003.16	-9499.45	5791.15	0.16	-0.11	-0.12	426245.32	1770689.25	39.66764271	-80.31478199
	19123.00	89.65	145.30	7900.62	6607.62	11108.16	-9577.65	5845.10	0.21	0.00	-0.21	426167.13	1770743.19	39.66743023	-80.31459065
	19218.00	89.25	145.11	7901.52	6608.52	11292.15	-9654.83	5898.73	0.47	-0.43	-0.20	426089.95	1770796.82	39.66721775	-80.31439652
	19312.00	89.65	143.70	7903.06	6610.06	11387.13	-9732.07	5954.02	1.53	-0.38	-1.48	426012.72	1770852.11	39.66700527	-80.31420352
	19407.00	88.89	145.21	7904.30	6611.30	11481.12	-9808.55	6008.66	1.77	0.76	1.61	425936.25	1770906.74	39.66679279	-80.31400467
	19501.00	89.60	144.74	7904.57	6611.57	11576.12	-9886.34	6063.18	0.70	0.49	-0.49	425858.46	1770961.26	39.66658031	-80.31380813
	19596.00	90.13	144.88	7904.41	6611.41	11669.11	-9962.34	6116.78	0.16	0.06	0.15	425782.46	1771014.86	39.66636783	-80.31361197
	19689.00	90.64	144.38	7903.78	6610.78	11763.11	-10038.99	6171.19	0.76	0.54	-0.53	425705.81	1771069.26	39.66615535	-80.31341916
	19783.00	90.32	144.27	7902.99	6609.99	11857.10	-10115.35	6226.01	0.36	-0.34	-0.12	425629.46	1771124.08	39.66594287	-80.31322344
	19877.00	90.39	144.65	7902.41	6609.41	11951.09	-10191.84	6280.64	0.41	0.07	0.40	425552.98	1771178.71	39.66573039	-80.31302628
	19971.00	90.39	144.65	7902.41	6609.41	11951.09	-10191.84	6280.64	0.41	0.07	0.40	425552.98	1771178.71	39.66551791	-80.31282957
	20066.00	90.55	144.20	7901.63	6608.63	12046.09	-10269.10	6335.91	0.50	0.17	-0.47	425475.72	1771233.97	39.66530543	-80.31263097
	20160.00	90.77	144.38	7900.55	6607.55	12140.07	-10345.42	6390.77	0.30	0.23	0.19	425399.40	1771288.83	39.66509295	-80.31243366
	20255.00	90.64	144.42	7899.38	6606.38	12235.06	-10422.66	6446.07	0.14	-0.14	0.04	425322.17	1771343.13	39.66488047	-80.31223477
	20349.00	89.83	144.79	7898.99	6605.99	12329.06	-10499.29	6500.51	0.95	-0.86	0.39	425245.55	1771398.57	39.66466799	-80.31203894
	20444.00	89.44	144.84	7898.60	6606.60	12424.05	-10576.93	6555.25	0.41	-0.41	0.05	425167.91	1771453.31	39.66445551	-80.31184202
	20538.00	89.45	144.84	7900.51	6607.51	12518.05	-10653.78	6609.38	0.01	0.00	0.00	425091.07	1771507.43	39.66424303	-80.31164730
	20633.00	89.36	145.97	7901.49	6608.49	12									

Comments	MD (ft)	Incl (°)	Azlm Grid (°)	TVD (ft)	TVDSS (ft)	VSEC (ft)	NS (ft)	EW (ft)	DLS (*100ft)	BR (*100ft)	TR (*100ft)	Northing (ftUS)	Easting (ftUS)	Latitude (°)	Longitude (°)
	21575.00	89.40	145.55	7909.32	6616.32	13554.94	-11508.68	7196.22	0.07	0.05	0.04	424236.22	1772094.23	39.66195368	-80.30953562
	21670.00	90.13	145.50	7909.71	6616.71	13649.93	-11586.99	7250.00	0.77	0.77	-0.05	424157.91	1772148.01	39.66174002	-80.30934213
	21857.00	90.25	145.57	7909.09	6616.09	13836.92	-11741.17	7355.82	0.07	0.06	0.04	424003.74	1772253.82	39.66131940	-80.30896135
	21949.00	89.98	145.85	7908.91	6615.91	13928.92	-11817.17	7407.65	0.42	-0.29	0.30	423927.74	1772305.65	39.66111202	-80.30877483
	22043.00	89.81	145.44	7909.08	6616.08	14022.91	-11894.78	7460.70	0.47	-0.18	-0.44	423850.14	1772358.69	39.66090030	-80.30858396
	22136.00	89.95	145.28	7909.27	6616.27	14115.91	-11971.29	7513.56	0.23	0.15	-0.17	423773.63	1772411.55	39.66069155	-80.30839376
	22229.00	90.01	145.54	7909.31	6616.31	14208.91	-12047.85	7566.35	0.29	0.06	0.28	423697.08	1772464.34	39.66048268	-80.30820381
	22323.00	89.58	145.44	7909.64	6616.64	14302.90	-12125.31	7619.61	0.47	-0.46	-0.11	423619.62	1772517.60	39.66027136	-80.30801219
	22416.00	89.54	146.20	7910.36	6617.36	14395.89	-12202.24	7671.86	0.82	-0.04	0.82	423542.69	1772569.84	39.66006145	-80.30782418
	22508.00	89.55	146.62	7911.09	6618.09	14487.86	-12278.88	7722.75	0.46	0.01	0.46	423466.06	1772620.73	39.65985233	-80.30764097
	22602.00	89.35	153.04	7911.99	6618.99	14581.47	-12360.10	7769.97	6.83	-0.21	6.83	423384.85	1772667.94	39.65963053	-80.30747070
	22695.00	89.02	145.26	7913.31	6620.31	14674.15	-12439.87	7817.61	8.37	-0.35	-8.37	423305.08	1772715.59	39.65941272	-80.30729893
	22789.00	89.12	144.95	7914.84	6621.84	14768.13	-12516.96	7871.38	0.35	0.11	-0.33	423228.00	1772769.35	39.65920242	-80.30710551
	22884.00	89.97	144.88	7915.59	6622.59	14863.13	-12594.70	7925.99	0.90	0.89	-0.07	423150.27	1772823.95	39.65899037	-80.30690911
	22978.00	89.92	144.78	7915.68	6622.68	14957.13	-12671.54	7980.13	0.12	-0.05	-0.11	423073.43	1772878.09	39.65878076	-80.30671436
Last SLB_MWD	23029.00	89.68	144.64	7915.86	6622.86	15008.13	-12713.16	8009.59	0.54	-0.47	-0.27	423031.80	1772907.56	39.65866721	-80.30660840
Projection to TD	23054.00	89.68	144.64	7916.00	6623.00	15033.13	-12733.55	8024.06	0.00	0.00	0.00	423011.42	1772922.02	39.65861160	-80.30655636

Survey Type: Def Survey

Survey Error Model: ISCSA Rev 3 \*\*\* 3-D 95.000% Confidence 2.7955 sigma  
 Survey Program:

Description	Part	MD From (ft)	MD To (ft)	EOU Freq (ft)	Hole Size (in)	Casing Diameter (in)	Survey Tool Type	Borehole / Survey
	1	0.000	29.000	1/98.425	17.500	13.375	A020Ga_GYRO-NS-Depth Only	Original Borehole / CNX WDTN19EHSM Surveys 0ft to 23054ft MD
	1	29.000	29.000	Act Stns	17.500	13.375	A020Ga_GYRO-NS-Depth Only	Original Borehole / CNX WDTN19EHSM Surveys 0ft to 23054ft MD
	1	29.000	1155.000	Act Stns	17.500	13.375	A020Ga_GYRO-NS	Original Borehole / CNX WDTN19EHSM Surveys 0ft to
	1	1155.000	3100.000	Act Stns	12.250	9.625	A001Mb_MWD	Original Borehole / CNX WDTN19EHSM Surveys 0ft to
	1	3100.000	5953.000	Act Stns	8.750	5.500	A001Mb_MWD	Original Borehole / CNX WDTN19EHSM Surveys 0ft to
	1	5953.000	23054.000	Act Stns	8.500	5.500	B006Mb_MWD+IGRF	Original Borehole / CNX WDTN19EHSM Surveys 0ft to

...CNX WDTN19 Pad\WDTN19EHSM\Original Borehole\CNX WDTN19EHSM Surveys 0ft to 23054ft MD





CNX





<b>Borehole:</b> Original Borehole	<b>Well:</b> WDTN19EHSM	<b>Field:</b> WV Monongalia County (NAD 27)	<b>Structure:</b> Patterson 873
---------------------------------------	----------------------------	--	------------------------------------

<b>Gravity &amp; Magnetic Parameters</b> Model: HDGM 2022 Dip: 66.37° Date: 02-Dec-2022 MagDec: -8.913° FS: 61783.096T Gravity FS: 999.342mgm (9.80665 Based)	<b>Surface Location</b> NAD27 West Virginia State Plane, Northern Zone, US Feet Lat: N 39 41 36.12 Lon: W 80 20 7.71 Northing: 426744.2815 Easting: 1764898.48RUS Grid Conv: -0.5320° Scale Fact: 0.96994143	<b>Miscellaneous</b> Shot: WDTN19EHSM TVD Ref: KB(1293R above MSL) Plan: CNX WDTN19EHSM Surveys Off to 23064R MD
---	--	--



Critical Point	MD	BHCL	AZM	TVD	WSEC	NE95H	EW95H	DLS
Surface	0.00	0.00	0.00	0.00	0.00	0.00	0.00	
Final Dip	1155.00	0.36	143.05	1154.64	4.77	-7.81	-2.81	1.87
Final 3rd Party MWD	5964.70	12.11	254.44	5887.79	-240.91	28.00	-104.76	1.31
Final SLS_MWD	5453.00	12.74	251.87	5441.54	-244.17	24.87	-104.34	1.21
ICP	7183.00	13.13	251.24	7164.87	-252.04	-28.48	-104.47	0.37

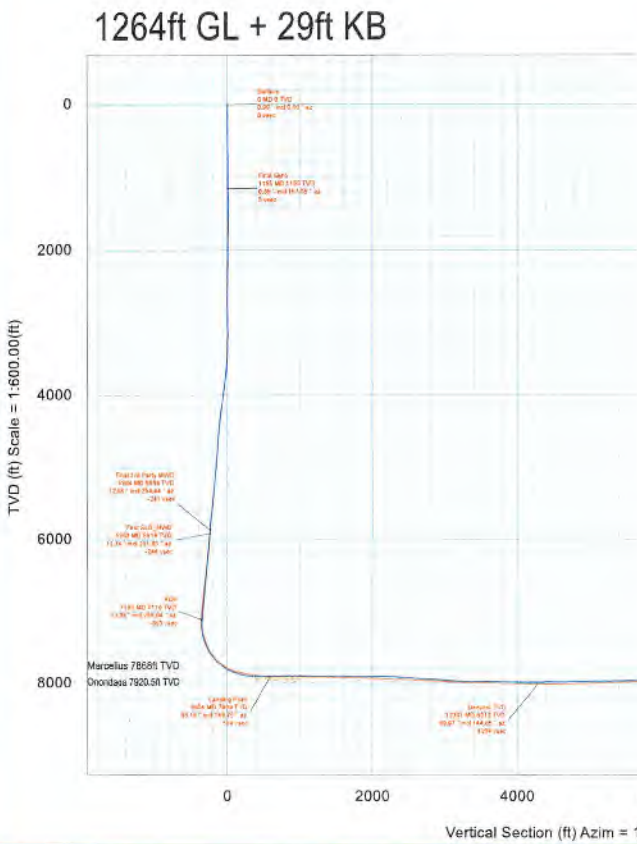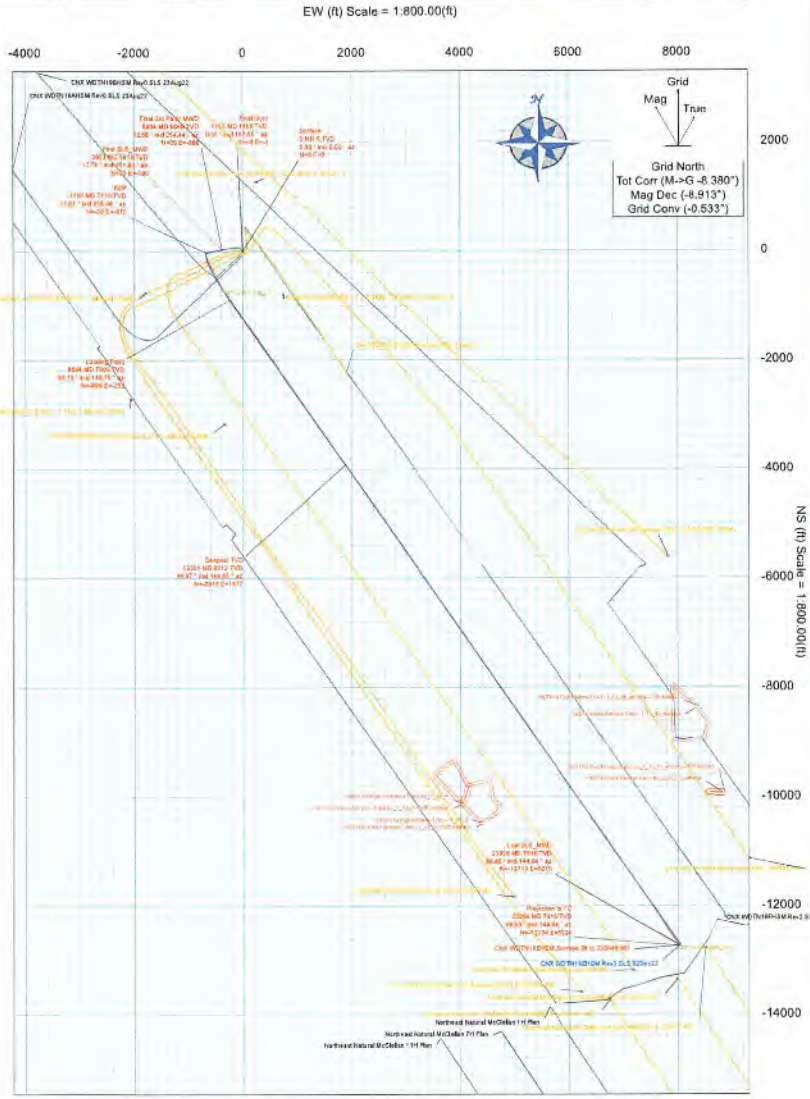

09/15/2023