

LATITUDE 39°42'30"

090W

150

80°21'30"

LONGITUDE

75'

*[Faint, illegible text, likely bleed-through from the reverse side of the page]*

### 7.5 OGIS topo location

7.5' loc	<u>0.515</u>	15' loc	<u>3.395</u>
	<u>0.90W</u>	(calc.)	<u>3.12W</u>

Company \_\_\_\_\_

Farm \_\_\_\_\_

Quad Blacksuille (Blacksuille NW)


County Monongahela

District Clay

### WELL LOCATION MAP

File No. 061-122A  
061-30122


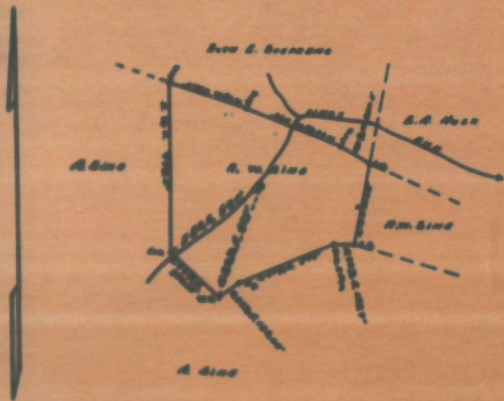

I, the undersigned, hereby certify that this map is correct and shows all the information to the best of my knowledge and belief, required by the oil and gas section of the Mining Laws of West Virginia.

State of West Virginia \_\_\_\_\_  

Engineer.

Clay District, Monongalia County, W. Va.  
Carnegie Natural Gas Co., 962 Frick Bldg. Annex, Pittsburgh, Pa.  
On 50 acres, surface and mineral rights owned by R. W. Sine,

Route 2, Fairview, W. Va.

Drilled before June, 1929.

Elevation, 1158' B.

10" casing, 620'; 8 $\frac{1}{4}$ " 788' 3"; 6-5/8", 2066'; 5-3/16", 3046';

Hook wall packer, 6-5/8 x 5-3/16, set at 3046'.

Coal was encountered at 445-448, 720-726, and 815-821'.

Abandonment reported to Dept. of Mines June 19, 1935.

Well was shot at 3090-3095'.

Fresh water at 1475'; salt water at 1687'.

	Top.	Bottom.
Fairview Coal (Waynesburg)	445	- 448
Mapletown Coal	720	- 726
Pittsburgh Coal	815	- 821
Little Dunkard Sand	1165	- 1185
Big Dunkard Sand	1315	- 1355
2nd Big Dunkard Sand (water, 1475')	1470	- 1495
Gas Sand	1550	- 1595
1st Salt Sand	1613	- 1653
2nd Salt Sand (water, 1687')	1674	- 1826
Little Lime	2034	- 2042
Pencil Cave	2042	- 2048
Big Lime	2048	- 2095
Big Injun Sand (gas, 2118-2120'; gas, 2135')	2095	- 2325
Gantz Sand	2485	- 2530
50-Ft. Sand	2723	- 2845
30-Ft. Sand	2852	- 2905
Gordon Stray Sand	2965	- 2982
Gordon Sand	3028	- 3054
Fourth Sand (oil, 3090-3095')	3083	- 3131
Fifth Sand (gas, 3175')	3173	- 3187
Sand (gas, 3299')	3298	- 3301
Total depth		3315

05-122-A

122A

Clay District, Monongalia County, W. Va.

By Carnegie Natural Gas Co., 962 Frick Bldg. Annex, Pittsburgh, Pa.

On 50 acres, surface and mineral rights owned by R. W. Sine,  
Route 2, Fairview, W. Va.

Drilled before June, 1929.

Elevation, 1158' B.

10" casing, 620'; 8 $\frac{1}{4}$ " 788' 3"; 6-5/8", 2066'; 5-3/16", 3046'.

Hook wall packer, 6-5/8 x 5-3/16, set at 3046'.

Coal was encountered at 445-448, 720-726, and 815-821'.

Abandonment reported to Dept. of Mines June 19, 1935.

Well was not shot.

Fresh water at 1475'; salt water at 1687'.

Gas well.

	Top.	Bottom.	Thickness.
Fairview (Waynesburg) Coal	445	- 448	3
Mapletown (Sewickley) Coal	720	- 726	6
Pittsburgh Coal	815	- 821	6
Little Dunkard Sand	1165	- 1185	20
Big Dunkard Sand	1315	- 1355	40
2nd Big Dunkard Sand (water, 1475')	1470	- 1495	25
Gas Sand	1550	- 1595	45
1st Salt Sand	1613	- 1653	40
2nd Salt Sand (water, 1687')	1674	- 1826	152
Little Lime	2034	- 2042	8
Pencil Cave	2042	- 2048	6
Big Lime	2048	- 2095	47
Big Injun Sand (gas, 2118-2120' & 2135')	2095	- 2325	230
Gantz Sand	2485	- 2530	45
50-Ft. Sand	2723	- 2845	122
30-Ft. Sand	2852	- 2905	53
Gordon Stray Sand	2965	- 2982	17
Gordon Sand	3028	- 3054	26
Fourth Sand (oil, 3090-3095')	3083	- 3131	48
Fifth Sand (gas, 3175')	3173	- 3187	14
Sand (gas, 3299')	3298	- 3301	3
Total depth			3315

## WEST VIRGINIA DEPARTMENT OF MINES

## Oil and Gas Section

## PRELIMINARY DATA SHEET NO. 1
























Edwards were used as follows: (Give details) \_\_\_\_\_

\_\_\_\_\_

\_\_\_\_\_

\_\_\_\_\_

Date June 20, 1922

Approved \_\_\_\_\_

CARNegie NATURAL GAS COMPANY \_\_\_\_\_

By \_\_\_\_\_

 902 Frick Building Annex, Address  
 PITTSBURGH, Pa.

COMPLETION DATA SHEET  
 NO. 2  
 FORMATION RECORD

Lease 44661 - Well No. 202

Name	Color	Character	Oil, Gas or Water	Top	Bottom	Thickness	Total Depth	Remarks

6-17-31



Well was producing \_\_\_\_\_ bbls. per day


