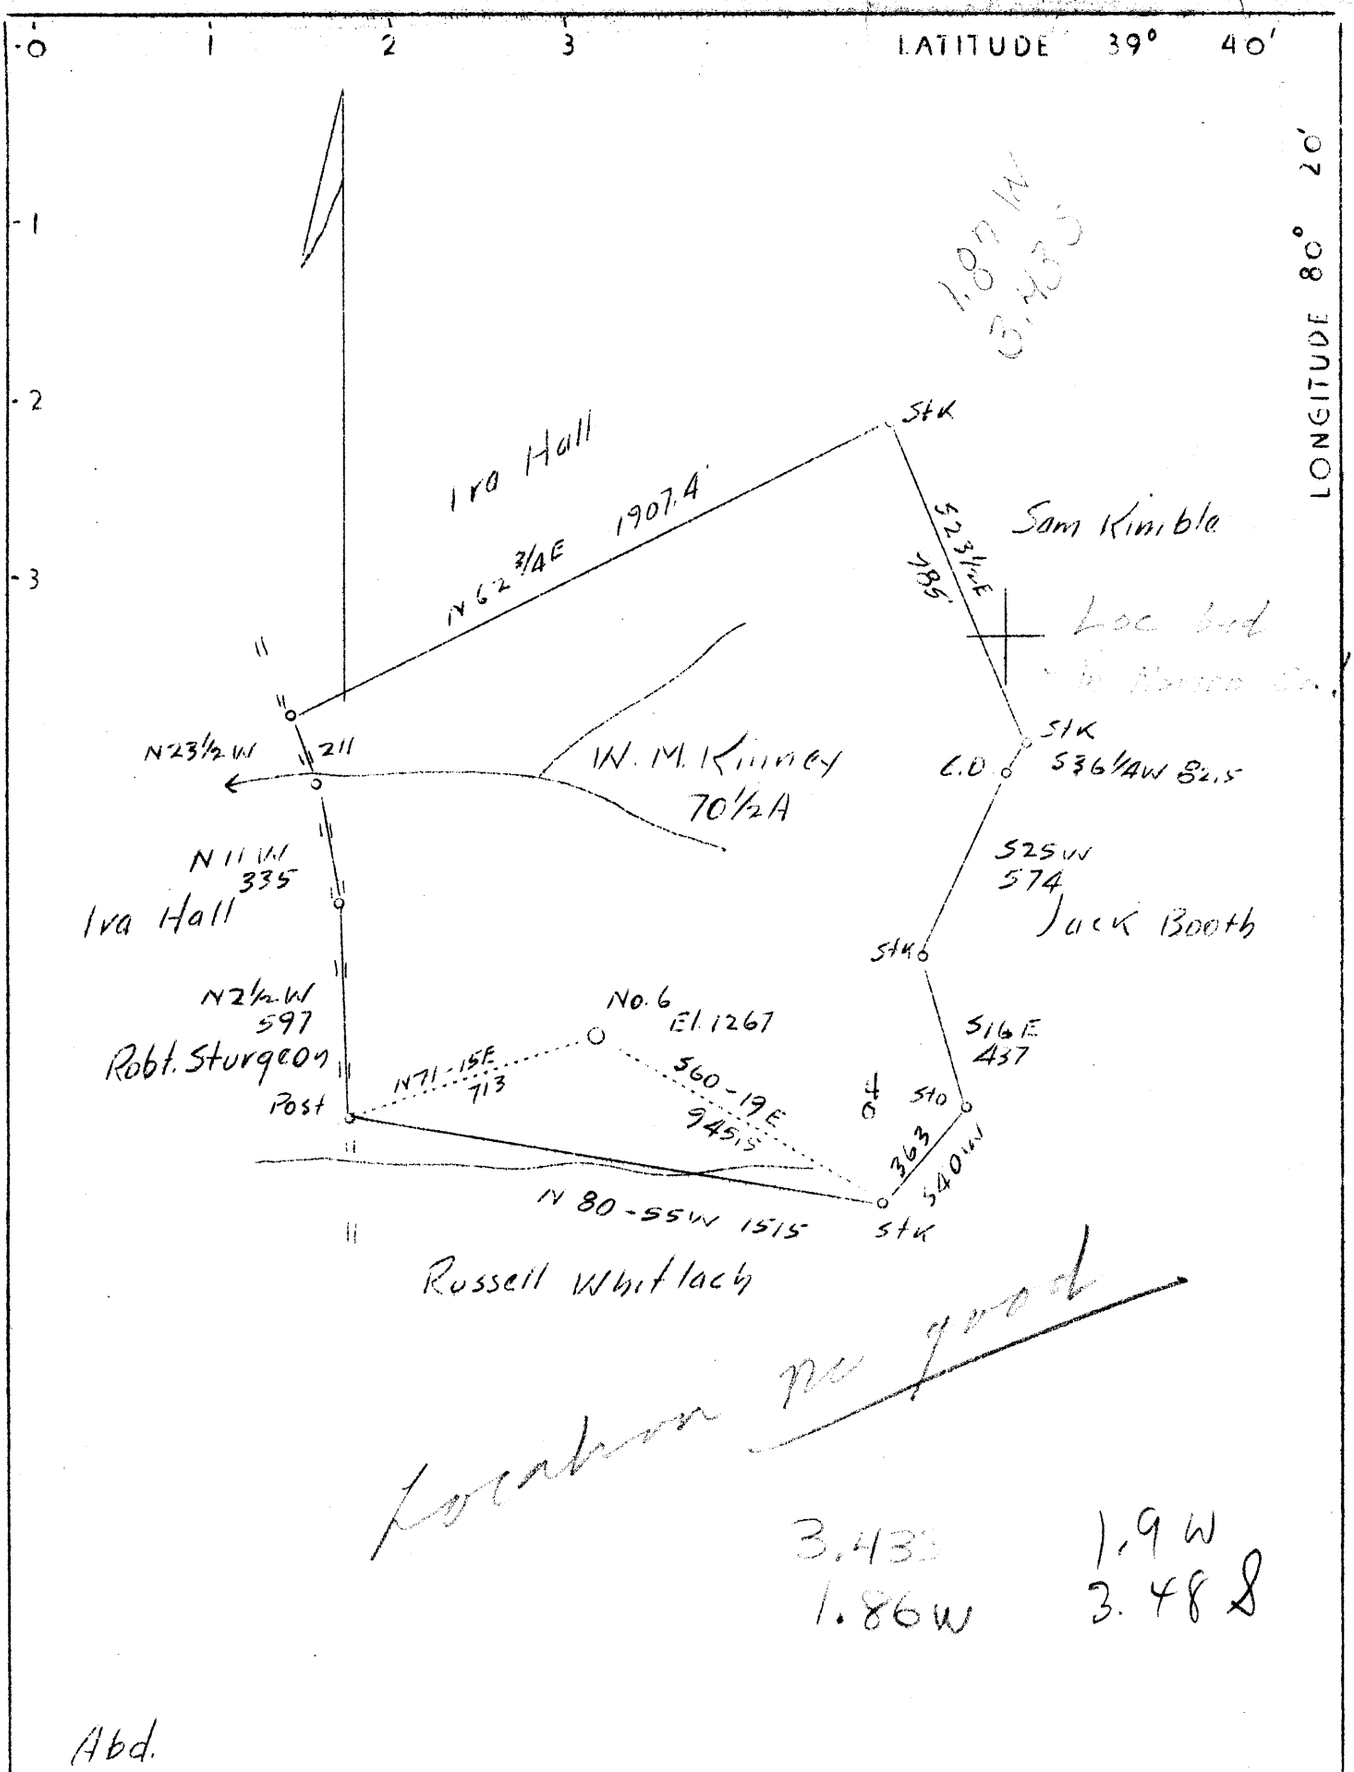

Company L.A.Dillinger

Address Waynesburg, Pa.

Farm W.M.Kinney

Tract One Acres 70½ Lease No.

Well (Farm) No. 6 Serial No. 586

Elevation (Spirit Level) 1267'

Quadrangle Mannington

County Monongalia District Battelle

Engineer A.L.Headley

Engineer's Registration No.

File No. Drawing No.

Date 11-12-1937 Scale 1"-500'

STATE OF WEST VIRGINIA
Department of Mines
OIL AND GAS DIVISION
CHARLESTON

WELL LOCATION MAP

File No. MON-170A

+ Denotes location of well on United States Topographic Maps., scale 1 to 62,500, latitude and longitude lines being represented by border lines as shown.

— Denotes one inch spaces on border line of original tracing.