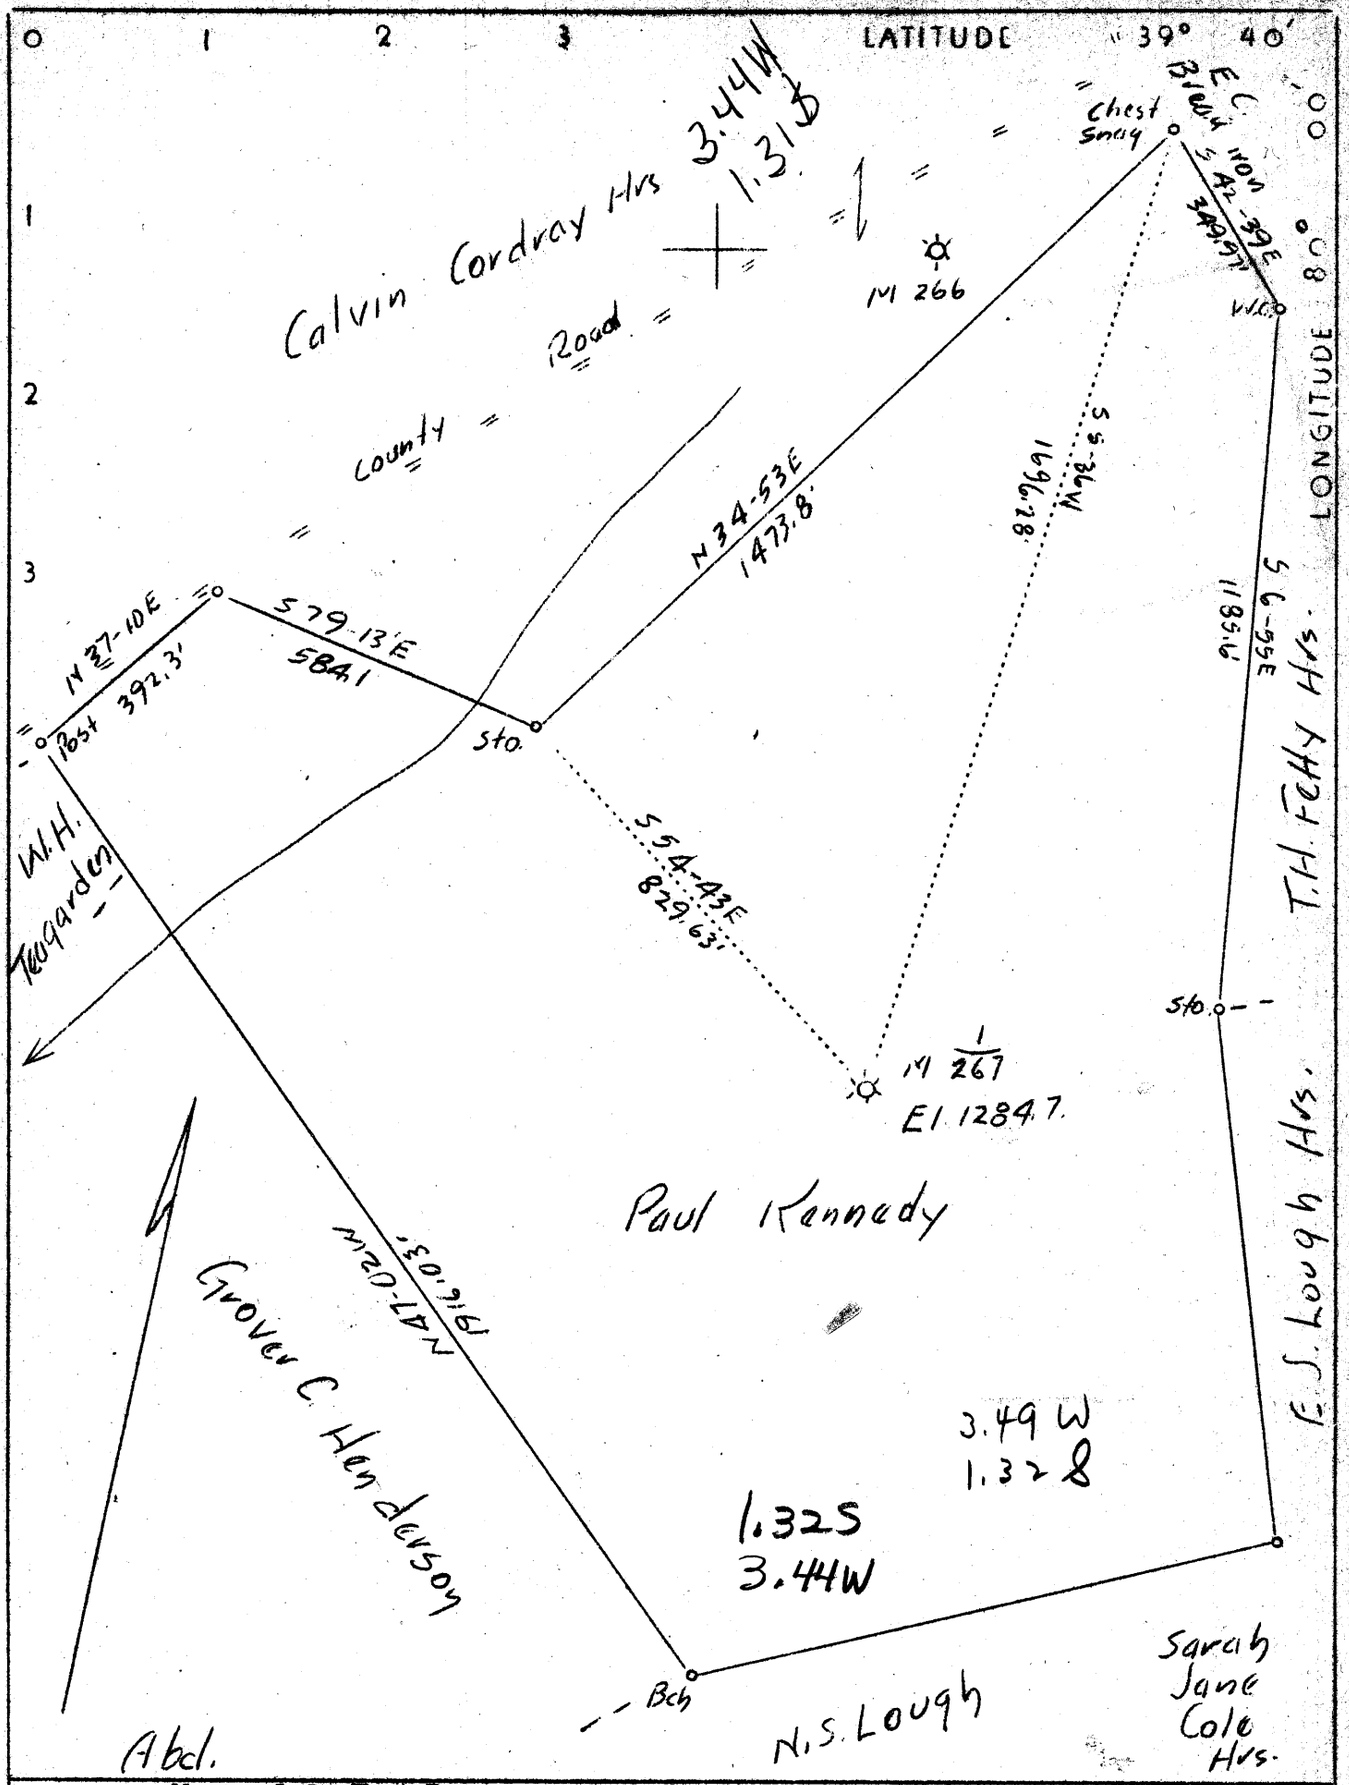

Monongahela West Penn
Company Public Service Co.
Address Fairmont, W.Va.
Farm J.Marshall Lough Hrs.
Tract 1 Acres 68.19 Lease No. 1010
Well (Farm) No. 1 Serial No. M-267
Elevation (Spirit Level) 1284.7'
Quadrangle Blacksville E.B.
County Monongalia District Grant
Engineer F.A.H.Kelley
Engineer's Registration No. 695
File No. Drawing No. B-113037-G
Date 11/30/37 Scale 1"-300'

STATE OF WEST VIRGINIA
Department of Mines
OIL AND GAS DIVISION
CHARLESTON

WELL LOCATION MAP

File No. MON-173A

+ Denotes location of well on United States Topographic Maps, scale 1 to 62,500, latitude and longitude lines being represented by border lines as shown.

— Denotes one inch spaces on border line of original tracing.