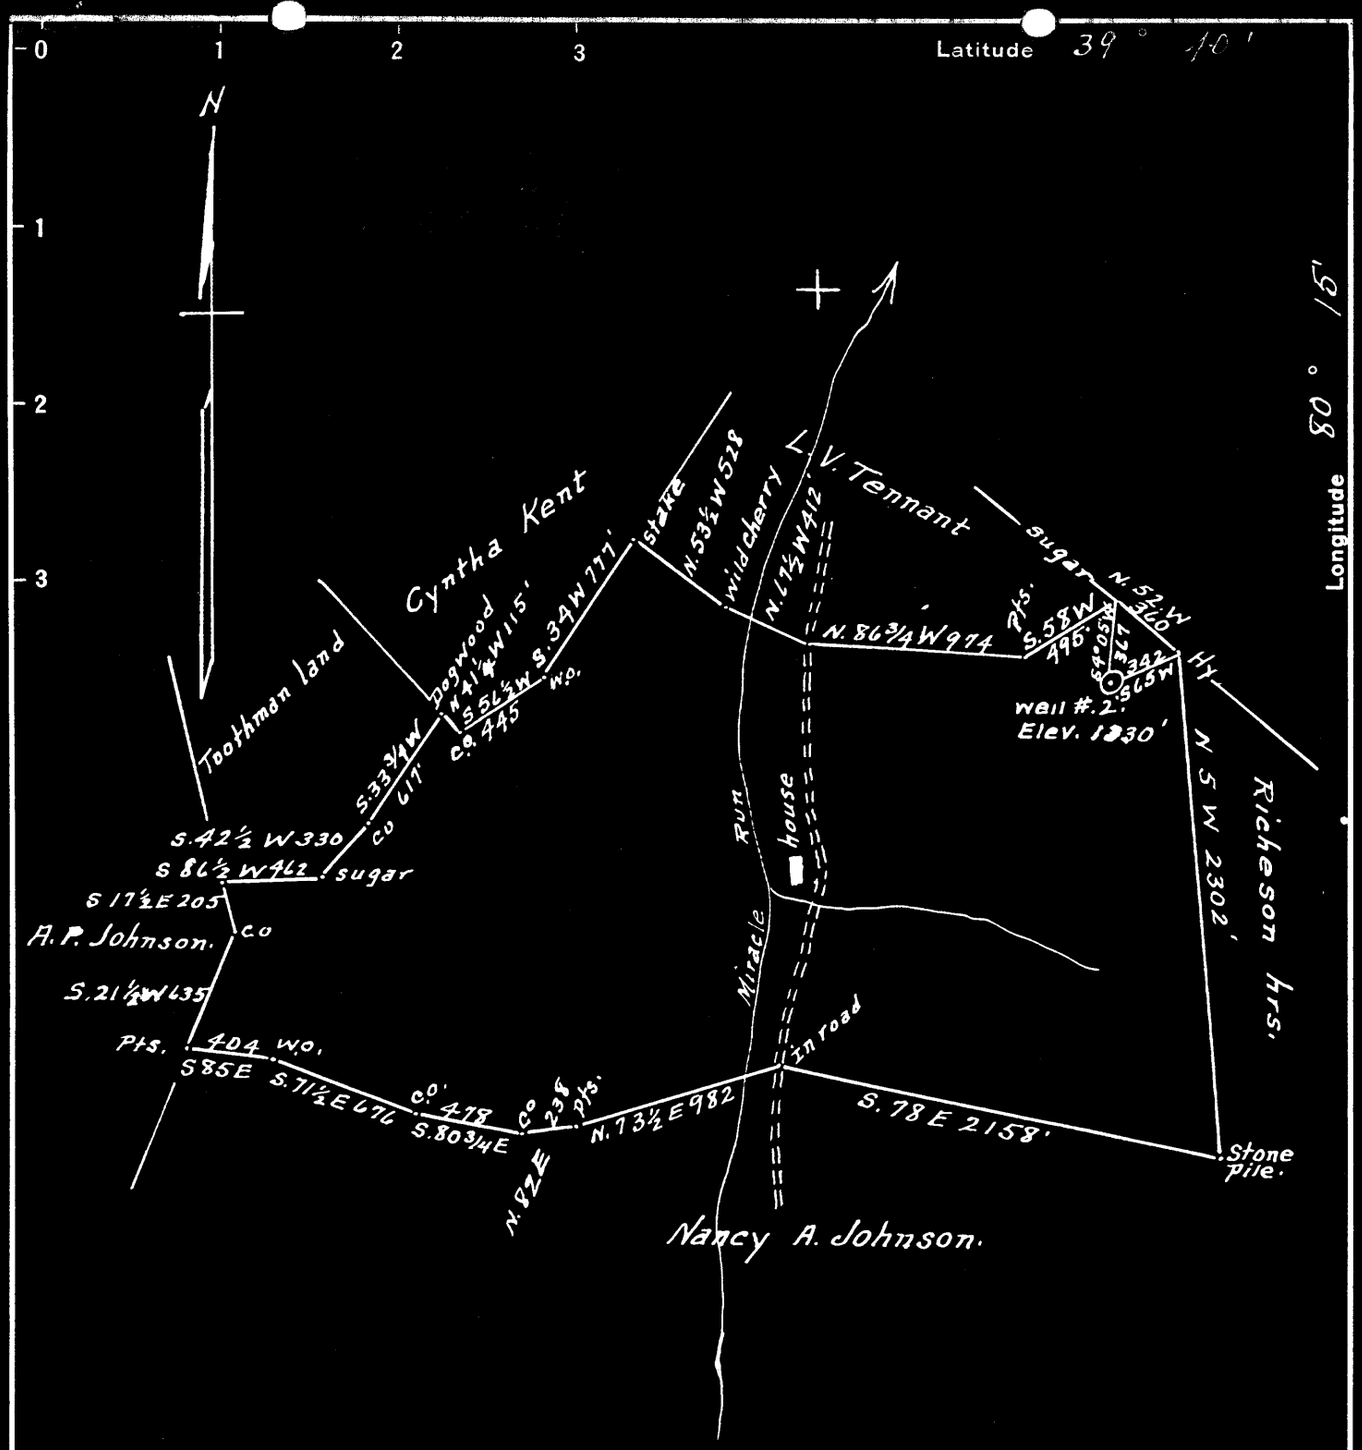

Surface = Flossie Haught
R.#1. Wadestown W.Va.
Coal = Wheeling Dollar Savings & Trust Co. Trustee
Wheeling W.Va.

S 1.51
W 3.00

New Location ☐
Drill Deeper ☐
Abandonment ☒

Company Dunn-Mar Oil & Gas Co
Address Waynesburg Pa.
Farm F. M. Efaw
Tract 1 Acres 197+ Lease No.
Well (Farm) No. 2 Serial No. 553
Elevation (Spirit Level) 1330
Quadrangle Mannington
County Monongalia District Battelle.
Engineer A. L. Headley
Engineer's Registration No. 2021
File No. Drawing No.
Date 4-5-1950 Scale 1" = 800'

STATE OF WEST VIRGINIA
DEPARTMENT OF MINES
OIL AND GAS DIVISION
CHARLESTON

WELL LOCATION MAP

FILE NO. MON-474-A-2

+ Denotes location of well on United States Topographic Maps, scale 1 to 62,500, latitude and longitude lines being represented by border lines as shown.

— Denotes one inch spaces on border line of original tracing.

"IMPERIAL" TRACING CLOTH
K & E CO., N. Y.

1080
30
1110 8¼" pulled 620 feet

STATE OF WEST VIRGINIA
DEPARTMENT OF MINES
OIL AND GAS DIVISION

WELL RECORD

Permit No. MON-474-OC

Oil or Gas Well (KIND)

Company Dunn-Mar Oil & Gas Company
Address Waynesburg, Pa.
Farm F. M. Efaw Acres
Location (waters) Miracle Run
Well No. 2 Elev. 1330
District Battelle County Monongalia
The surface of tract is owned in fee by Flossie Haught
Address Wadestown, W. Va.
Mineral rights are owned by Union Gas & Oil Co.
Address Washington, Pa.
Drilling commenced May 27, 1908
Drilling completed Sept. 21, 1908
Date Shot No data From To
With
Open Flow /10ths Water in Inch
/10ths Merc. in Inch
Volume Cu. Ft.
Rock Pressure lbs. hrs.
Oil bbls., 1st 24 hrs.
Fresh water feet feet
Salt water feet feet

Casing and Tubing	Used in Drilling	Left in Well	Packers
Size			
16			Kind of Packer
13			
10	~~1626~~		Size of
8¼	1000	1000	
6⅝	2328		Depth set
5 3/16	2520	2520	
3			Perf. top
2	3348	3348	Perf. bottom
Liners Used			Perf. top
			Perf. bottom

CASING CEMENTED SIZE No. Ft. Date

COAL WAS ENCOUNTERED AT 1080 FEET INCHES
FEET INCHES FEET INCHES
FEET INCHES FEET INCHES

Formation	Color	Hard or Soft	Top	Bottom	Oil, Gas or Water	Depth Found	Remarks
Pgh. Coal	Black	Soft	1080	1088			
Dunkard	Grey	Hard	1425	1450			
Gas Sand	Grey	Hard	1767	1868			
Big Injun	Grey	Hard	2386	2534			
Gordon	Grey	Hard	3286	3322			
4th. Sand	Grey	Hard	3328	3348	Oil	3306	

1080
30
1110

JUL 1950
WEST VIRGINIA
DEPARTMENT OF MINES

(Over)

FEB 28 1951