



West Virginia Department of Environmental Protection
Office of Oil and Gas

WELL LOCATION FORM: GPS

API: 47-067-00512 WELL NO.: B-2

FARM NAME: Mower Lumber

RESPONSIBLE PARTY NAME: Mike Ross

COUNTY: Nicholas DISTRICT: Jefferson

QUADRANGLE: Summersville Dam

SURFACE OWNER: Young Life Inc.

ROYALTY OWNER: _____

UTM GPS NORTHING: ~~42303.633~~ 4230361

UTM GPS EASTING: ~~50221.44~~ 502215 GPS ELEVATION: 1570'

The Responsible Party named above has chosen to submit GPS coordinates in lieu of preparing a new well location plat for a plugging permit or assigned API number on the above well. The Office of Oil and Gas will not accept GPS coordinates that do not meet the following requirements:

1. Datum: NAD 1983, Zone: 17 North, Coordinate Units: meters, Altitude: height above mean sea level (MSL) – meters.
2. Accuracy to Datum – 3.05 meters
3. Data Collection Method:

Survey grade GPS _____: Post Processed Differential _____

Real-Time Differential _____

Mapping Grade GPS _____: Post Processed Differential _____

Real-Time Differential _____



4. **Letter size copy of the topography map showing the well location.**

I the undersigned, hereby certify this data is correct to the best of my knowledge and belief and shows all the information required by law and the regulations issued and prescribed by the Office of Oil and Gas.

Mike Ross
Signature

President
Title

Aug. 25, 2022
Date

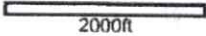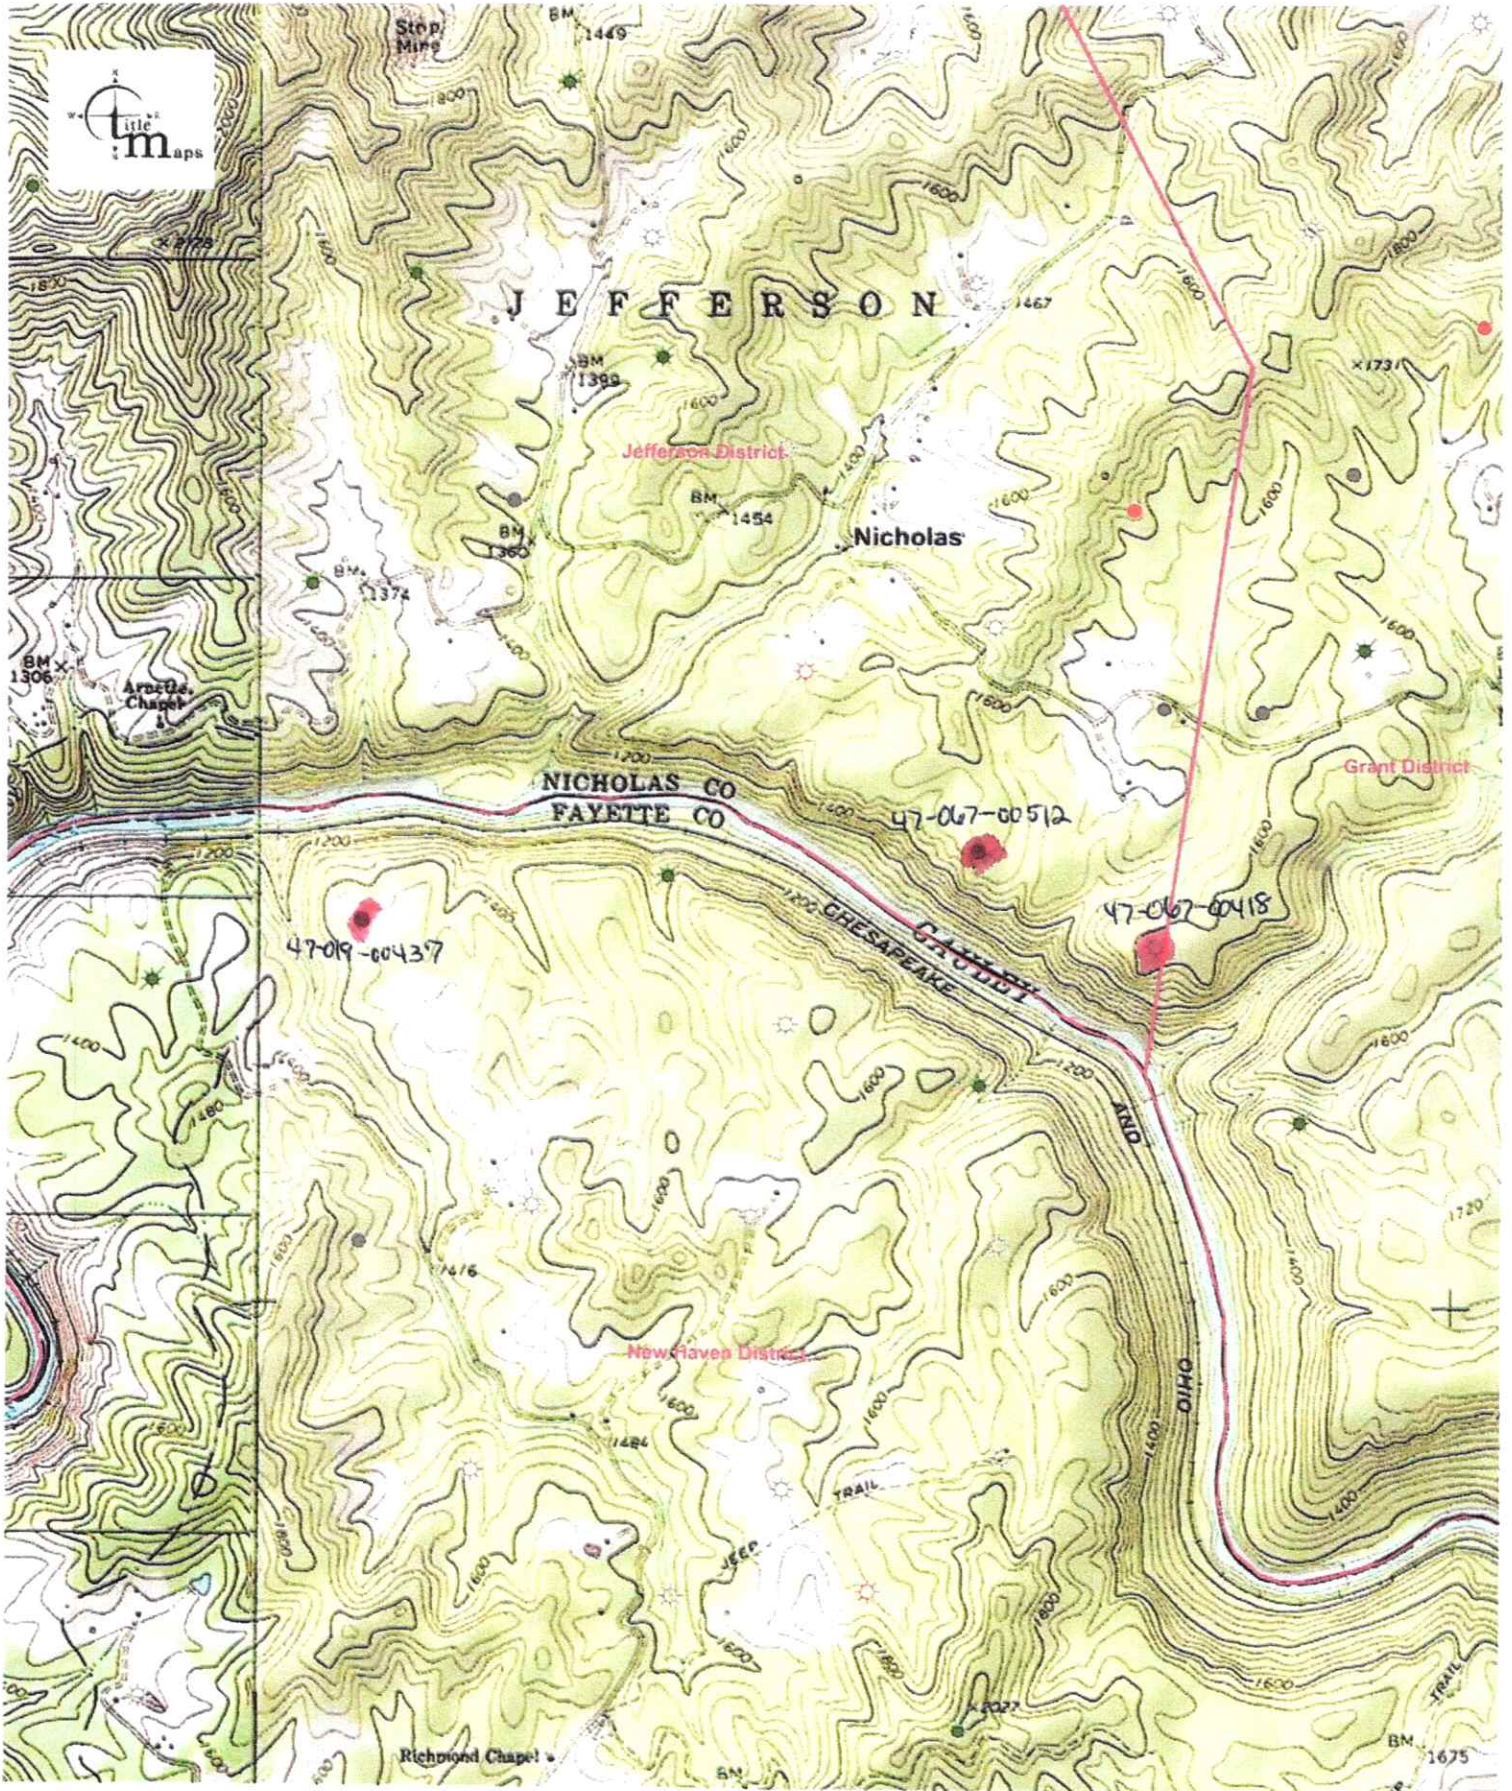

Approximate Scale 1:24,000

08/09/2022 - 12:56:03 PM

Disclaimer: The map information shown is for informational purposes only and does not constitute a land survey or legal depiction of the property or information shown. Title Maps LLC does not warrant the accuracy or correctness of the map information shown hereon.

09/30/2022