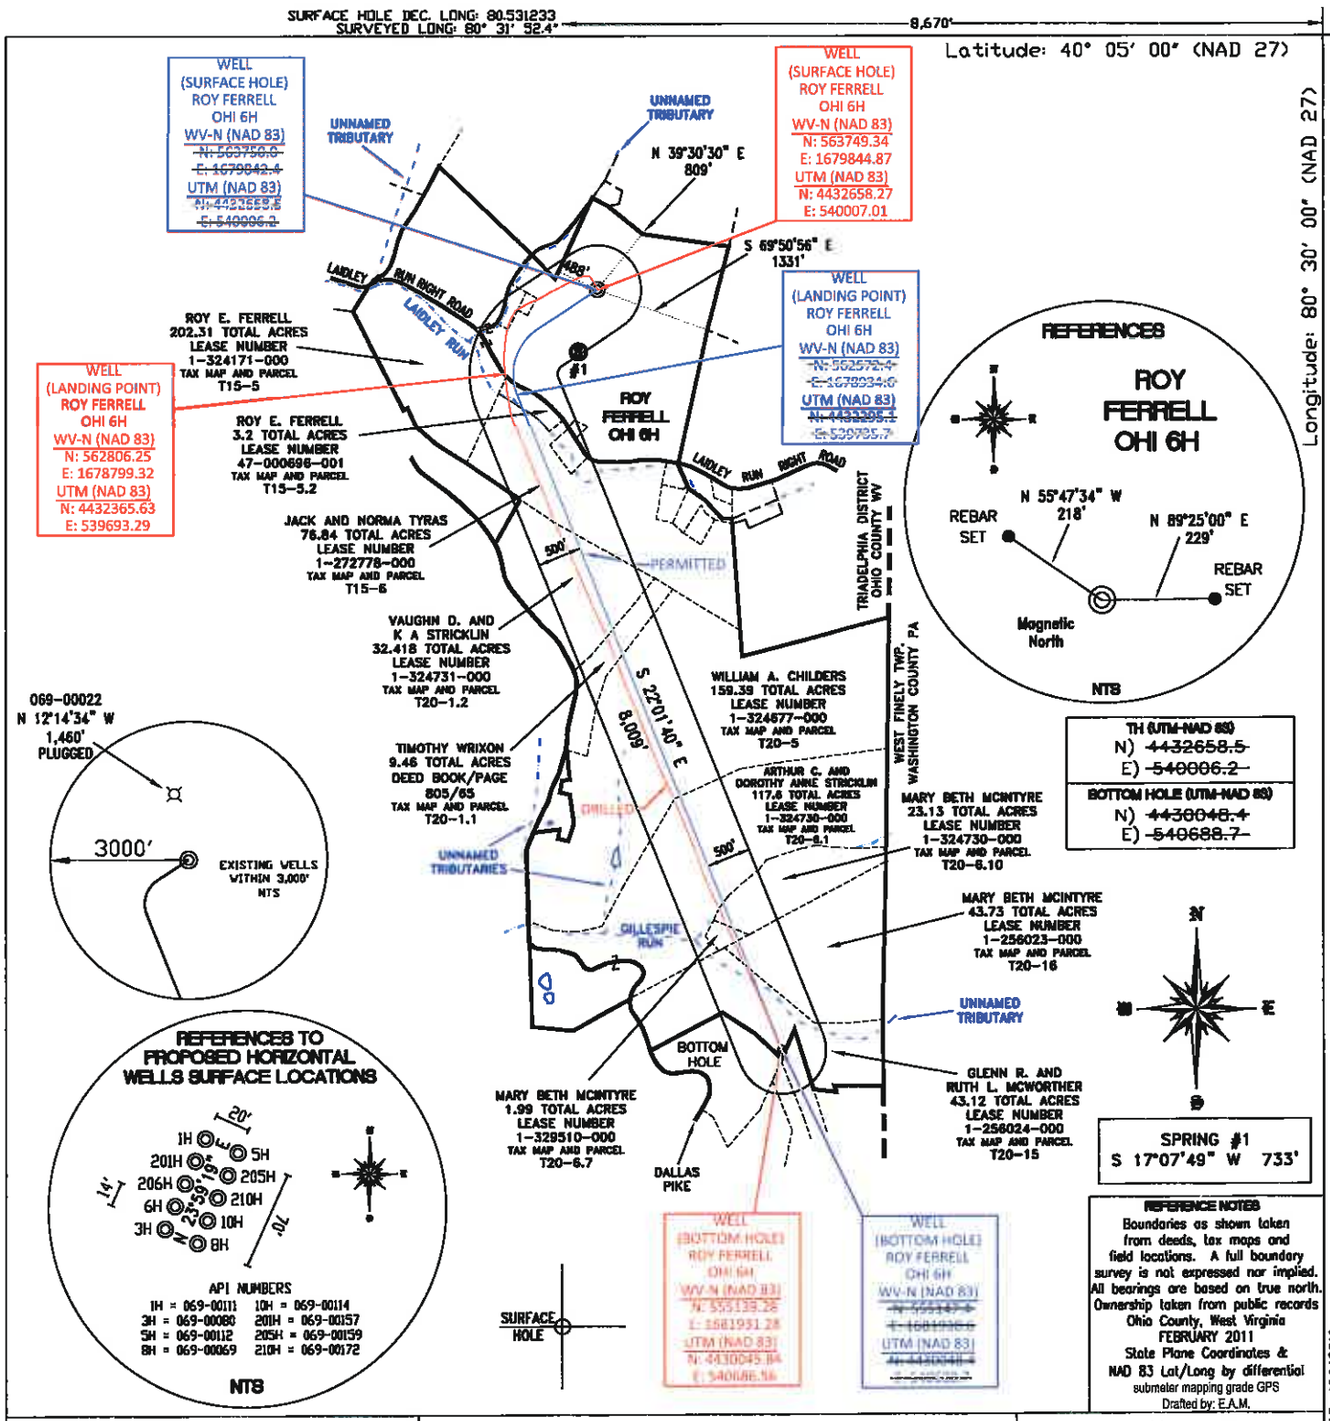

FILE #: CHE 034

DRAWING #: 1855

SCALE: PLAT = 1" - 2000' TICK MARK = 1" - 2000'

MINIMUM DEGREE OF ACCURACY: 1/200

PROVEN SOURCE OF ELEVATION: SUBMETER MAPPING GRADE GPS

I, THE UNDERSIGNED, HEREBY CERTIFY THAT THIS PLAT IS CORRECT TO THE BEST OF MY KNOWLEDGE AND BELIEF AND SHOWS ALL THE INFORMATION REQUIRED BY LAW AND THE REGULATIONS ISSUED AND PRESCRIBED BY THE DEPARTMENT OF ENVIRONMENTAL PROTECTION.

Signed: _____

L.L.S. #2124 : Ernest J. Benchek III

ERNEST J. BENCHEK III LICENSED No. 2124 STATE OF WEST VIRGINIA PROFESSIONAL SURVEYOR

(+) DENOTES LOCATION OF WELL ON UNITED STATES TOPOGRAPHIC MAPS

WVDEP
OFFICE OF OIL & GAS
601 57TH STREET
CHARLESTON, WV 25304

DATE: MAY 10, 2016

OPERATOR'S WELL #: ROY FERRELL OHI 6H AS-DRILLED

API WELL #: 47 (STATE) 69 (COUNTY) 00176 (PERMIT)

Well Type: ☐ Oil ☐ Waste Diposal ☐ Production ☐ Deep
☒ Gas ☐ Liquid Injection ☐ Storage ☒ Shallow

AS-BUILT
ELEVATION : 1196.0'

WATERSHED: WHEELING CREEK

COUNTY/DISTRICT: OHIO/TRIADELPHIA

QUADRANGLE: VALLEY GROVE WV.

SURFACE OWNER: ROY E. FERRELL

ACREAGE: 202.31 +/-

OIL & GAS ROYALTY OWNER: ROY E. FERRELL

ACREAGE: 581.28 +/-

10/28/2016

LEASE NUMBERS: _____

DRILL ☒ CONVERT ☐ DRILL DEEPER ☐ REDRILL ☐ FRACTURE OR STIMULATE ☒
PLUG OFF FORMATION ☐ PERFORATE NEW FORMATION ☐ PLUG & ABANDON ☐
CLEAN OUT & REPLUG ☐ OTHER CHANGE ☐ (SPECIFY):

TARGET FORMATION: MARCELLUS

AS-DRILLED DEPTH: TVD: 6,748.552' TMD: 15,495'

WELL OPERATOR : CHESAPEAKE APPALACHIA, LLC.

DESIGNATED AGENT : JESSICA GREATHOUSE

ADDRESS: PO BOX 18496

ADDRESS: Po Box 6070

CITY: OKLAHOMA CITY STATE: OK ZIP CODE: 73154-0496

CITY: CHARLESTON STATE: WV ZIP CODE: 25301