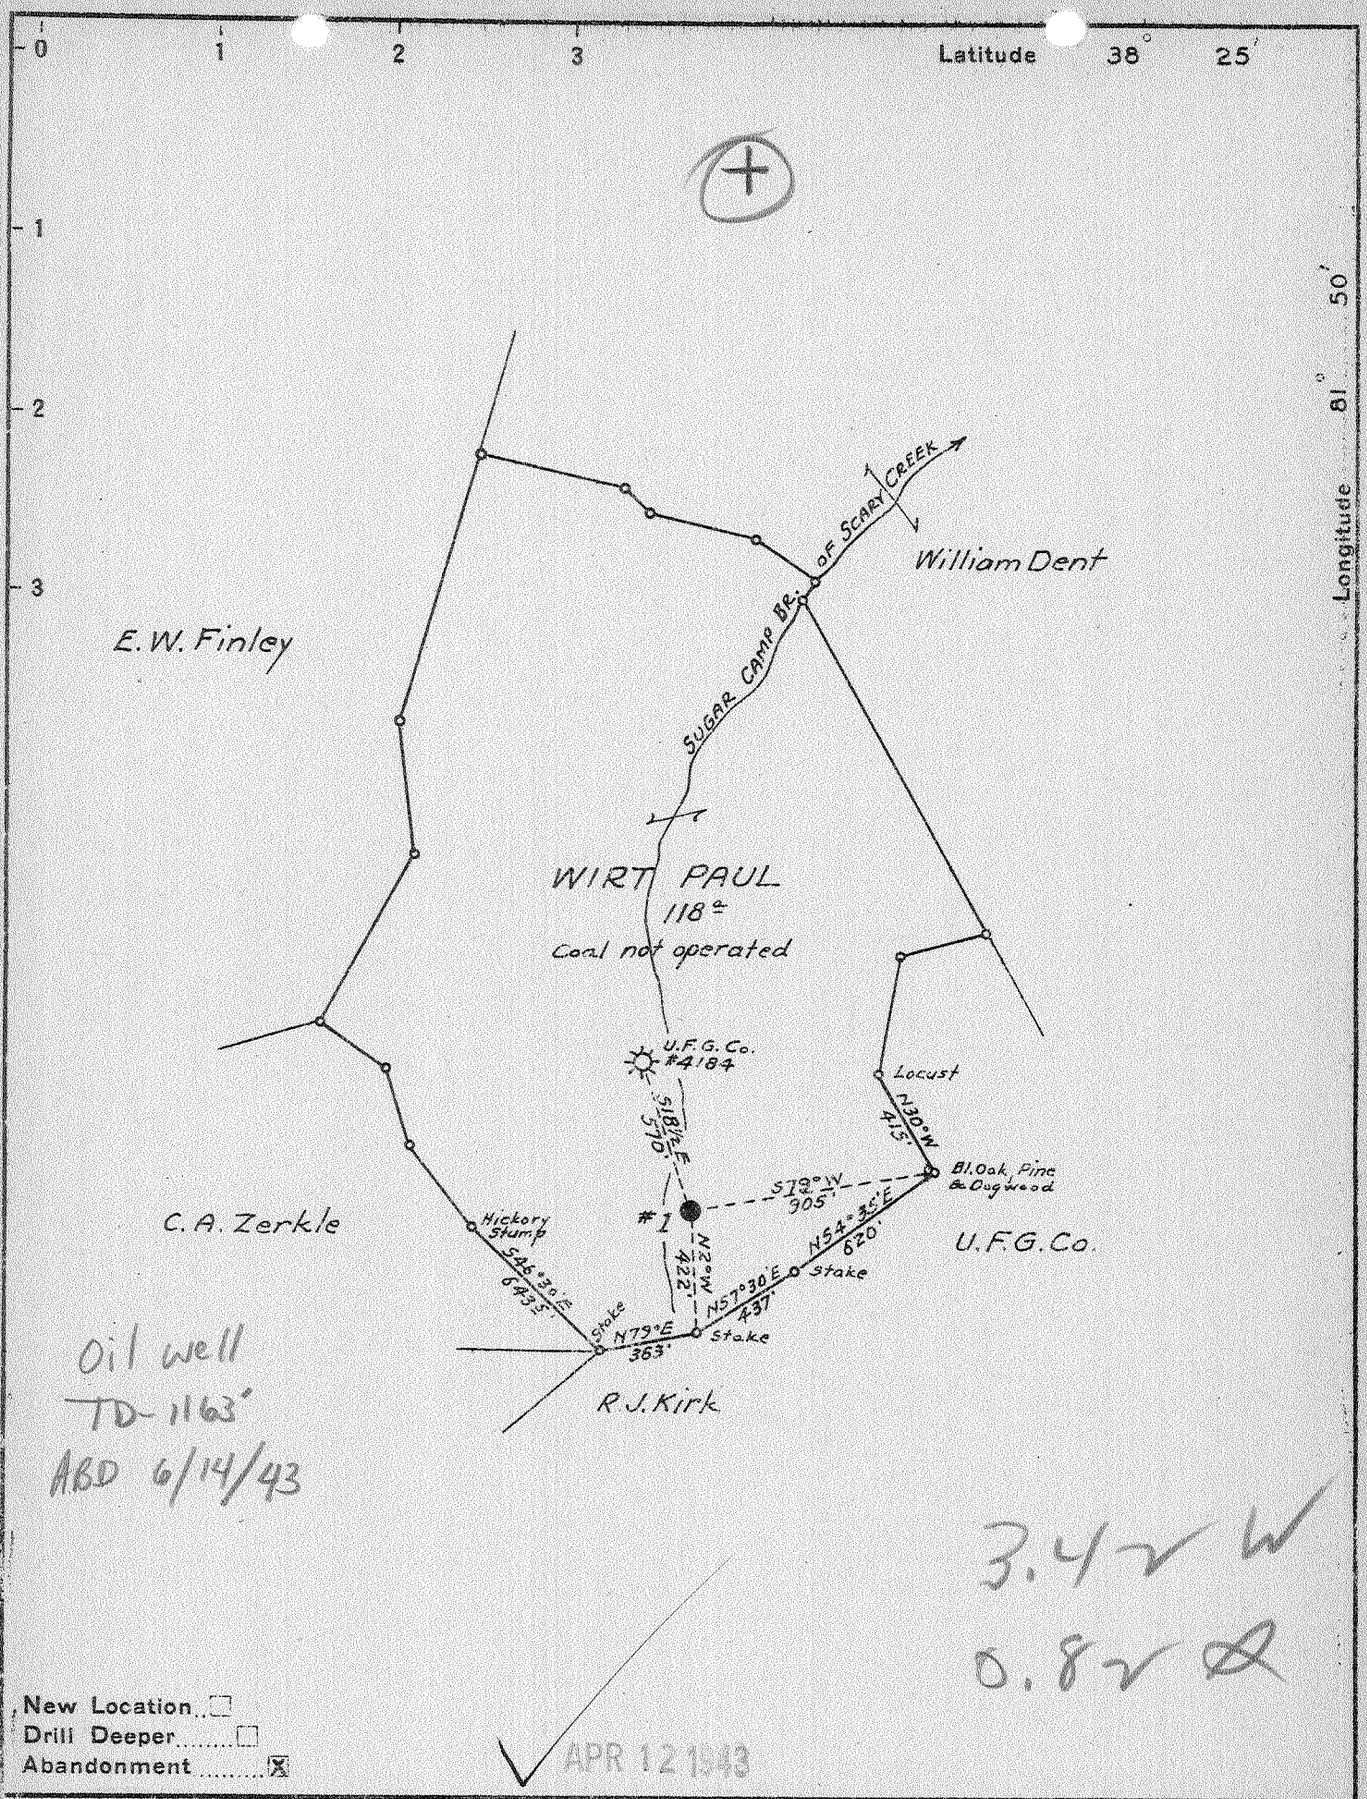

Company D.H. BLAND & GLENN TOMPKINS

Address CHARLESTON, W.VA.

Farm WIRT PAUL

Tract _____ Acres 118 Lease No. _____

Well (Farm) No. 1 Serial No. _____

Elevation ~~(Spirit Level)~~ 880 BAROMETER

Quadrangle SAINT ALBANS

County PUTNAM District SCOTT

Engineer [illegible]

Engineer's Registration No. 659

File No. _____ Drawing No. _____

Date MAR. 25, 1943 Scale 1" = 660

STATE OF WEST VIRGINIA
DEPARTMENT OF MINES
OIL AND GAS DIVISION
CHARLESTON

WELL LOCATION MAP

FILE NO. PUT-61-A

+ Denotes location of well on United States Topographic Maps, scale 1 to 62,500, latitude and longitude lines being represented by border lines as shown.

— Denotes one inch spaces on border line of original tracing.

"IMPERIAL" TRACING CLOTH
K & E CO., N. Y.

~~Buffalo St. Albans~~ Scott Depot (2)

WIRT PAUL NO. 1 — D.H. BLAND & GLENN TOMPKINS — PUT-61-A