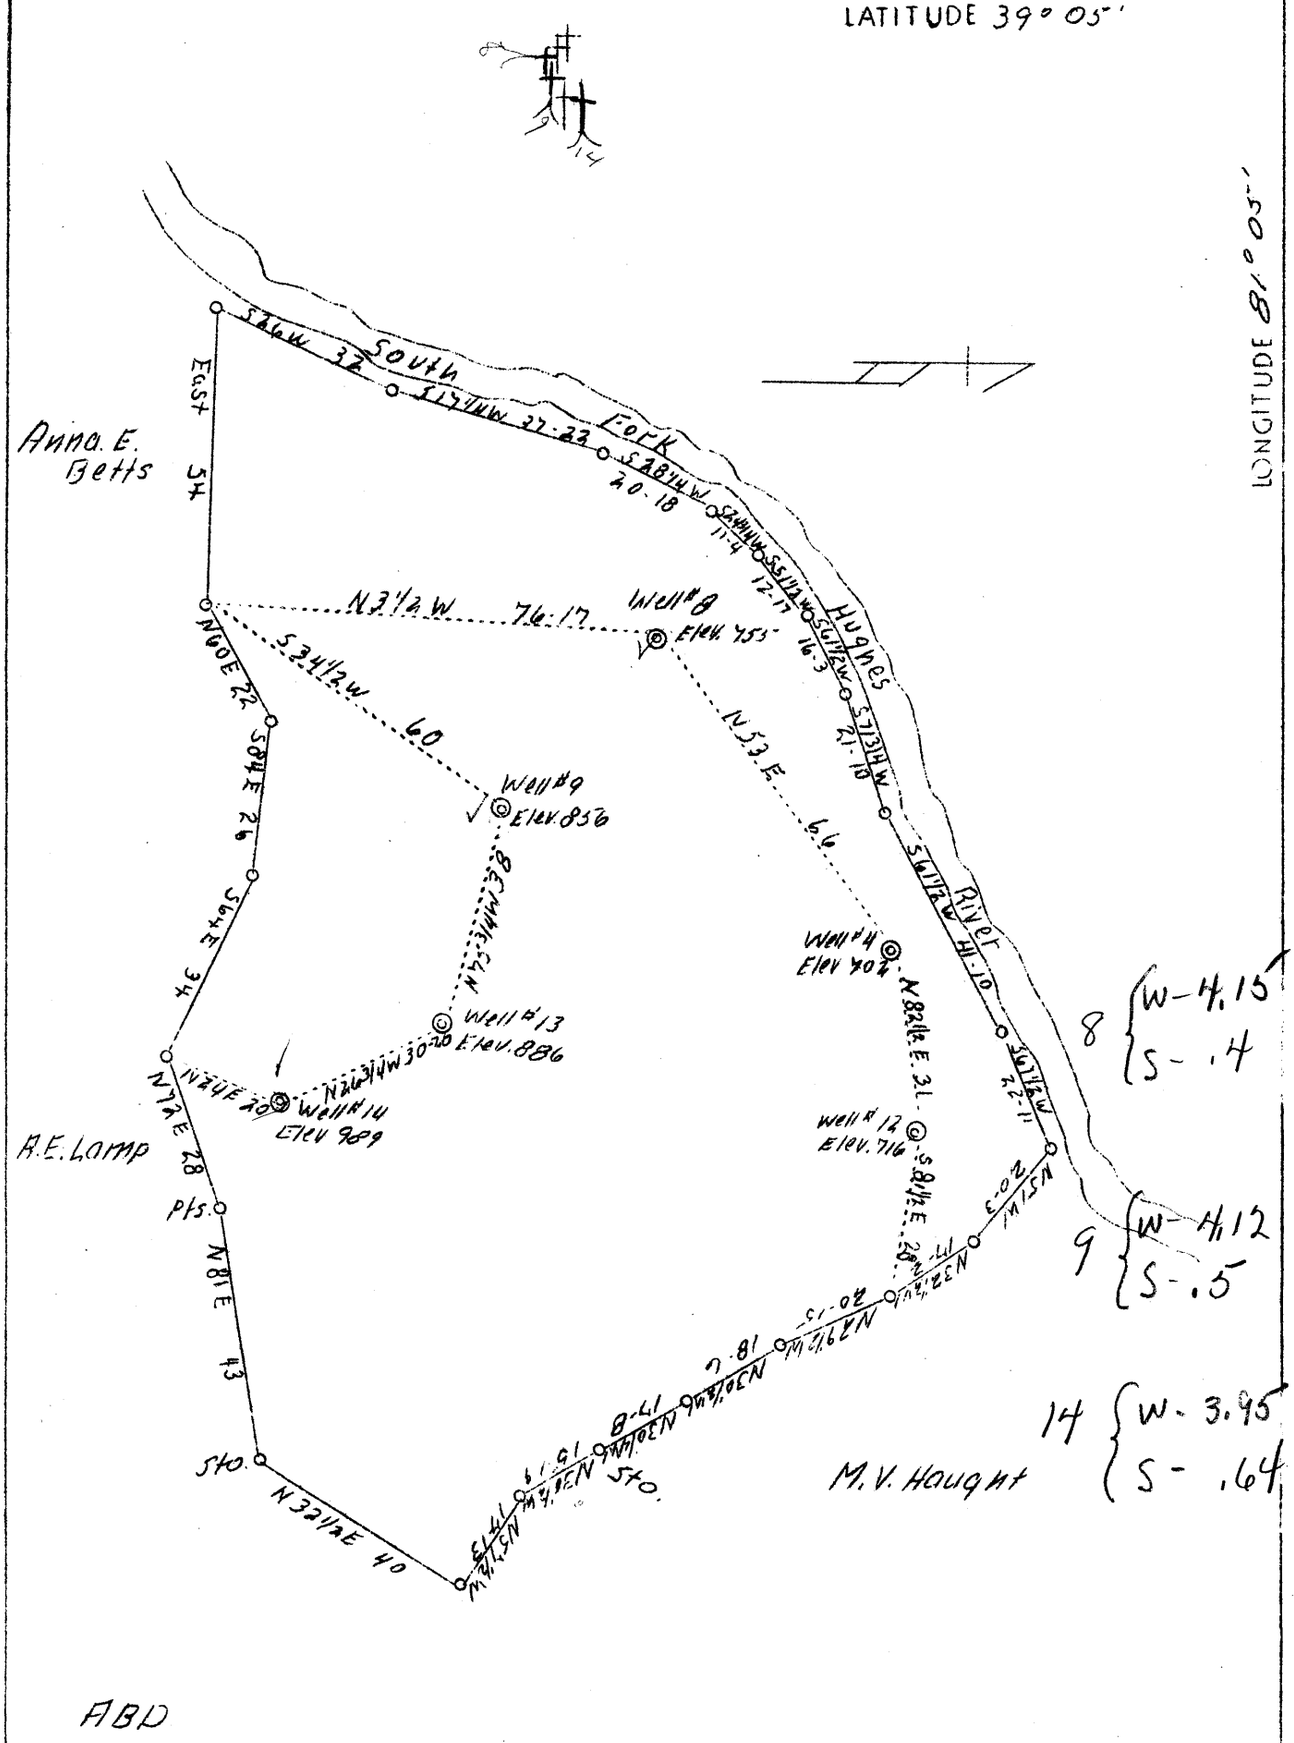

ABD

Company	W. R. Baker
Address	Beatrice, W. Va.
Farm	A. E. Lamp
Acres	169
Well (Farm) No.	4-8-9-12-13-14
Elevation (SL)	#4-702, #8-755, #9-856, #12-716, #13-886, #14-989
Quadrangle	Harrisville S
County	Ritchie
District	Murphy
Engineer	A. K. Westfall
Eng. Reg. No.	Deputy County Surveyor
Date	Sept. 5, 1939
Scale	1" - 30 poles

STATE OF WEST VIRGINIA
Department of Mines
OIL & GAS DIVISION
Charleston

WELL LOCATION MAP

File No. Rit-421-422-423-A
Well # 8 - 9 - 14

x Denotes location of well on U. S. Topographic Maps, scale 1 to 62,500, latitude and longitude lines being represented by border lines as shown.

- Denotes one inch spaces on border line of original tracing.

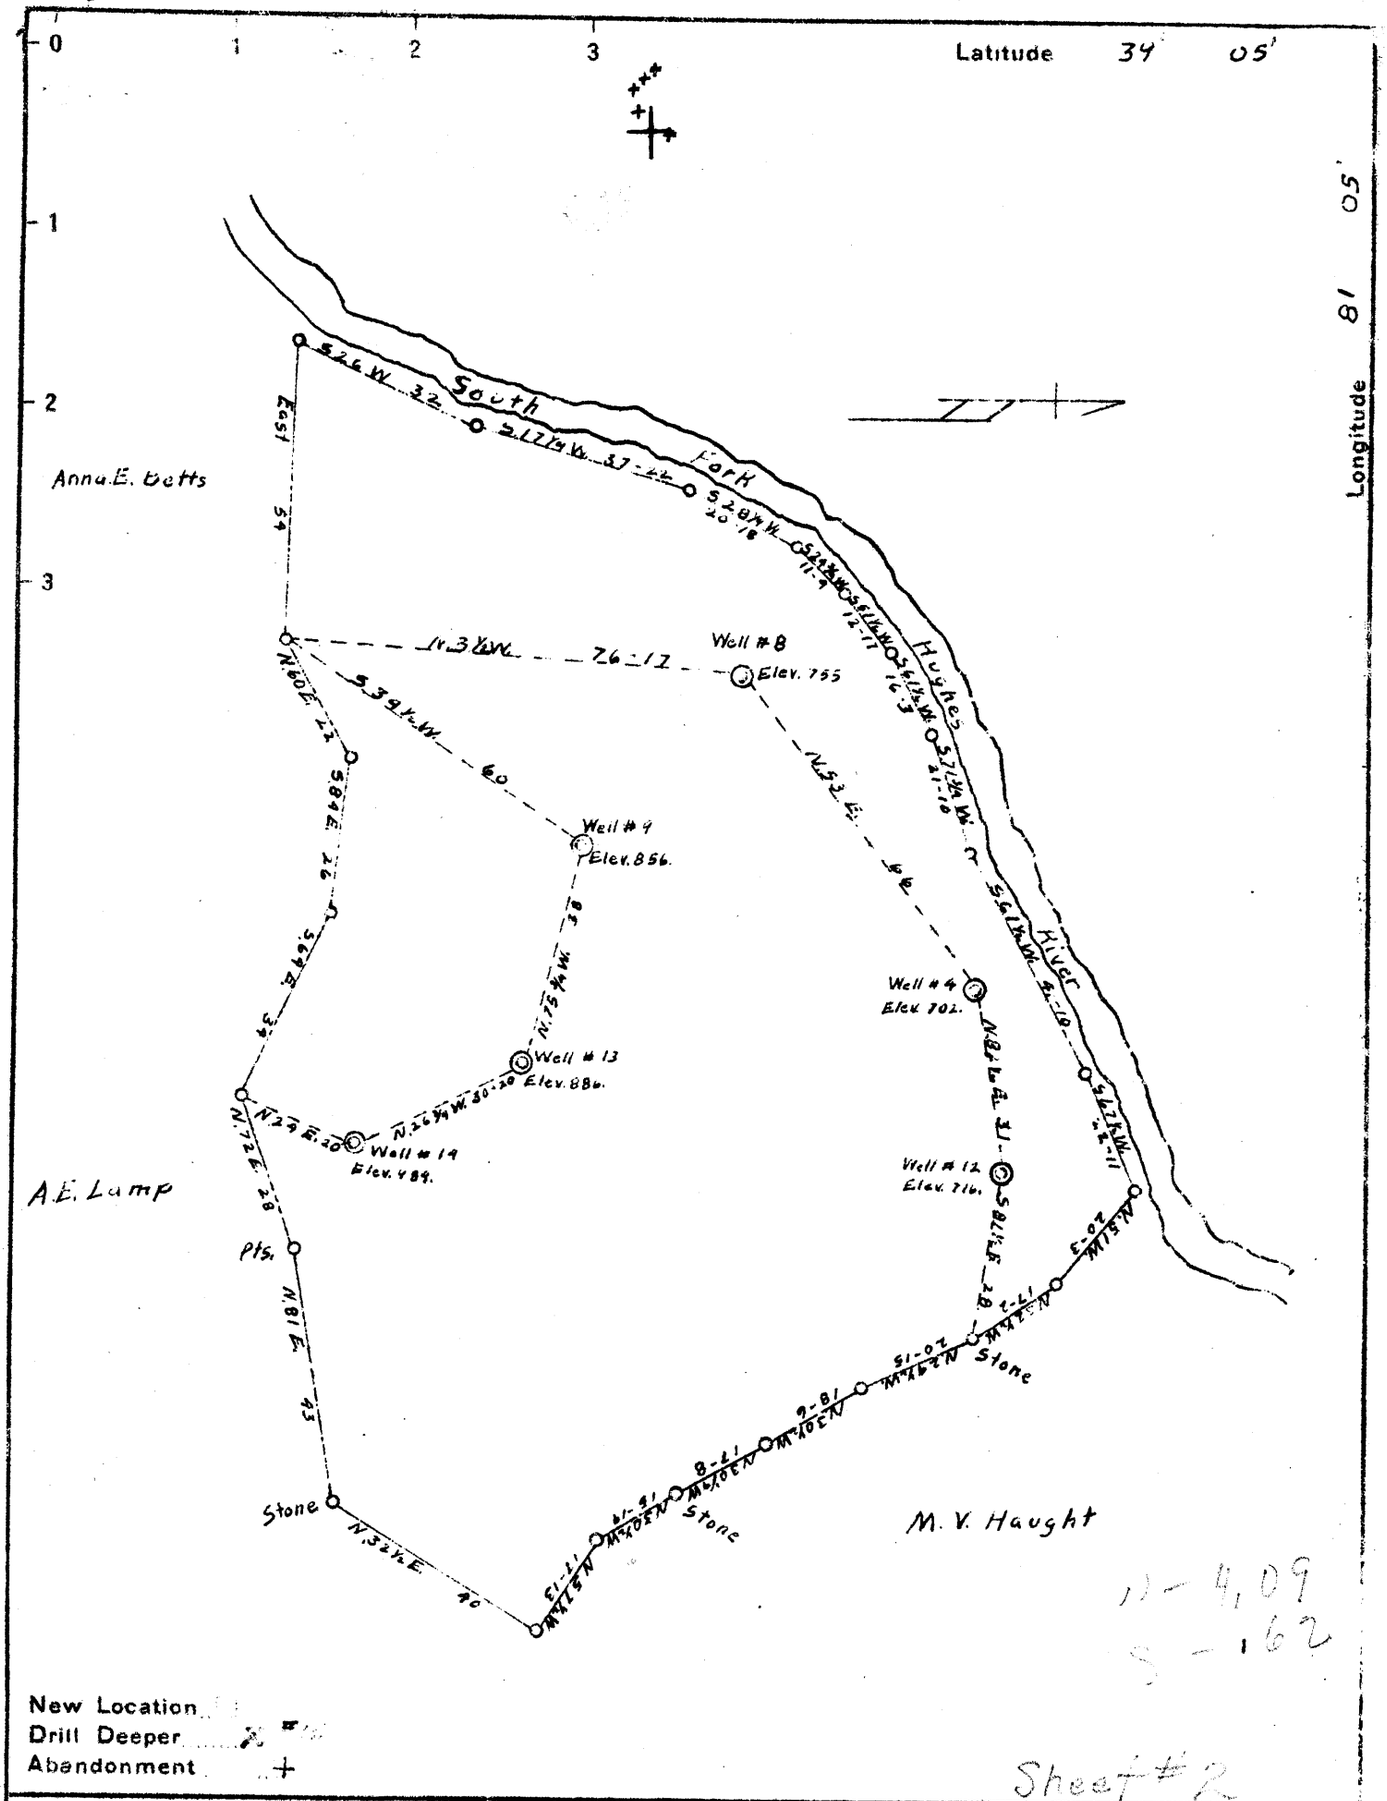

New Location
Drill Deeper
Abandonment +

Sheet #2

Company W.R. Baker
Address Beatrice W.Va.
Farm A.E. Lamp
Tract _____ Acres 169 Lease No. _____
Well (Farm) No. 4-8-9-12-13-19 Serial No. _____
Elevation (Spirit Level #4-702, #8-755, #9-856, #12-716, #13-886, #14-989.
Quadrangle Harrisville S
County Ritchie District Murphy
Engineer W.R. Westfall
Engineer's Registration No. Deputy County Surveyor
File No. _____ Drawing No. _____
Date Sep. 5 1969 Scale 1" = 50 Poles

STATE OF WEST VIRGINIA
DEPARTMENT OF MINES
OIL AND GAS DIVISION
CHARLESTON

WELL LOCATION MAP

FILE NO. RIT-421-422-423-A
~~RIT-833~~ 13

+ Denotes location of ~~well on~~ WELL United States Topographic Maps, scale 1 to 62,500, latitude and longitude lines being represented by border lines as shown.

— Denotes one inch spaces on border line of original tracing.