1 2 3 LATITUDE 38° 55'

LONGITUDE 80° 20'

1

2

3

1,265
1.05W

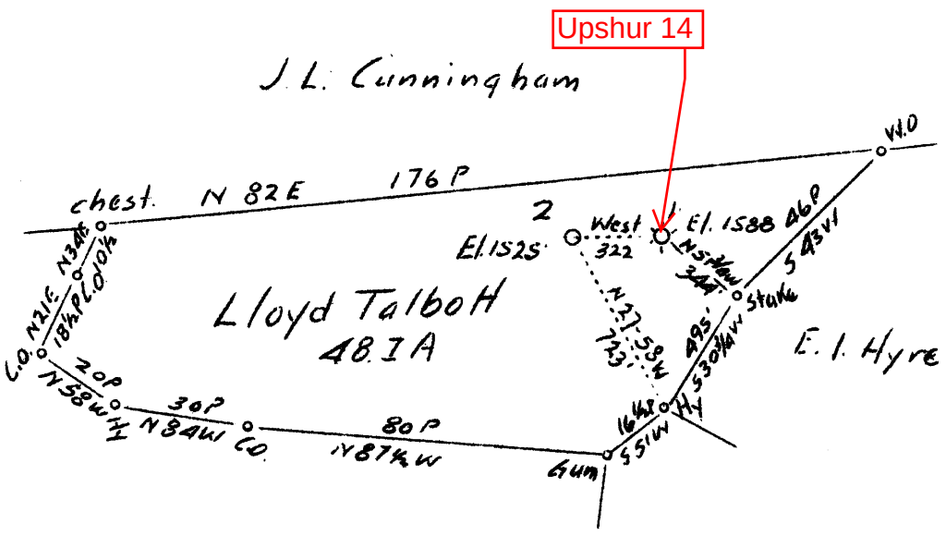

1,06W
1.27R

7.5' loc
1.23S 38°55'
0.9W 80 20

Company Union Gas Corporation
Address Covington, Ky
Farm Lloyd Talbott
Tract 1 Acres 48.70 Lease No.
Well(Farm) No. ~~2~~ 1 Serial No. ~~No.~~
Elevation (Spirit Level) 1525
Quadrangle Crawford
County Upshur District Meade
Engineer S. H. Bradley
Engineer's Registration No. 135
Date ~~11-21-36~~ Scale 1" = ~~40 Po.~~
File No. Drawing No.

STATE OF WEST VIRGINIA
Department of Mines
OIL And GAS DIVISION
Charleston

WELL LOCATION MAP

File No. ~~WP-61~~ ~~WCS 09-7-78~~

+ Denotes location of well on U. S. Topographic Maps, scale 1 to 62,500 latitude and longitude lines being represented by border lines as shown

— Denotes one inch spaces on border line of original tracing.

6-6 258