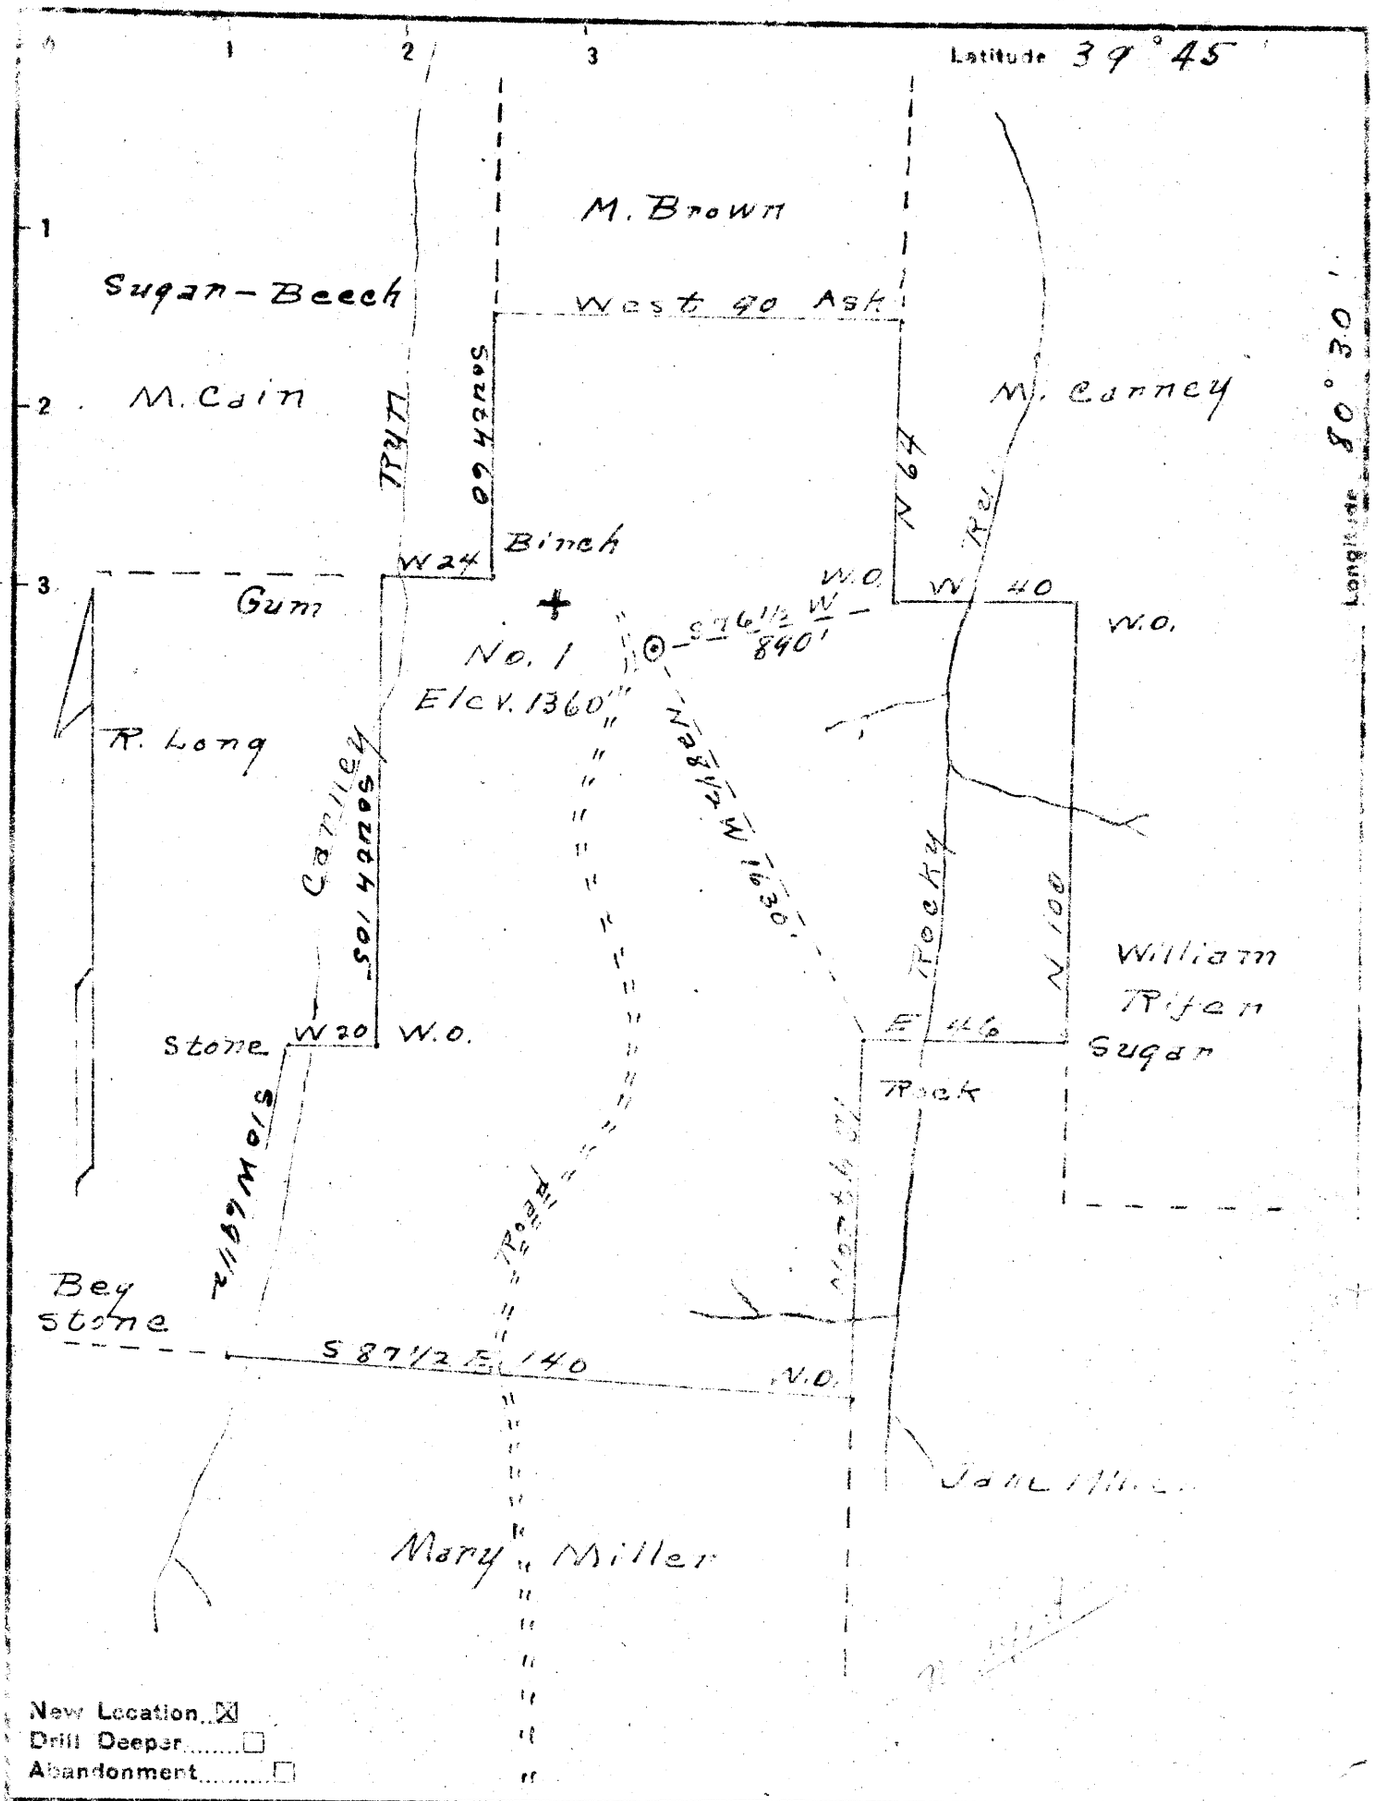

Company Associated Investors Oil and Gas Syndicate, Inc.

Address Pittsburgh, Pa.

Farm G. W. Knapp

Tract ____ Acres 226 Lease No. ____

Well (Farm) No. 1 Serial No. ____

Elevation (Spirit Level) 1360'

Quadrangle Littleton

County Wetzel District Center

Engineer Wendell W. Morris

Engineer's Registration No. 1653

File No. ____ Drawing No. ____

Date 11-30-48 Scale 1" = 40 poles

STATE OF WEST VIRGINIA
DEPARTMENT OF MINES
OIL AND GAS DIVISION
CHARLESTON

WELL LOCATION MAP

FILE NO. Wet-348

+ Denotes location of well on United States Topographic Map, scale 1 to 62,500, latitude and longitude lines being represented by border lines as shown.

— Denotes one inch spaces on border line of original tracing.

IMPERIAL DRAFTING CLOTH
K & E Co., N.Y.