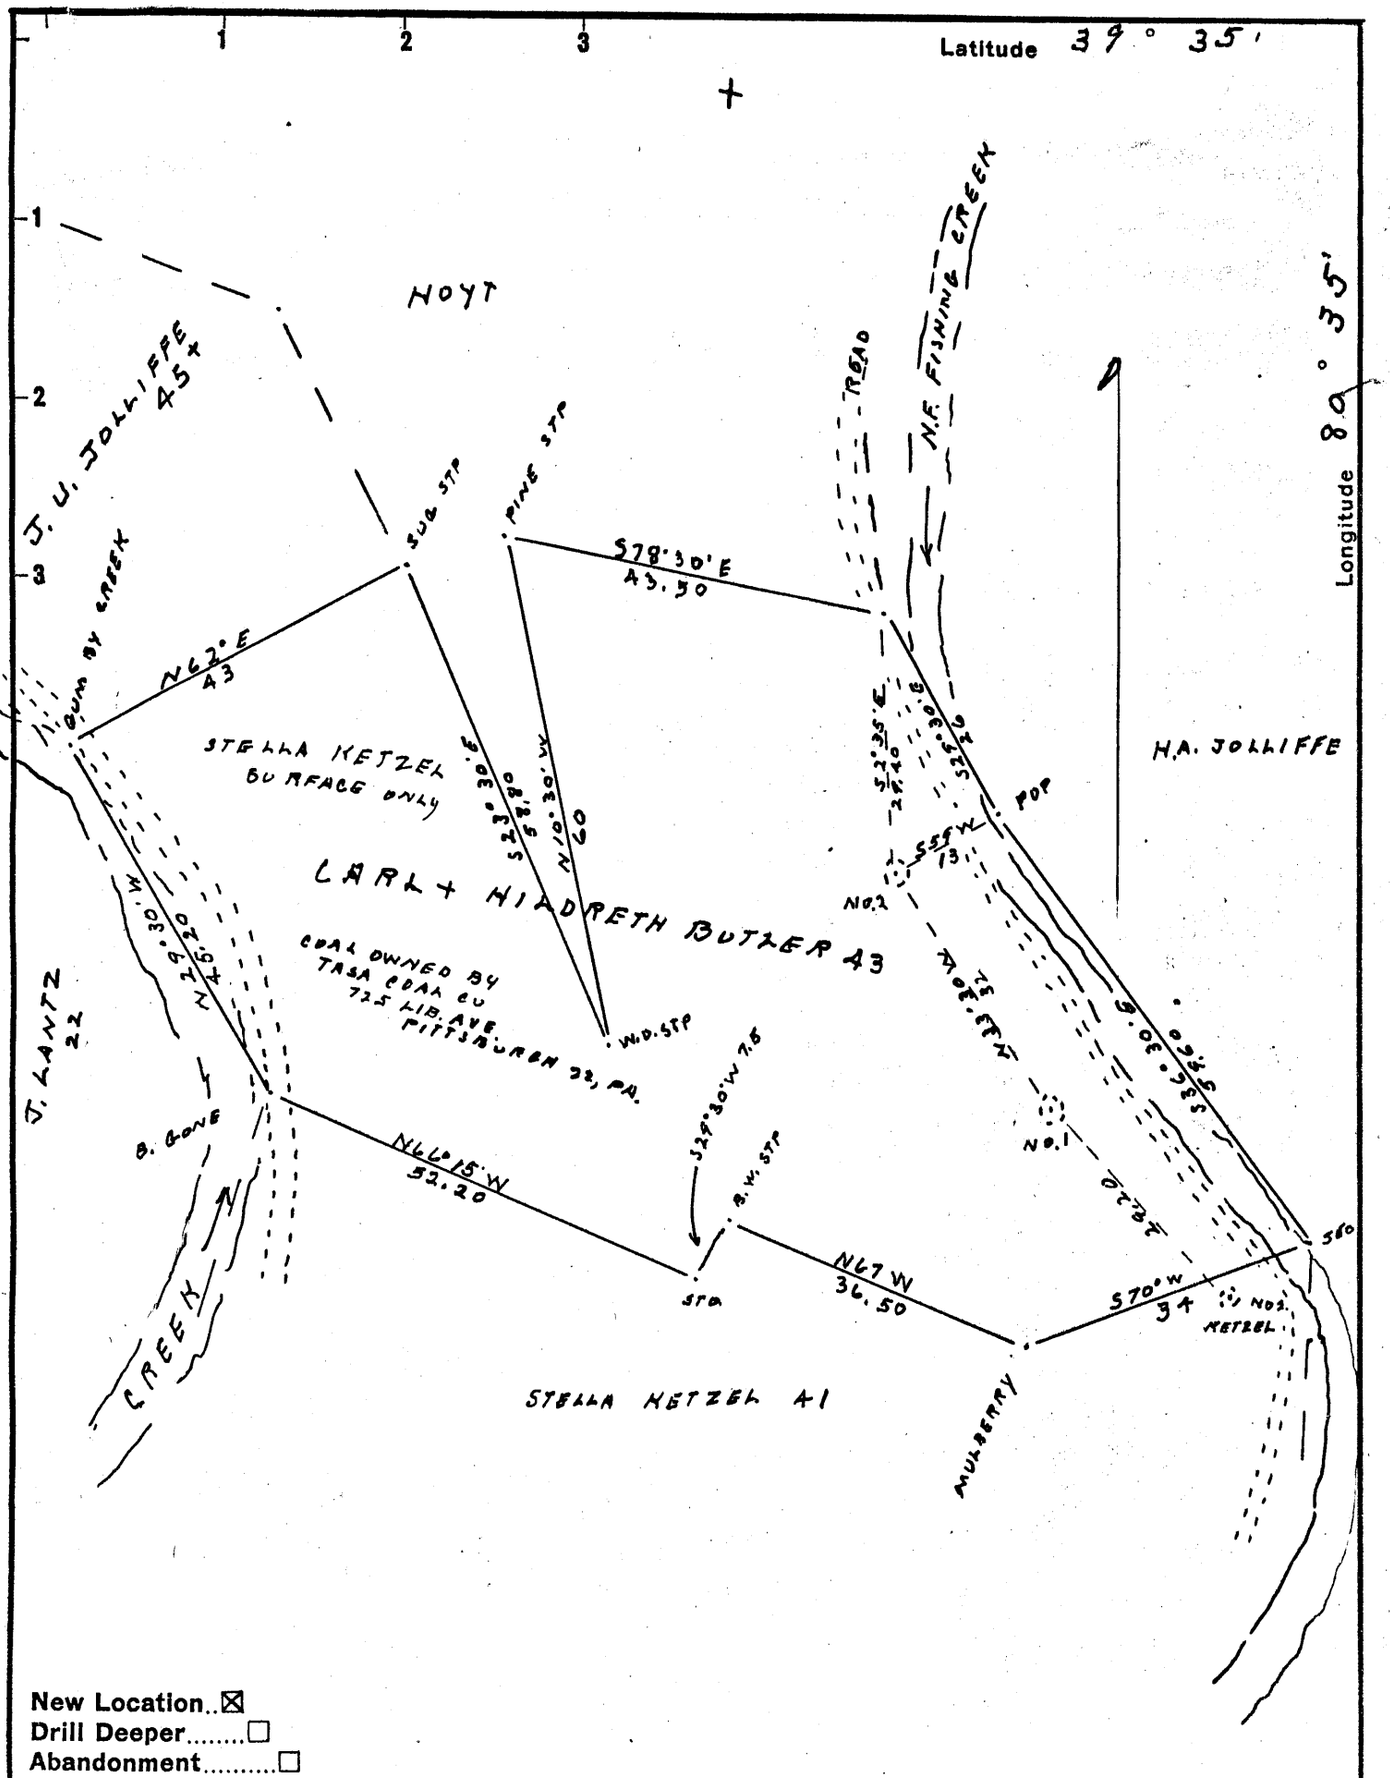

New Location..☒
Drill Deeper.....☐
Abandonment.....☐

A.B. LOWTHER AGT.

Company PINE RUN DEVELOPMENT CO

Address MIDDLEBOURNE, W.VA.

Farm CARL + HILDRETH BUTLER

Tract 1 Acres 43 Lease No.

Well (Farm) No. 2 Serial No.

Elevation (Spirit Level) 871

Quadrangle LITTLETON

County WETZEL District GRANT

Engineer J.M. Corkrean

Engineer's Registration No. CO. SURVEYOR

File No. Drawing No.

Date 6-13-56 Scale 1" = 20 ROD

STATE OF WEST VIRGINIA
DEPARTMENT OF MINES
OIL AND GAS DIVISION
CHARLESTON

WELL LOCATION MAP

FILE NO. Wet-437

+ Denotes location of well on United States Topographic Maps, scale 1 to 62,500, latitude and longitude lines being represented by border lines as shown.

— Denotes one inch spaces on border line of original tracing.