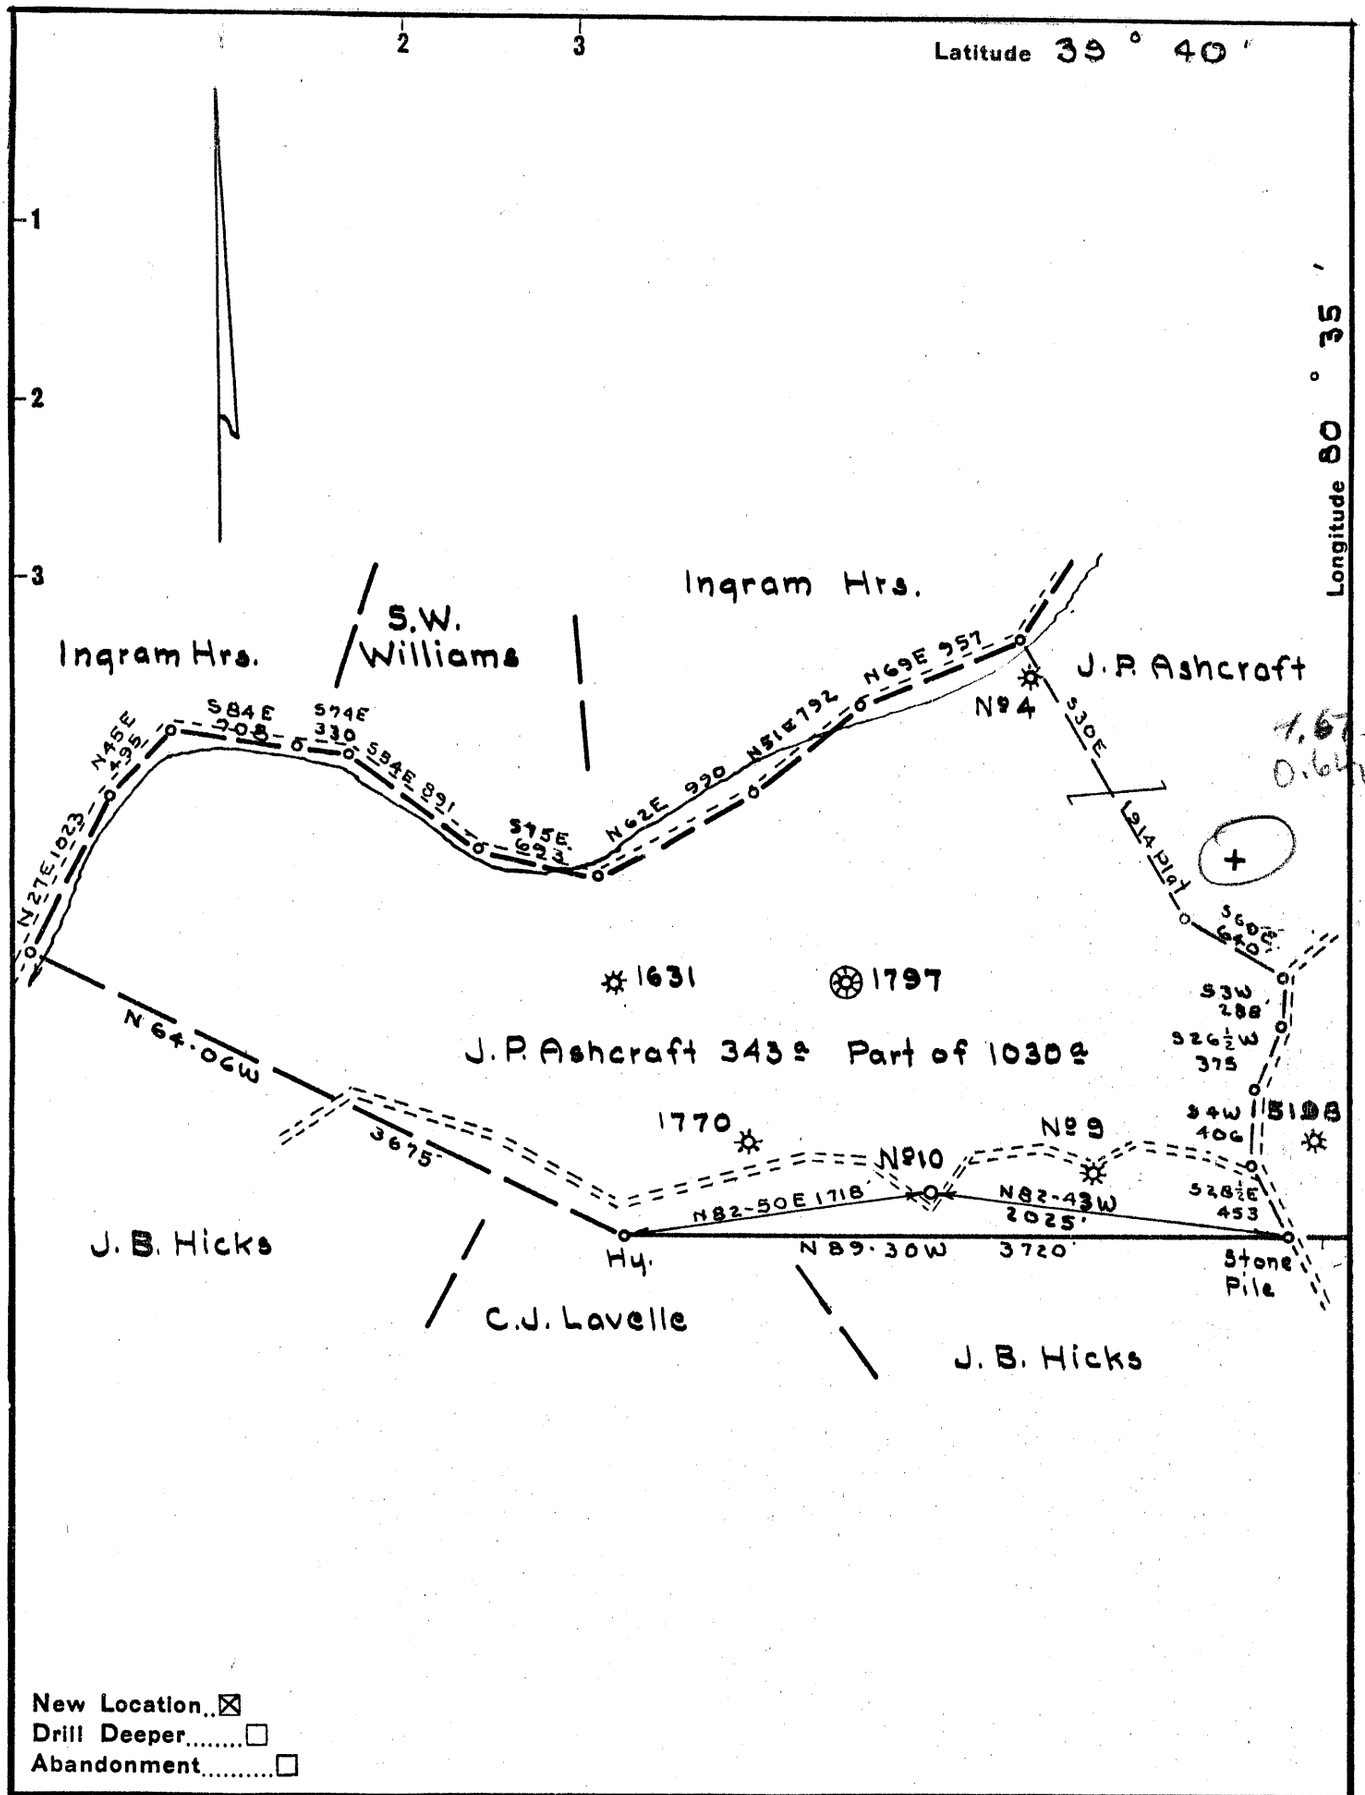

New Location..☒
Drill Deeper.....☐
Abandonment.....☐

Company P. C. McKenzie Co.
Address Pittsburgh Pa.
Farm J. P. Ashcraft
Tract _____ Acres 1030 Lease No. _____
Well (Farm) No. 10 Serial No. _____
Elevation (Spirit Level) 1460 V.A.
Quadrangle Littleton S.E. 1½
County Wetzel District Grant
Engineer J. D. Jeffries
Engineer's Registration No. 1084
File No. 183/98 Drawing No. _____
Date 10-17-56 Scale 1" = 1000'

STATE OF WEST VIRGINIA
DEPARTMENT OF MINES
OIL AND GAS DIVISION
CHARLESTON

WELL LOCATION MAP

FILE NO. Wet-441

+ Denotes location of well on United States Topographic Maps, scale 1 to 62,500, latitude and longitude lines being represented by border lines as shown.

— Denotes one inch spaces on border line of original tracing.