


FILE NO. 86
 MAP N69 S08 N8 E4
 SCALE 1" = 800'
 MINIMUM DEGREE OF ACCURACY 1 in 200
 PROVEN SOURCE OF ELEVATION Barr Tract No. 20
El. = 895.61'

I THE UNDERSIGNED, HEREBY CERTIFY THAT THIS PLAT IS CORRECT TO THE BEST OF MY KNOWLEDGE AND BELIEF AND SHOWS ALL THE INFORMATION REQUIRED BY LAW AND THE REGULATIONS ISSUED AND PRESCRIBED BY THE DEPARTMENT OF MINES.
 (SIGNED) Curtis A. Lucas
 CURTIS A. LUCAS LLS 275

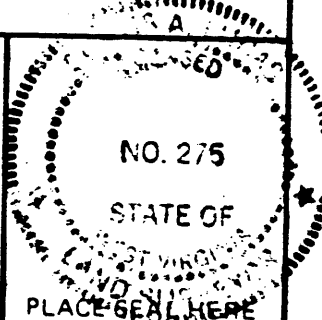

(+) DENOTES LOCATION OF WELL ON UNITED STATES TOPOGRAPHIC MAPS
 FORM IV-6 (8-78)



DATE 7-24, 19 81
 FARM BARR TRACT NO. 10
 API WELL NO. 47 - 103 - 0923-P
 STATE COUNTY PERMIT

STATE OF WEST VIRGINIA
 DEPARTMENT OF MINES
 OIL AND GAS DIVISION

WELL TYPE: OIL GAS LIQUID INJECTION WASTE DISPOSAL
 (IF "GAS,") PRODUCTION STORAGE DEEP SHALLOW
 LOCATION: ELEVATION 861.67' WATER SHED North Fork of Fishing Creek
 DISTRICT Grant COUNTY Wetzel
 QUADRANGLE Big Run 75'
 SURFACE OWNER Wm. Kilgoyne ACREAGE _____
 OIL & GAS ROYALTY OWNER Pennzoil Co. LEASE ACREAGE 1003.75 ac.
 LEASE NO. Fee 2676
 PROPOSED WORK: DRILL CONVERT DRILL DEEPER REDRILL FRACTURE OR STIMULATE PLUG OFF OLD FORMATION PERFORATE NEW FORMATION OTHER PHYSICAL CHANGE IN WELL (SPECIFY) _____
 PLUG AND ABANDON CLEAN OUT AND REPLUG
 TARGET FORMATION Injun ESTIMATED DEPTH 1992'
 WELL OPERATOR PENNZOIL COMPANY DESIGNATED AGENT JAMES A. CREWS
 ADDRESS P. O. BOX 1588 ADDRESS P. O. BOX 1588
PARKERSBURG, W. V. 26101 PARKERSBURG, W. V. 26101

OCT 08 1981

RECEIVED

JAN 21 1982

FORM OG-8

STATE OF WEST VIRGINIA
DEPARTMENT OF MINES
OIL AND GAS WELLS DIVISION

OIL AND GAS DIVISION
WV DEPARTMENT OF MINES

AFFIDAVIT OF PLUGGING AND FILLING WELL

AFFIDAVIT SHOULD BE MADE IN TRIPLICATE. ONE COPY MAILED TO THE DEPARTMENT. ONE COPY TO BE RETAINED BY THE WELL OPERATOR AND THE THIRD COPY (AND EXTRA COPIES IF REQUIRED) SHOULD BE MAILED TO EACH COAL OPERATOR AT THEIR RESPECTIVE ADDRESSES.

COAL OPERATOR OR OWNER: Consolidated Coal Company, 6451 Pleasant St., 2nd Floor, Library, PA. NAME OF WELL OPERATOR: Penncoil Company, P. O. Box 1588, Parkersburg, W. V. 26101. WELL AND LOCATION: Grant District, Wetzel County. Well No. 16, Barr Tract Farm.

STATE INSPECTOR SUPERVISING PLUGGING: Phillip Tracy

AFFIDAVIT

STATE OF WEST VIRGINIA, County of Wetzel ss:

Michael McCown and C. K. Echard being first duly sworn according to law depose and say that they are experienced in the work of plugging and filling oil and gas wells and were employed by Penncoil Company, well operator, and participated in the work of plugging and filling the above well, that said work was commenced on the 25th day of December, 1982, and that the well was plugged and filled in the following manner:

Table with columns: SAND OR ZONE RECORD, FILLING MATERIAL, PLUGS USED, CASING. Rows include Total Depth, Big Injun, Big Lime, Third Salt, Cow Run, and COAL SEAMS (Pittsburgh Coal).

and that the work of plugging and filling said well was completed on the 6th day of January, 1982.

And further deponents saith not. Michael McCown, C. K. Echard

Sworn to and subscribed before me this day of 19

My commission expires: Notary Public. Permit No. 103-923