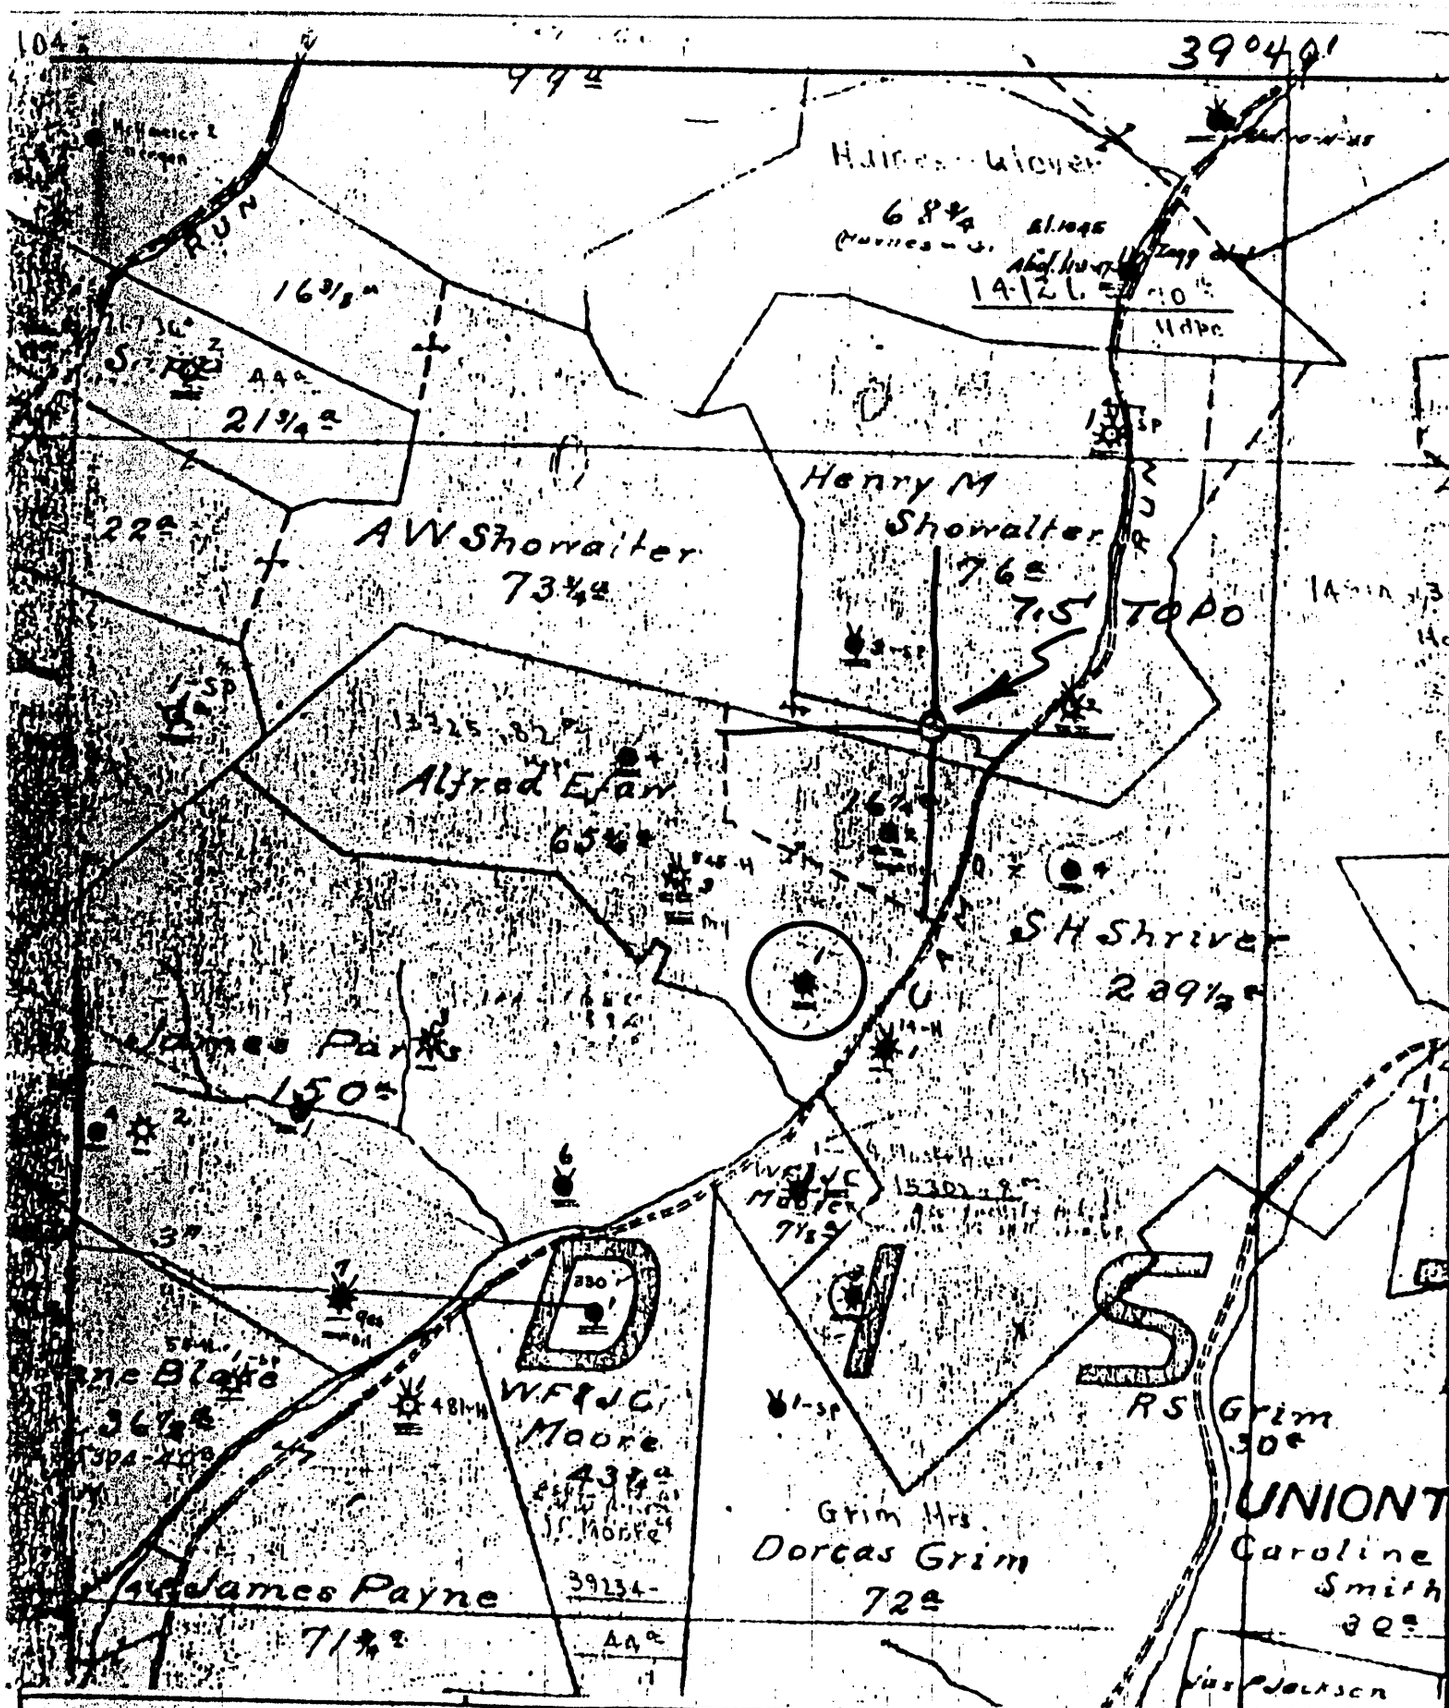

(+) DENOTES LOCATION OF WELL ON UNITED STATES TOPOGRAPHIC MAPS

FORM IV-6
(8-78)

N79 N14 E4

DATE 1-8-, 1979
OPERATOR'S WELL NO. 1
API WELL NO.
47 - 103 - 0971
STATE COUNTY PERMIT

STATE OF WEST VIRGINIA
DEPARTMENT OF MINES
OIL AND GAS DIVISION

WELL TYPE: OIL X GAS ___ LIQUID INJECTION ___ WASTE DISPOSAL ___
(IF "GAS", PRODUCTION ___ STORAGE ___ DEEP ___ SHALLOW ___)

LOCATION: ELEVATION ___ WATER SHED CAMP RUN, KNOB FORK
DISTRICT CENTER COUNTY WETZEL
QUADRANGLE LITTLETON 7.5'
SURFACE OWNER ___ ACREAGE ___
OIL & GAS ROYALTY OWNER ___ LEASE ACREAGE ___
LEASE NO. ___

PROPOSED WORK: DRILL ___ CONVERT ___ DRILL DEEPER ___ REDRILL ___ FRACTURE OR STIMULATE ___ PLUG OFF OLD FORMATION ___ PERFORATE NEW FORMATION ___ OTHER PHYSICAL CHANGE IN WELL (SPECIFY) ___

PLUG AND ABANDON ___ CLEAN OUT AND REPLUG ___

TARGET FORMATION ___ ESTIMATED DEPTH ___

WELL OPERATOR Pennzoil Company
ADDRESS P. O. Box 1588, Parkersburg, WV 26101

DESIGNATED AGENT James A. Crews
ADDRESS P. O. Box 1588, Parkersburg, WV 26101

LATITUDE 39° 40' 00"

LONGITUDE 80° 32' 30"

7'5 OGIS topo location

7.5' loc, 1.40 S 1.08 W

15' loc (calc.) _____ _____

Company _____

Farm _____

Quad LITTLETON 7½'

County WETZEL

District CENTER

WELL LOCATION MAP

File No. 103-0971

(040)

Well No. 6286 Alfred [illegible] Farm.

Lease No. Center Township Wetzel County

Rig built by Price [illegible]

Well drilled by [illegible] Contractor.

Began drilling June 18 1903 Completed Aug 29 1903

Formation	Top	Bottom	Remarks
Conductor		16	Steel line
Mapleton Coal	505		
Pittsburgh "	971		971
Dunkard Sand	1446	1486	1451
Gas "	1620	1650	1620
Salt "	1730		1650
Slate	1860		2025
Top of Salt [illegible]	1915		2215
Maxon Sand	2075		2302
Little Lime	2130	2150	2319
Big Lime	2150	2215	2374
Big Injun Sand	2215	2302	3011
Stray "	3011		3016
Gas	3016		3040
Gordon Sand	3044		3054½
Oil & Gas	3054½		3072.
2nd Pay	3056.		
Slate	3057		
Depth			

3072.

22½ bbls 1st [illegible]

	Casing Used	Pulled	Left in
10"	505.	505	
8¼"	1469.		1469
6⅝	2043-3		2043-3
5 3/16	2402.		2402.

Shot 7-29-18- 40 [illegible]

[illegible]

Poor copy

47-103-0971