


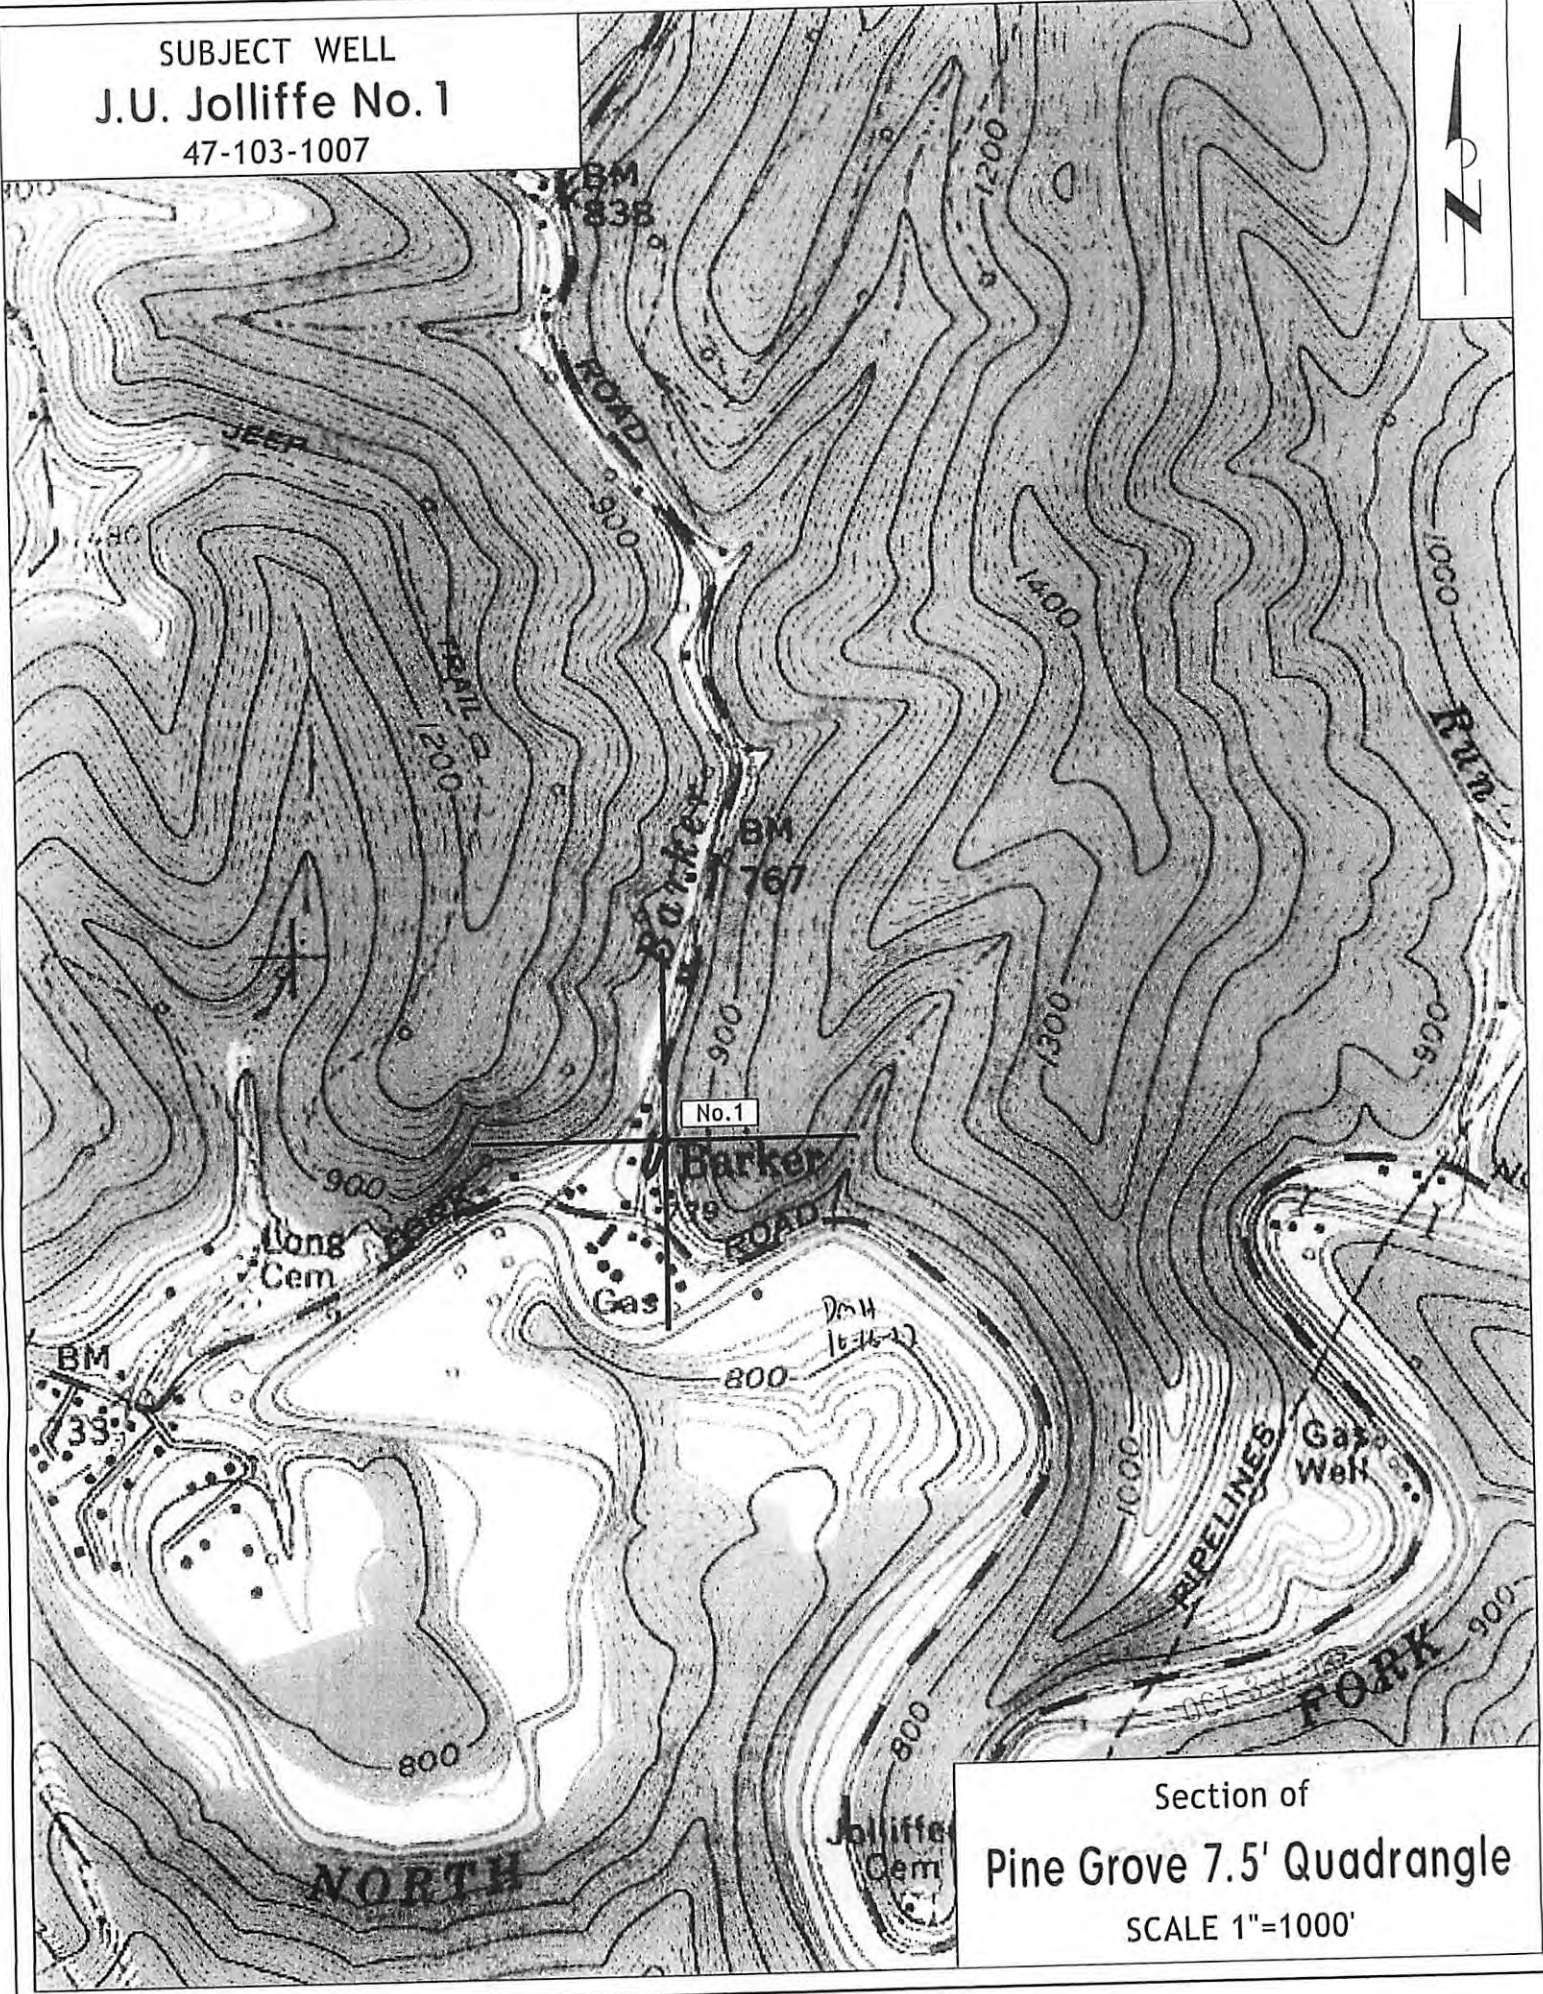

SUBJECT WELL  
J.U. Jolliffe No. 1  
47-103-1007



Section of  
Pine Grove 7.5' Quadrangle  
SCALE 1"=1000'