

4710301034P

WW-7
8-30-06



West Virginia Department of Environmental Protection
Office of Oil and Gas

WELL LOCATION FORM: GPS

API: 47-103-01034 WELL NO.: 7255

FARM NAME: I.D. MORGAN

RESPONSIBLE PARTY NAME: WEST VIRGINIA LAND RESOURCES INC.

COUNTY: WETZEL DISTRICT: GRANT

QUADRANGLE: BIG RUN W.VA

SURFACE OWNER: MAGNOLIA LAND PARTNERS LLC.

ROYALTY OWNER: _____

UTM GPS NORTHING: 4,373,104 m (1109')

UTM GPS EASTING: 540,045 m GPS ELEVATION: 338 m

The Responsible Party named above has chosen to submit GPS coordinates in lieu of preparing a new well location plat for a plugging permit or assigned API number on the above well. The Office of Oil and Gas will not accept GPS coordinates that do not meet the following requirements:

- Datum: NAD 1983, Zone: 17 North, Coordinate Units: meters, Altitude: height above mean sea level (MSL) – meters.
- Accuracy to Datum – 3.05 meters
- Data Collection Method:

Survey grade GPS _____ : Post Processed Differential _____

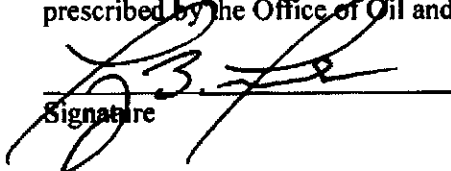
Real-Time Differential _____

Mapping Grade GPS X : Post Processed Differential X

Real-Time Differential _____

- Letter size copy of the topography map showing the well location.

I the undersigned, hereby certify this data is correct to the best of my knowledge and belief and shows all the information required by law and the regulations issued and prescribed by the Office of Oil and Gas.


Signature

Professional Surveyor
Title

OCTOBER 11, 2022
Date

RECEIVED
Office of Oil and Gas

NOV 18 2022

WV Department of
Environmental Protection

01/13/2023

4710301034P



477
32'30"
476
475
-1
-2
RECEIVED
Office of Oil and Gas
NOV 18 2022
WV Department of
Environmental Protection



'Big Run; WV Scale: 1" = 0.379Mi 610Mt 2,000Ft, 1 Mi = 2.640" . 1 cm = 240Mt

ROAD CLASSIFICATION	
Heavy-duty	Light-duty
Medium-duty	Unimproved dirt
	Slate Route

BIG RUN, W. VA.
SE/4 LITTLETON 15' QUADRANCE
N3930—W8030/7.5

01/13/2023

(WALLACE)
4582 N.W.