

4710301037P




477  
32'30"  
476  
475  
474  
473  
39'30"  
80'30"

39 32'30" 40 41 42 80'30"



RECEIVED  
Office of Oil and Gas

MAY 04 2023

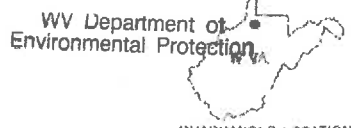

ROAD CLASSIFICATION

Heavy-duty ——— Light-duty ———  
Medium-duty ——— Unimproved dirt - - - - -

Slate Route

(WALLACE)  
462 N 1 W

BIG RUN, W. VA.

SE/4 LITTLETON 15' QUADRANT  
N3930—W8030/7.5

06/02/2023

QUADRANT LOCATION  
"Big Run: WV" Scale: 1" = 0.379Mi 610M 2 000F 1 Mi = 2 640' 1 cm = 240M



WW-7  
8-30-06



RECEIVED  
Office of Oil and Gas  
MAY 04 2023  
WV Department of  
Environmental Protection  
4710301037P

West Virginia Department of Environmental Protection  
Office of Oil and Gas

WELL LOCATION FORM: GPS

API: 47-103-01037 WELL NO.: 7310

FARM NAME: I. D. MORGAN

RESPONSIBLE PARTY NAME: WEST VIRGINIA LAND RESOURCES INC.

COUNTY: WETZEL DISTRICT: GRANT

QUADRANGLE: BIG RUN W.VA

SURFACE OWNER: MICHAEL A. BAKER

ROYALTY OWNER: \_\_\_\_\_

UTM GPS NORTHING: 4,374,233 m (1122')

UTM GPS EASTING: 539,956 m GPS ELEVATION: 342 m

The Responsible Party named above has chosen to submit GPS coordinates in lieu of preparing a new well location plat for a plugging permit or assigned API number on the above well. The Office of Oil and Gas will not accept GPS coordinates that do not meet the following requirements:

- Datum: NAD 1983, Zone: 17 North, Coordinate Units: meters, Altitude: height above mean sea level (MSL) – meters.
- Accuracy to Datum – 3.05 meters
- Data Collection Method:

Survey grade GPS \_\_\_\_\_: Post Processed Differential \_\_\_\_\_  
 Real-Time Differential \_\_\_\_\_  
 Mapping Grade GPS X: Post Processed Differential X  
 Real-Time Differential \_\_\_\_\_

4. Letter size copy of the topography map showing the well location.

I the undersigned, hereby certify this data is correct to the best of my knowledge and belief and shows all the information required by law and the regulations issued and prescribed by the Office of Oil and Gas.

[Signature] Professional Surveyor APRIL 21, 2023  
 Signature Title Date

06/02/2023