


(H) DENOTES LOCATION OF WELL ON UNITED STATES TOPOGRAPHIC MAPS

◆ - Denotes a Water Supply Source

FILE NO. 325
 MAP NO. N68 N 11 S E W 2
 SCALE 1" = 1000'
 MINIMUM DEGREE OF ACCURACY 1 in 200
 PROVEN SOURCE OF ELEVATION USGS BM - 838'

I THE UNDERSIGNED, HEREBY CERTIFY THAT THIS PLAT IS CORRECT TO THE BEST OF MY KNOWLEDGE AND BELIEF AND SHOWS ALL THE INFORMATION REQUIRED BY LAW AND THE REGULATIONS ISSUED AND PRESCRIBED BY THE DEPARTMENT OF MINES.

(SIGNED) *Timothy P. Roush*
 TIMOTHY P. ROUSH PS 793

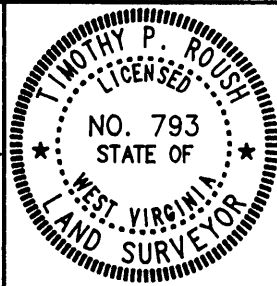

STATE OF WEST VIRGINIA
 DIVISION OF ENERGY
 OIL AND GAS SECTION



DATE October 28, 19 96
 FARM L.S. Hoyt NO. 10
 API WELL NO. 47-103-01210-P

WELL TYPE: OIL GAS LIQUID INJECTION WASTE DISPOSAL
 (IF "GAS") PRODUCTION STORAGE DEEP SHALLOW
 LOCATION: ELEVATION 1148' WATERSHED Barker Run
 DISTRICT G. COUNTY Wetzel
 QUADRANGLE Pine Grove

SURFACE OWNER Dallison Lumber Inc. ACREAGE 2099.3 Ac.
 OIL & GAS ROYALTY OWNER The Hoyt Foundation LEASE ACREAGE 2100 Ac.
 LEASE NO. 99191-00

PROPOSED WORK: DRILL CONVERT DRILL DEEPER REDRILL FRACTURE OR STIMULATE PLUG OFF OLD FORMATION PERFORATE NEW FORMATION OTHER PHYSICAL CHANGE IN WELL (SPECIFY) Plugging existing well drilled in 1900 NOV 8 1996

PLUG AND ABANDON CLEAN OUT AND REPLUG
 TARGET FORMATION Gordon ESTIMATED DEPTH 3031'
 WELL OPERATOR Pennzoil Products Company DESIGNATED AGENT Philip S. Ondrusek
 ADDRESS P. O. Box 5519 ADDRESS P. O. Box 5519
Vienna, W.Va. 26105 Vienna, W.Va. 26105

JAN 27 1997

STATE OF WEST VIRGINIA
DIVISION OF ENVIRONMENTAL PROTECTION
SECTION OF OIL AND GAS

103
Wad: 72887

Permitting
Office of Oil & Gas
AFFIDAVIT OF PLUGGING AND FILLING WELL

AFFIDAVIT SHOULD BE IN TRIPLICATE, one copy mailed to the Division, one copy to be retained by the Well Operator and the third copy (and extra copies if required) should be mailed to each coal operator at their respective addresses.

Farm name: DALLISON LUMBER COMPANY Operator Well No.: L.S. HOYT #10

LOCATION: Elevation: 1,148.00 Quadrangle: PINE GROVE
District: CLAY County: WETZEL
Latitude: 12000 Feet South of 39 Deg. 37 Min. 30 Sec.
Longitude 9500 Feet West of 80 Deg. 37 Min. 30 Sec.

Well Type: OIL X GAS _____ Liquid Injection _____

Company: Pennzoil Products Company Coal Operator DUPECK Inc.
P. O. Box 5519 or Owner 6451 Pleasant St.
Vienna, WV 26105-5519 Library, PA 15129

Agent: P. S. Ondrusek Coal Operator _____
or Owner _____

Permit Issued: 11/06/96

AFFIDAVIT

STATE OF WEST VIRGINIA,
County of Wood ss:

R. A. Green and Teroy Snodgrass being first duly sworn according to law depose and say that they are experienced in the work of plugging and filling oil and gas wells and were employed by the above named well operator, and participated in the work of plugging and filling the above well, and Randal Mick Oil and Gas Inspector representing the Director, say that said work was commenced on the 13th day of December, 1996, and that the well was plugged and filled in the following manner:

TYPE	FROM	TO	PIPE REMOVED	LEFT
Gel between plugs				
120 sks. cement	3000'	2780'	5-3/16" csg. 200'	0
20 sks. cement	2220'	2120'	6-5/8" csg. 100'	2071'
30 sks. cement	1480'	1380'	6-5/8" & 8-1/4" csg.	perforated
50 sks. cement	980'	880'	1443'-1553' & 935'	948'
70 sks. cement	400'	300'	6-5/8" csg. ripped @	400'
120 sks. cement	100'	Surface		


3/3/97

Description of monument: 1 jt. 7" csg. extending 30" above surface and that the work of plugging and filling said well was completed on the 3rd day of January, 1997.

And further deponents saith not.

Sworn and subscribe before me this 9th day of January, 1997
My commission expires: August 7, 2006

R. A. Green
Teroy Snodgrass
Diane E. Bosley
Notary Public

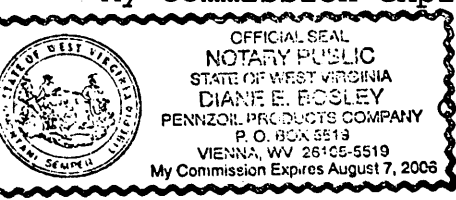

Oil and Gas Inspector: _____

Pine Grove (040)

MAR 6 - 1997