


47103013279



46 2730' 47 48 (GLOVERGAP) 49 25' RECEIVED FE Office of Oil and Gas

SCALE 1:24 000

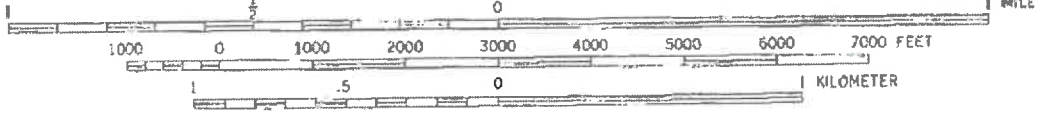

CONTOUR INTERVAL 20 FEET
 NATIONAL GEODETIC VERTICAL DATUM OF 1929

0°22' 7 M 1/3
 Hundred WV PA Scale: 1" = 0.379 Mi 610M 2 000Ft 1 Mi = 2 640' 1 cm = 240M

APR 17 2023

WV Department of Environmental Protection

05/19/2023

WW-7
8-30-06



West Virginia Department of Environmental Protection
Office of Oil and Gas

WELL LOCATION FORM: GPS

API: 47-103-01327 WELL NO.: 8041

FARM NAME: J. D. BARTRUG

RESPONSIBLE PARTY NAME: WEST VIRGINIA LAND RESOURCES INC.

COUNTY: WETZEL DISTRICT: CHURCH

QUADRANGLE: HUNDRED W.VA, PA

SURFACE OWNER: B C FARMS INVESTMENTS LLC.

ROYALTY OWNER: _____

UTM GPS NORTHING: 4,389,006 m (1299')

UTM GPS EASTING: 549,188 m GPS ELEVATION: 396 m

The Responsible Party named above has chosen to submit GPS coordinates in lieu of preparing a new well location plat for a plugging permit or assigned API number on the above well. The Office of Oil and Gas will not accept GPS coordinates that do not meet the following requirements:

1. Datum: NAD 1983, Zone: 17 North, Coordinate Units: meters, Altitude: height above mean sea level (MSL) – meters.
2. Accuracy to Datum – 3.05 meters
3. Data Collection Method:
Survey grade GPS _____: Post Processed Differential _____


Real-Time Differential _____

Mapping Grade GPS X: Post Processed Differential X

Real-Time Differential _____

4. Letter size copy of the topography map showing the well location.

I the undersigned, hereby certify this data is correct to the best of my knowledge and belief and shows all the information required by law and the regulations issued and prescribed by the Office of Oil and Gas.

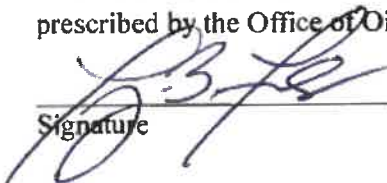 Professional Surveyor FEBRUARY 20, 2023
Signature Title Date

RECEIVED
Office of Oil and Gas

APR 17 2023

WV Department of
Environmental Protection

Stephen McCoy
05/19/2023