


47-103-01688P

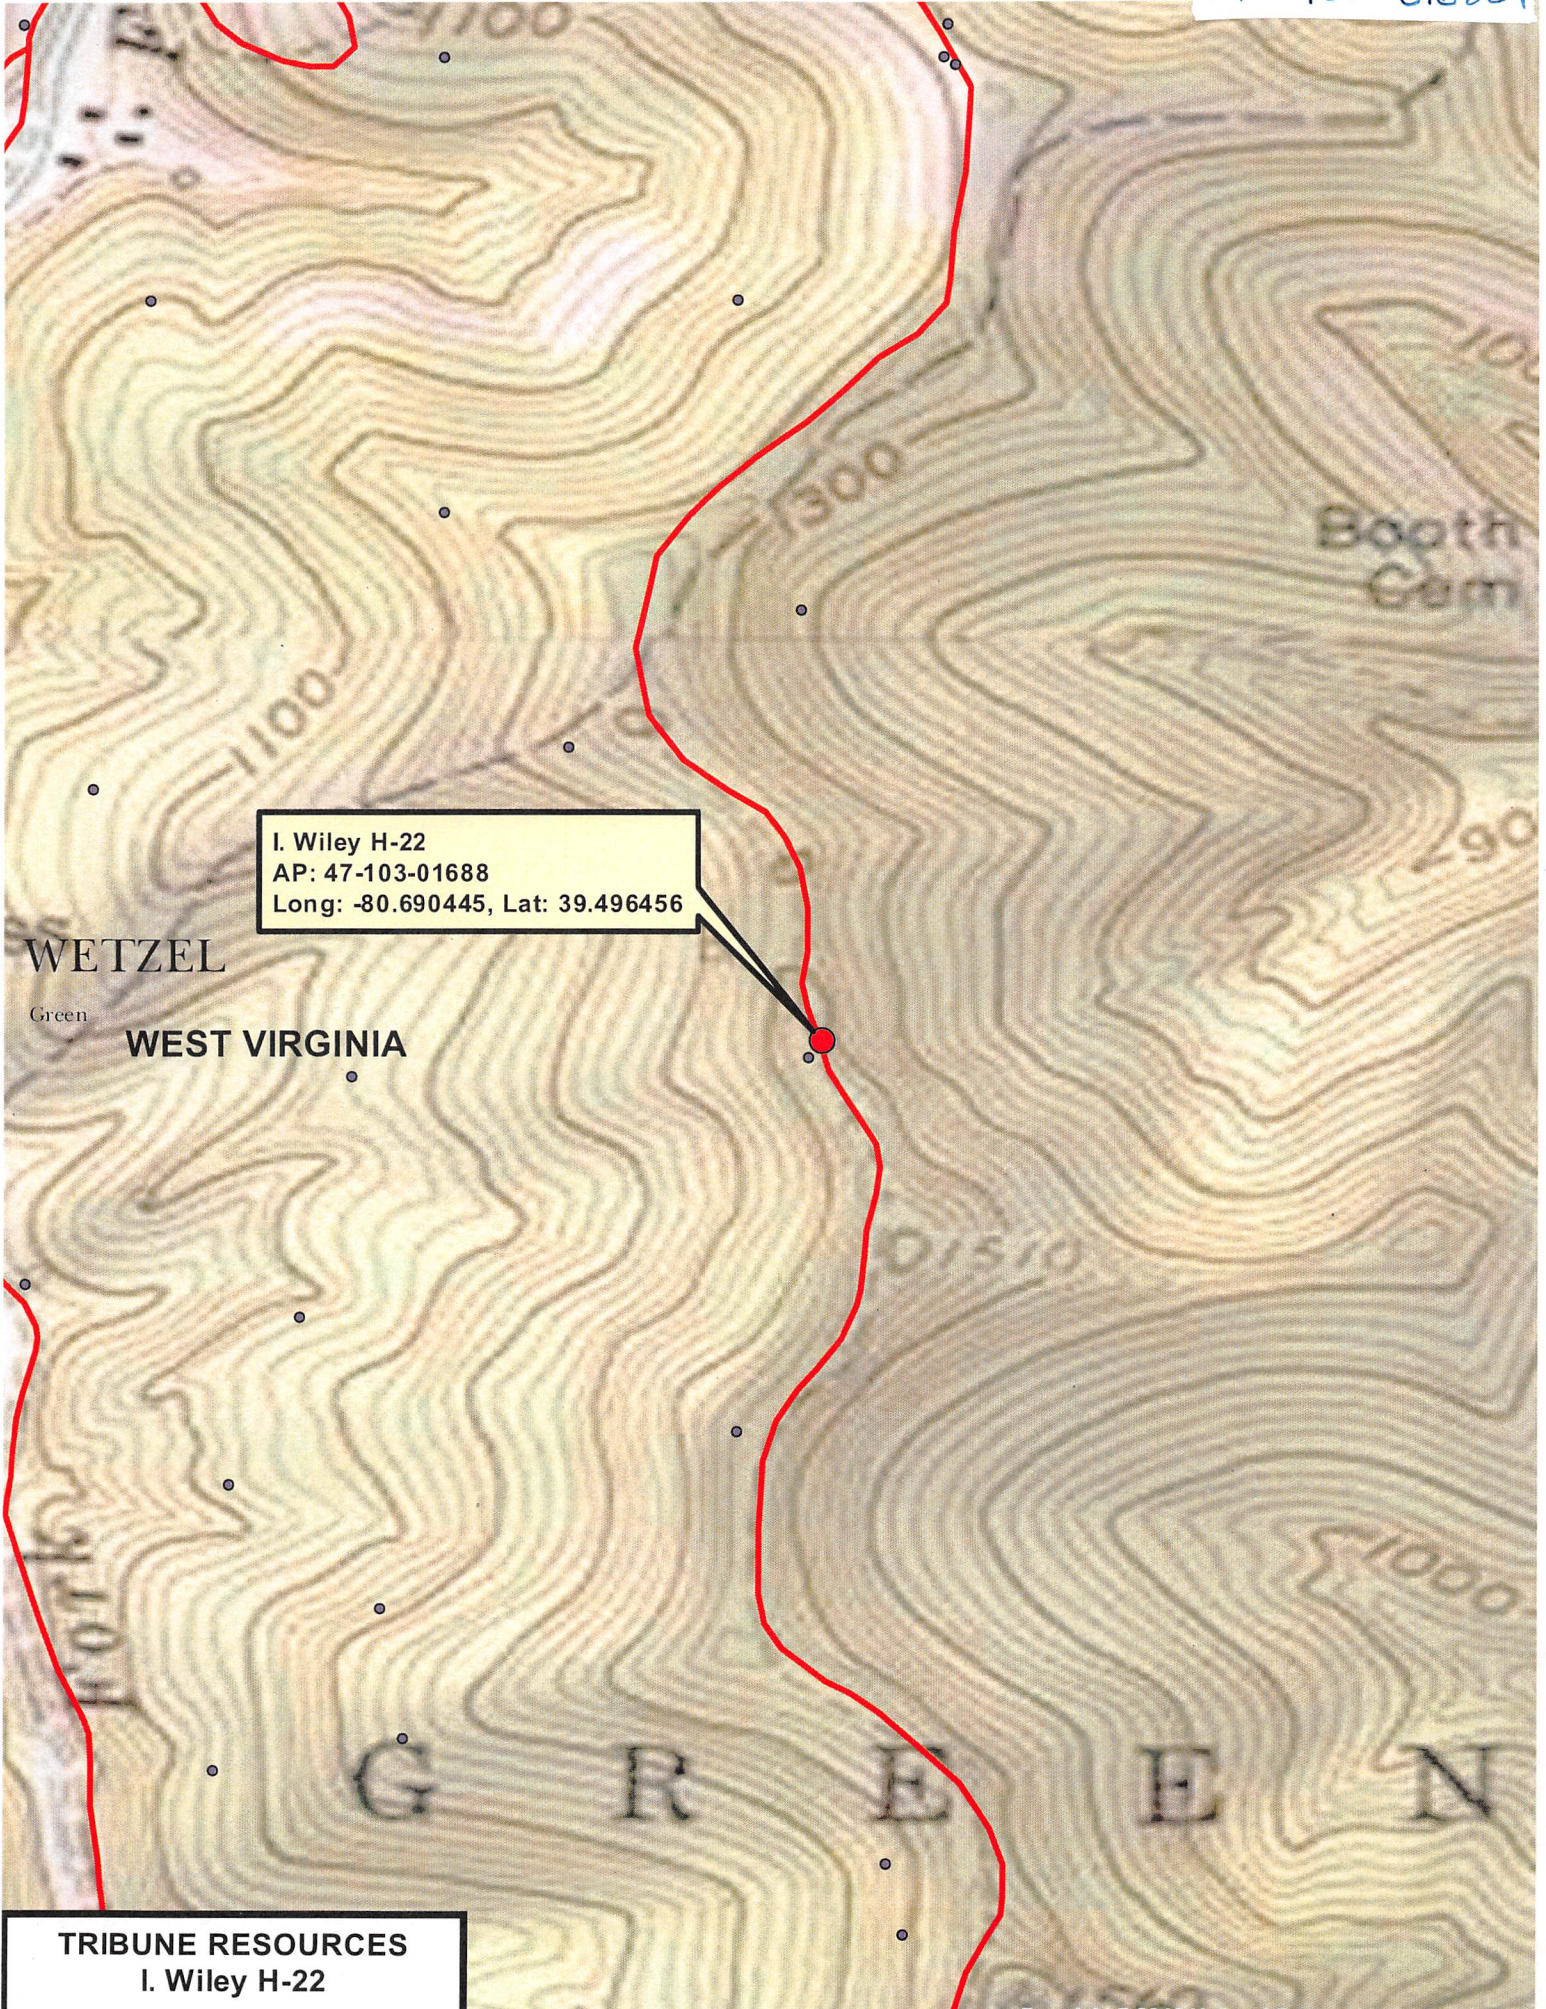

I. Wiley H-22
AP: 47-103-01688
Long: -80.690445, Lat: 39.496456

WETZEL

Green

WEST VIRGINIA

G R E E N

TRIBUNE RESOURCES
I. Wiley H-22