

4710302107 PP

WW-7
8-30-06



West Virginia Department of Environmental Protection
Office of Oil and Gas

WELL LOCATION FORM: GPS

API: 47-103-02107 WELL NO.: Cumb Ob 1

FARM NAME: Cumberledge

RESPONSIBLE PARTY NAME: Monument Oil & Gas LLC

COUNTY: Wetzel DISTRICT: Church

QUADRANGLE: Hundred

SURFACE OWNER: Carroll and Judy Cumberledge

ROYALTY OWNER: Carroll and Judy Cumberledge

UTM GPS NORTHING: 4392547

UTM GPS EASTING: 549018 GPS ELEVATION: 1178

The Responsible Party named above has chosen to submit GPS coordinates in lieu of preparing a new well location plat for a plugging permit or assigned API number on the above well. The Office of Oil and Gas will not accept GPS coordinates that do not meet the following requirements:

1. Datum: NAD 1983, Zone: 17 North, Coordinate Units: meters, Altitude: height above mean sea level (MSL) – meters.
2. Accuracy to Datum – 3.05 meters
3. Data Collection Method:

Survey grade GPS ____ : Post Processed Differential ____

Real-Time Differential ____

Mapping Grade GPS ____ : Post Processed Differential ____

Real-Time Differential ____

RECEIVED
Office of Oil and Gas

MAR 14 2022

WV Department of
Environmental Protection

4. Letter size copy of the topography map showing the well location.

I the undersigned, hereby certify this data is correct to the best of my knowledge and belief and shows all the information required by law and the regulations issued and prescribed by the Office of Oil and Gas.

[Signature]
Signature


Land Manager
Title

02/09/22
Date

04/08/2022

MAR 14 2022

CNX Cumberledge

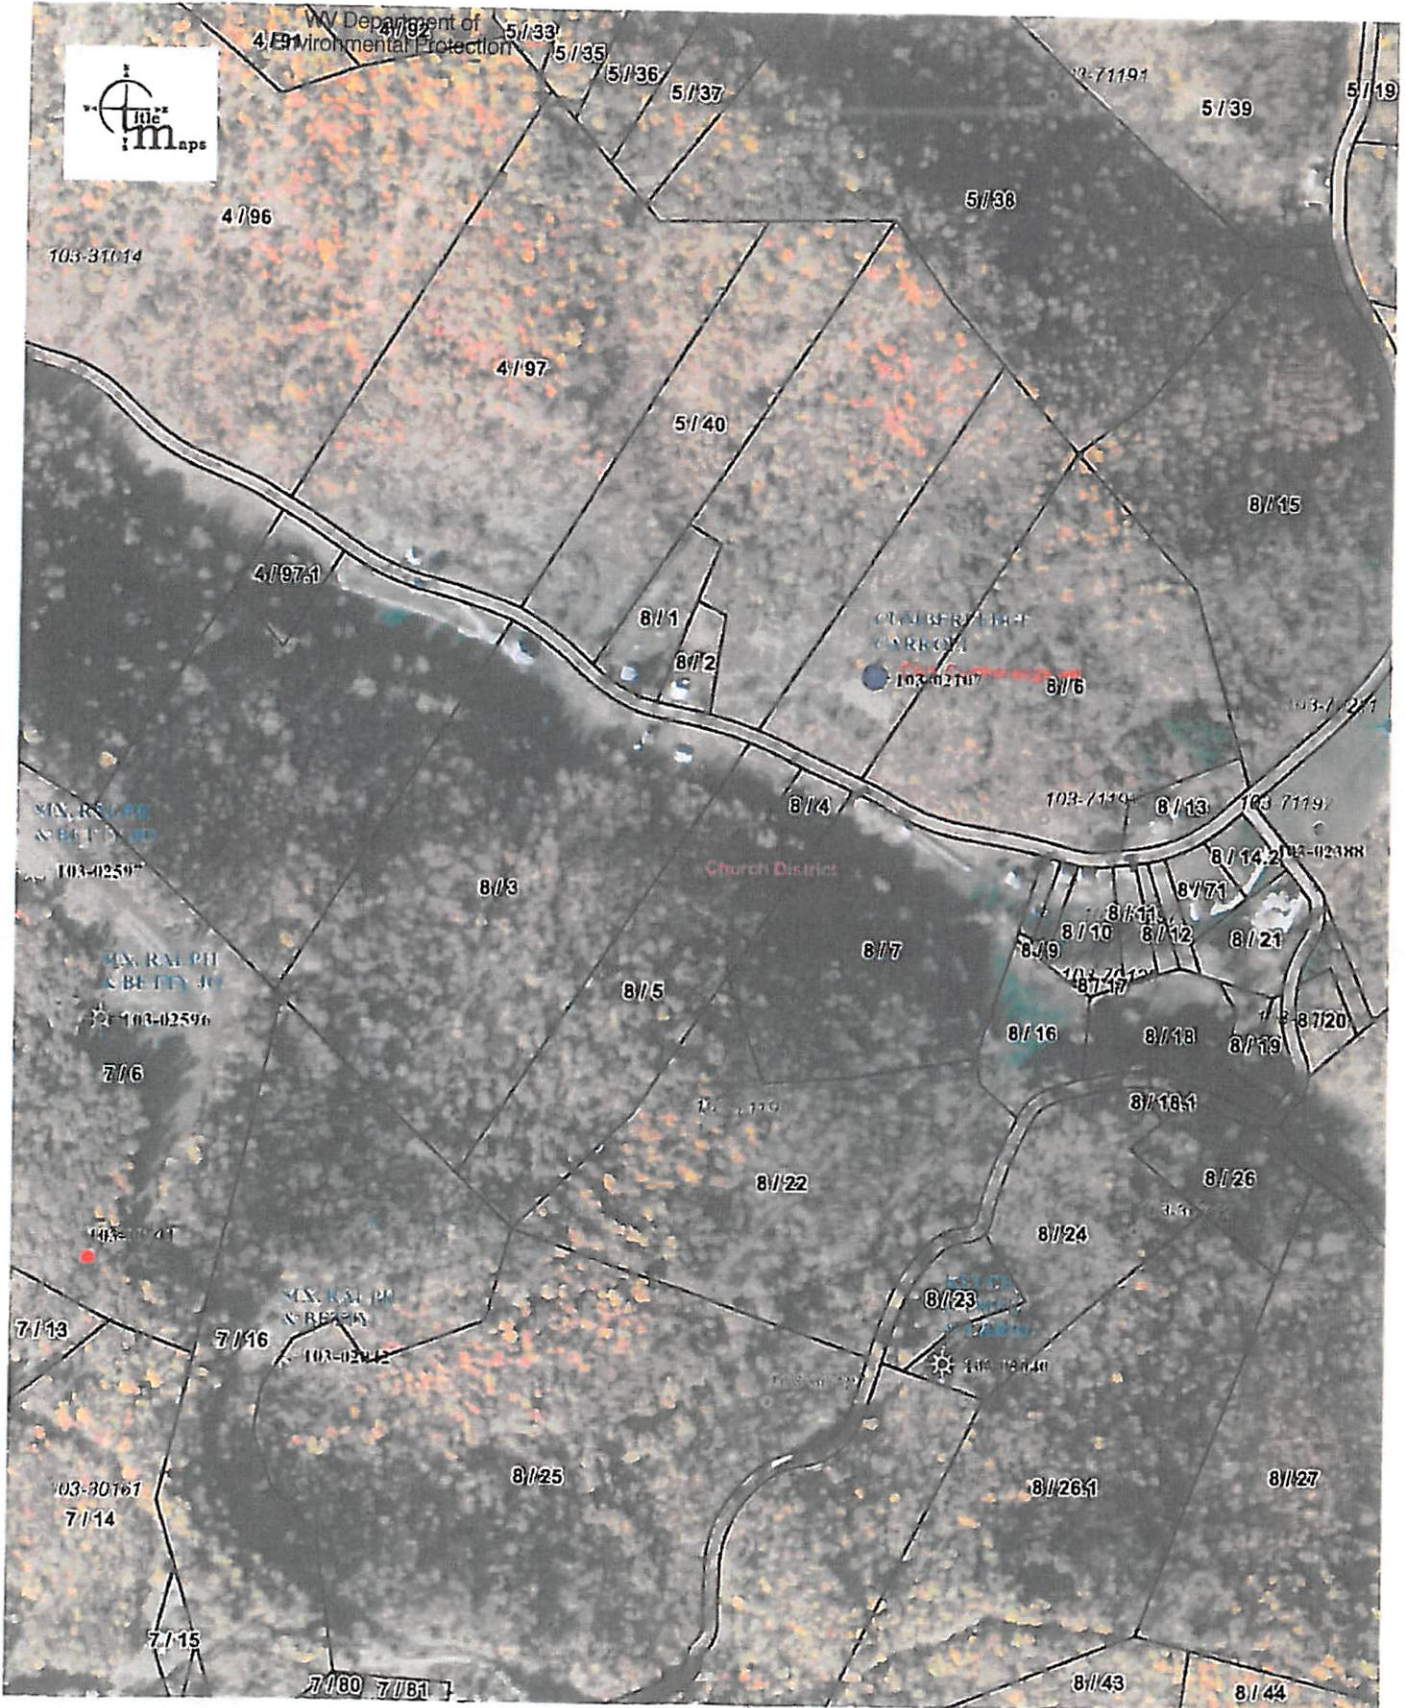

500ft

39.68135
- 80.428395

Approximate Scale 1:6,000

01/03/2022 - 09:17:21 AM

Disclaimer: The map information shown is from public sources including but not limited to tax maps and state and federal agency web sites. The map information does not represent and should not be relied upon as a land survey or legal depiction of the property or information shown. Title Maps LLC does not warrant the accuracy or correctness of the map information shown hereon.

01/03/2022