

411
32'30"
476
475
474
39°30'

RECEIVED
Office of Oil and Gas
OCT 18 2023
WV Department of Environmental Protection

39 32'30" 40 41 80°30'



ROAD CLASSIFICATION	
Heavy-duty	Light-duty
Medium duty	Unimproved dirt
	Slate Route



BIG RUN, W. VA.
SE/4 LITTLETON 15' QUADRANGLE
N3930—W8030/7.5

3
32
N 3930
"Big Run, WV" Scale: 1" = 0.379Mi 610Mt 2.000Ft, 1 Mi = 2.640", 1 cm = 240Mt

1960
11/10/2023

(WALLACE)
4022 IV NW

WW-7
8-30-06



West Virginia Department of Environmental Protection
Office of Oil and Gas

WELL LOCATION FORM: GPS

API: 47-103-02386 WELL NO.: RR-33

FARM NAME: TALL TIMBER INC.

RESPONSIBLE PARTY NAME: WEST VIRGINIA LAND RESOURCES INC.

COUNTY: WETZEL DISTRICT: GRANT

QUADRANGLE: BIG RUN W.VA

SURFACE OWNER: DOUGLAS JOE SMITH

ROYALTY OWNER: _____

UTM GPS NORTHING: 4,373,984 m

UTM GPS EASTING: 542,292 m GPS ELEVATION: 281 m

The Responsible Party named above has chosen to submit GPS coordinates in lieu of preparing a new well location plat for a plugging permit or assigned API number on the above well. The Office of Oil and Gas will not accept GPS coordinates that do not meet the following requirements:

- Datum: NAD 1983, Zone: 17 North, Coordinate Units: meters, Altitude: height above mean sea level (MSL) – meters.
- Accuracy to Datum – 3.05 meters
- Data Collection Method:

Survey grade GPS _____: Post Processed Differential _____


Real-Time Differential _____

Mapping Grade GPS X: Post Processed Differential X

Real-Time Differential _____

- Letter size copy of the topography map showing the well location.

I the undersigned, hereby certify this data is correct to the best of my knowledge and belief and shows all the information required by law and the regulations issued and prescribed by the Office of Oil and Gas.

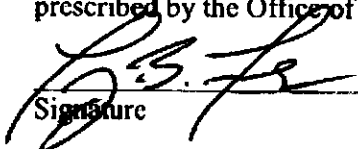
Signature


PS 2002
Title

AUGUST 11, 2023
Date

RECEIVED:
Office of Oil and Gas
OCT 18 2023

WV Department of
Environmental Protection

11/10/2023

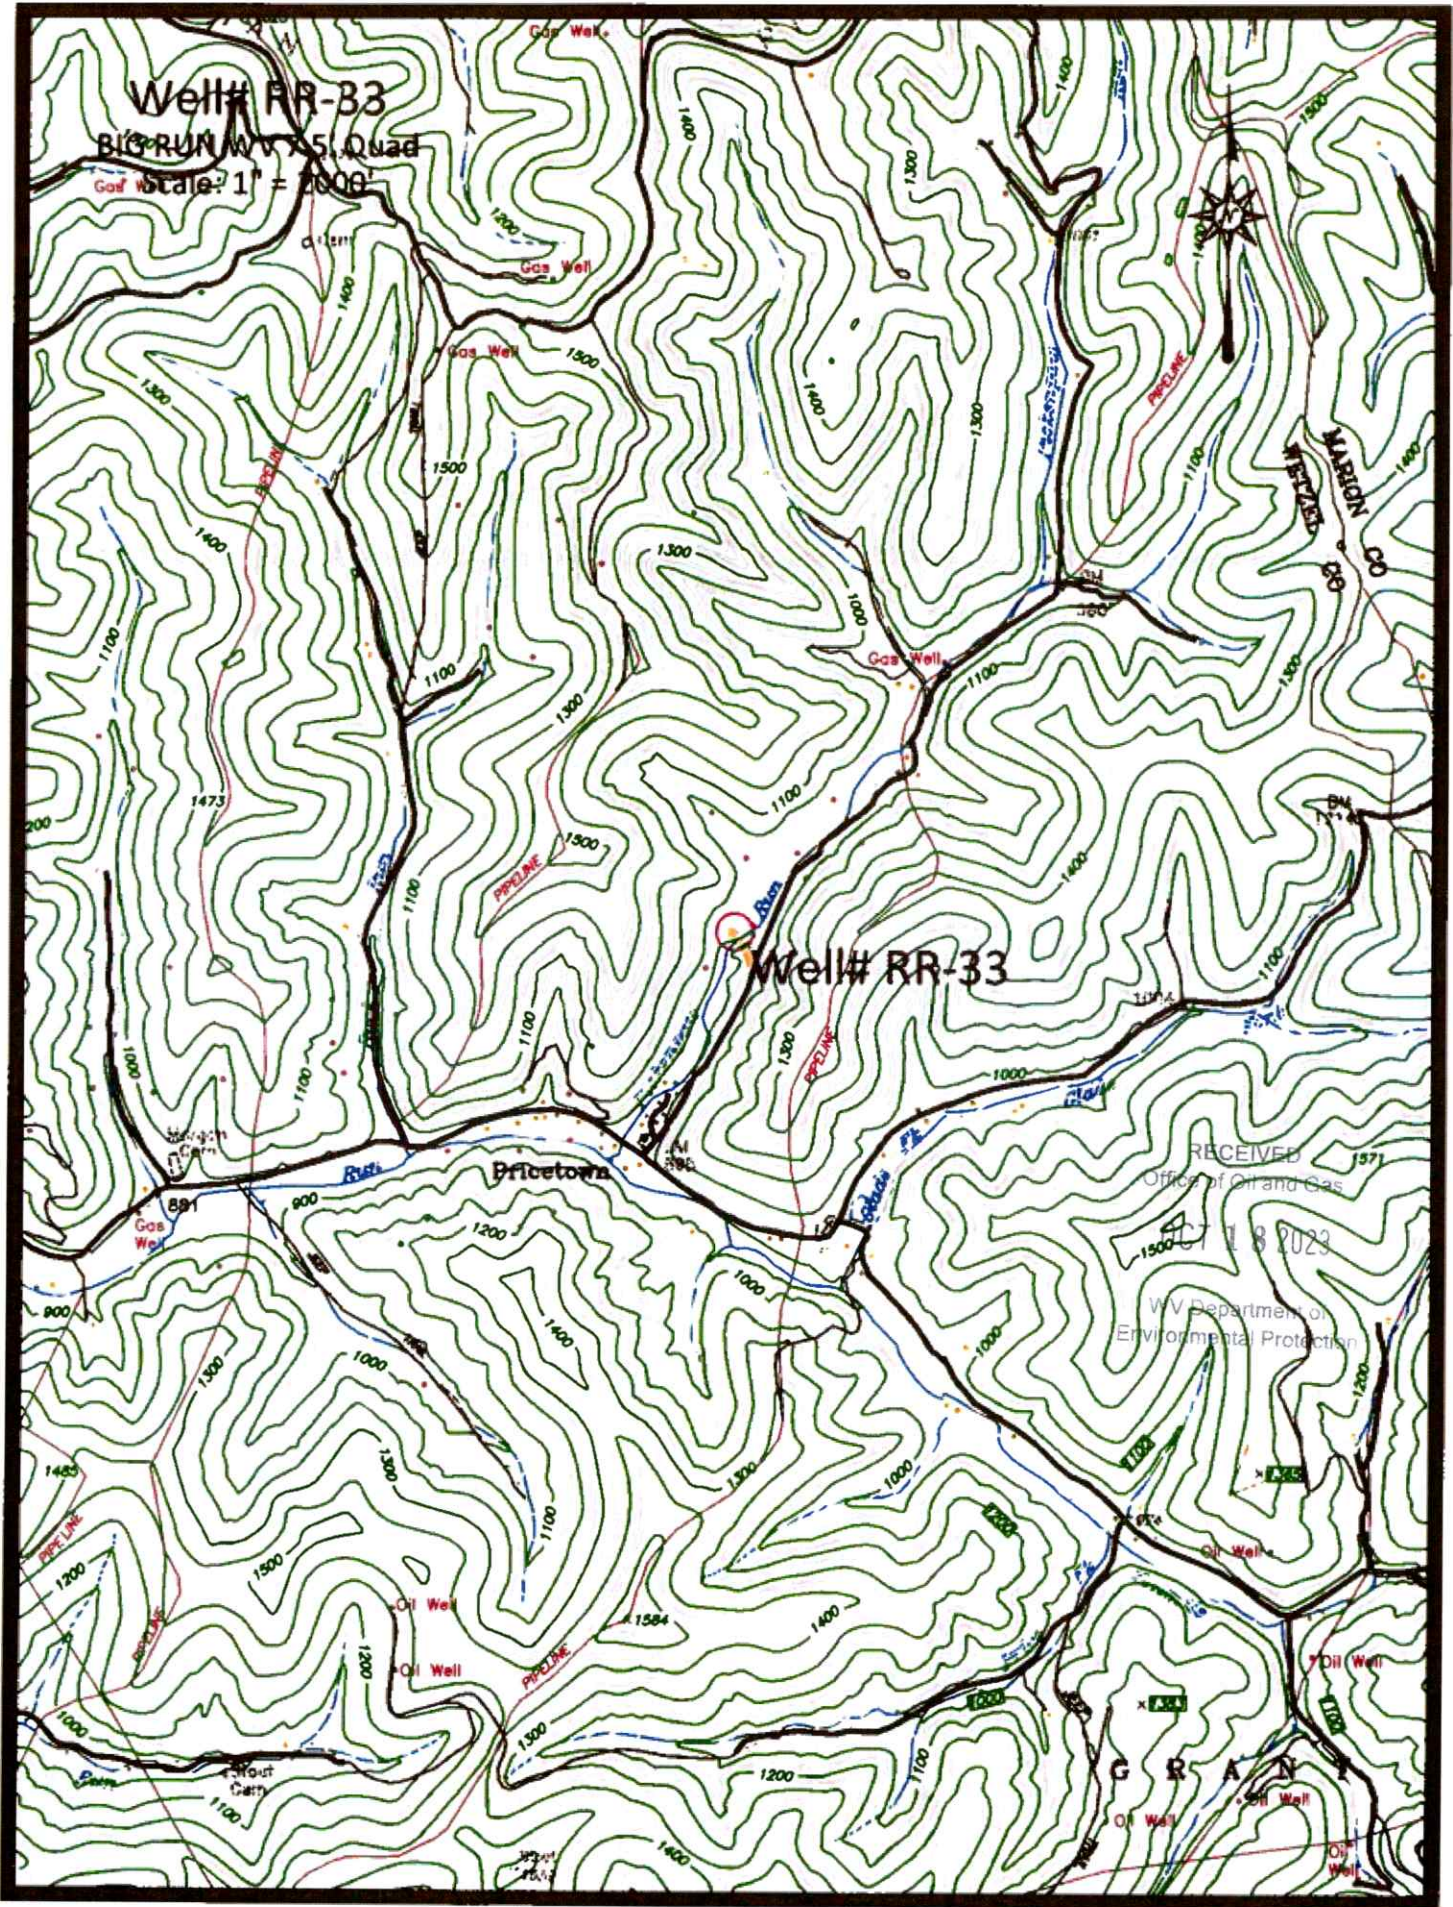

11/10/2023

Well# RR-33
BIG RUN WV 7.5' Quad



1100

1500

Run

Well# RR-33

Pickens Run

1300

PIPELINE

RECEIVED
Office of Oil and Gas
OCT 18 2023
WV Department of
Environmental Protection

BM
895

town

11/10/2023