



west virginia department of environmental protection

Office of Oil and Gas
601 57th Street SE
Charleston, WV 25304
(304) 926-0450
(304) 926-0452 fax

Earl Ray Tomblin, Governor
Randy C. Huffman, Cabinet Secretary
www.dep.wv.gov

PERMIT MODIFICATION APPROVAL

January 12, 2015

EQT PRODUCTION COMPANY
303 SAND CUT ROAD
CLARKSBURG, WV 26301

Re: Permit Modification Approval for API Number 10302906, Well #: 513982

Modify depth of 13-3/8" and 9-5/8" casing

Oil and Gas Operator:

The Office of Oil and Gas has reviewed the attached permit modification for the above referenced permit. The attached modification has been approved and well work may begin. Please be reminded that the oil and gas inspector is to be notified twenty-four (24) hours before permitted well work is commenced.

Please call James Martin at 304-926-0499, extension 1654 if you have any questions.

Sincerely,

Gene Smith
Assistant Chief of Permitting
Office of Oil and Gas



47 10302906 MOD

August 14, 2014

Mr. Gene Smith
West Virginia Department of Environmental Protection
Office of Oil and Gas
601 57th Street SE
Charleston, WV 25304

Re: Modification of 47-10302906

Dear Mr. Smith,

EQT would like to modify the above well, due to a change in the casing depths (please see attached letter).

If you have any questions, please do not hesitate to contact me at (304) 848-0076.

Sincerely,

A handwritten signature in blue ink, appearing to read 'Vicki Roark'.

Vicki Roark
Permitting Supervisor-WV

Enc.

RECEIVED
Office of Oil and Gas

SEP 09 2014

WV Department of
Environmental Protection



47 10302906 MOD

August 12, 2014

Mr. Gene Smith
West Virginia Department of Environmental Protection
Office of Oil and Gas
601 57th Street SE
Charleston, WV 25304

Re: Casing on Well 513982 (PNG103)

Dear Mr. Smith,

EQT is requesting the 13-3/8" surface casing be set at 1299' KB, 50' below the red rock base at 1249' without setting below elevation. The previous wells drilled on this pad set 13-3/8" casing at approximately 850' KB. This will cover up red rock formations that have given EQT drilling issues in the past. We will set the 9-5/8" intermediate string at 3367' KB, 50' below the base of the Gordon formation.

If you have any questions, please do not hesitate to contact me at (304) 848-0076.

Sincerely,

Vicki Roark
Permitting Supervisor

Enc.

DMH 9-4-14

RECEIVED
Office of Oil and Gas

SEP 09 2014

WV Department of
Environmental Protection

STATE OF WEST VIRGINIA
DEPARTMENT OF ENVIRONMENTAL PROTECTION, OFFICE OF OIL AND GAS
WELL WORK PERMIT APPLICATION

1) Well Operator: EQT Production Company

	103	4	548
--	-----	---	-----

Operator ID County District Quadrangle

2) Operator's Well Number: 513982 Well Pad Name: PNG103

3) Farm Name/Surface Owner: Scyoc Public Road Access: Hwy 20

4) Elevation, current ground: 1458 Elevation, proposed post-construction: 1458

5) Well Type (a) Gas Oil Underground Storage
Other

(b) If Gas Shallow Deep
Horizontal

6) Existing Pad: Yes or No yes

DMH 9-4-14

7) Proposed Target Formation(s), Depth(s), Anticipated Thickness and Associated Pressure(s):
Target formation is Marcellus at a depth of 7470 with the anticipated thickness to be 50 feet and anticipated target pressure of 4724 PSI

8) Proposed Total Vertical Depth: 7470

9) Formation at Total Vertical Depth: Marcellus

10) Proposed Total Measured Depth: 14562

11) Proposed Horizontal Leg Length: 5280

12) Approximate Fresh Water Strata Depths: 66, 141, 777

13) Method to Determine Fresh Water Depths: by offset wells

14) Approximate Saltwater Depths: 2187, 2487

15) Approximate Coal Seam Depths: 1054, 1161

16) Approximate Depth to Possible Void (coal mine, karst, other): none reported

17) Does Proposed well location contain coal seams directly overlying or adjacent to an active mine? Yes No

(a) If Yes, provide Mine Info: Name: _____
Depth: _____
Seam: _____
Owner: _____

RECEIVED
Office of Oil and Gas

SEP 09 2014

18)

CASING AND TUBING PROGRAM

<u>TYPE</u>	<u>Size</u>	<u>New or Used</u>	<u>Grade</u>	<u>Weight per ft. (lb/ft)</u>	<u>FOOTAGE: For Drilling</u>	<u>INTERVALS: Left in Well</u>	<u>CEMENT: Fill-up (Cu. Ft.)</u>
Conductor	20	new	MC-50	81	40	40	38 CTS
Fresh Water	13 3/8	new	MC-50	54	1299	1299	1118 CTS
Coal							
Intermediate	9 5/8	new	MC-50	40	3367	3367	1307 CTS
Production	5 1/2	new	P-110	20	14562	14562	see note 1
Tubing	2 3/8		J-55	4.6			<small>If run will be set 100' less than TD</small>
Liners							

DMH 9-4-14

<u>TYPE</u>	<u>Size</u>	<u>Wellbore Diameter</u>	<u>Wall Thickness</u>	<u>Burst Pressure</u>	<u>Cement Type</u>	<u>Cement Yield (cu. ft./k)</u>
Conductor	20	24	.375	-	construction	1.18
Fresh Water	13 3/8	17 1/2	.38	2480	see note 2	1.21
Coal						
Intermediate	9 5/8	12 3/8	.395	3590	see note 2	1.21
Production	5 1/2	8 1/2	.361	12640	-	1.27/1.86
Tubing						
Liners						

PACKERS

Kind:	n/a			
Sizes:	n/a			
Depths Set:	n/a			

RECEIVED
Office of Oil and Gas

SEP 09 2014

WV Department of
Environmental Protection
Page 2 of 3

19) Describe proposed well work, including the drilling and plugging back of any pilot hole:

Drill and complete a new horizontal well in the Marcellus formation. The vertical drill to go down to an approximate depth of 4,170'. Then kick off the horizontal leg into the Marcellus using a slick water frac.

20) Describe fracturing/stimulating methods in detail, including anticipated max pressure and max rate:

Hydraulic fracturing is completed in accordance with state regs using water recycled from previously fractured wells and obtained from fresh water sources. This water is mixed with sand and a small percentage (less than 0.3%) of chemicals (including 15% Hydrochloric acid, gelling agent, gel breaker, friction reducer, biocide, and scale inhibitor). Stage lengths vary from 150 to 450 feet. Avg approx 400,000 gal of water per stage. Sand sizes vary from 100 mesh to 20/40 mesh. Avg approx 400,000 lb of sand per stage. Sand sizes vary from 100 mesh to 20/40 mesh. Avg approx 400,000 lbs/stage.

DMH 9-4-14

21) Total Area to be disturbed, including roads, stockpile area, pits, etc., (acres): no additional disturbance

22) Area to be disturbed for well pad only, less access road (acres): no additional disturbance

23) Describe centralizer placement for each casing string:

- Surface: Bow spring centralizers – One at the shoe and one spaced every 500'.
- Intermediate: Bow spring centralizers– One cent at the shoe and one spaced every 500'.
- Production: One spaced every 1000' from KOP to Int csg shoe

24) Describe all cement additives associated with each cement type:

see attached

25) Proposed borehole conditioning procedures:

see attached

RECEIVED
Office of Oil and Gas

SEP 09 2014

WV Department of
Environmental Protection

*Note: Attach additional sheets as needed.

WW2B

FROM CASING PLAN

Note 1: EQT plans to bring the TOC on the production casing cement job 1,000' above kick off point, which is at least 500' above the shallowest production zone, to avoid communication.

Note 2: Reference Variance 2014-17. (Attached)

24) Describe all cement additives associated with each cement type.

Surface (Type 1 Cement): 0-3% Calcium Chloride used to speed the setting of cement slurries.

0.4% flake. Loss Circulation Material (LCM) is used to combat the loss of the cement slurry to a thief zone.

Intermediate (Type 1 Cement): 0-3% Calcium Chloride. Salt is used in shallow, low temperature formations to speed the setting of cement slurries. 0.4% flake. Loss Circulation Material (LCM) is used to combat the loss of whole drilling fluid or cement slurry (not filtrate) to a thief zone.

Production:

Lead (Type 1 Cement): 0.2-0.7% Lignosulfonate (Retarder). Lengthens thickening time.

0.3% CFR (dispersant). Makes cement easier to mix.

Tail (Type H Cement): 0.25-0.40% Lignosulfonate (Retarder). Lengthens thickening time.

0.2-0.3% CFR (dispersant). This is to make the cement easier to mix.

60 % Calcium Carbonate. Acid solubility.

0.4-0.6% Halad (fluid loss). Reduces amount of water lost to formation.

25) Proposed borehole conditioning procedures.

Surface: Circulate hole clean (Approximately 30-45 minutes) rotating & reciprocating one full joint until cuttings diminish at surface. When cuttings returning to surface diminish, continue to circulate an additional 5 minutes. To ensure that there is no fill, short trip two stands with no circulation. If there is fill, bring compressors back on and circulate hole clean. A constant rate of higher than expected cuttings volume likely indicates washouts that will not clean up.

Intermediate: Circulate hole clean (Approximately 30-45 minutes) rotating & reciprocating one full joint until cutting diminish at surface.

When cuttings returning to surface diminish, continue to circulate an additional 5 minutes. If foam drilling, to enhance hole cleaning use a soap sweep or increase injection rate & foam concentration.

Production: Pump marker sweep with nut plug to determine actual hole washout. Calculate a gauge holes bottoms up volume. Perform a cleanup cycle by pumping 3-5 bottoms up or until the shakers are clean. Check volume of cuttings coming across the shakers every 15 minutes

DMH 9-4-14

RECEIVED
Office of Oil and Gas

SEP 09 2014

WV Department of
Environmental Protection

47 10302906 MOD



west virginia department of environmental protection

Office of Oil and Gas
601 57th Street, SE
Charleston, WV 25304
(304) 228-0450
(304) 928-0452 fax

Earl Ray Tomblin, Governor
Randy C. Huffman, Cabinet Secretary
dep.wv.gov

BEFORE THE OFFICE OF OIL AND GAS
DEPARTMENT OF ENVIRONMENTAL PROTECTION
STATE OF WEST VIRGINIA

IN THE MATTER OF A VARIANCE FROM) ORDER NO. 2014-17
REGULATION 35 CSR § 4-11.4/11.5/14.1)
AND 35 CSR § 8-9.2.h. 4/5/6/8 OF THE)
THE OPERATIONAL)
REGULATIONS OF CEMENTING OIL)
AND GAS WELLS)

REPORT OF THE OFFICE

Nabors Completion & Production Services Co. requests approval of a different cement blend for use in cementing surface and coal protection casing of oil and gas wells.

FINDINGS OF FACT

1.) Nabors Completion & Production Services Co. proposes the following cement blend:

- 2% Calcium Chloride (Accelerator)
- 0.25 % Super Flake (Lost Circulation)
- 94% Type "1" Cement
- 5.20 % Water

2.) Laboratory testing results indicate that the blend listed in Fact No.1 will achieve a 500 psi compressive strength within 6 hours and a 2,435 psi compressive strength within 24 hours.

Promoting a healthy environment.

RECEIVED
Office of Oil and Gas

SEP 09 2014

WV Department of
Environmental Protection

CONCLUSIONS OF LAW

Pursuant to Articles 6 and 6A, Chapter 22 of the Code of West Virginia, the Office of Oil and Gas has jurisdiction over the subject matter embraced in said notice, and the persons interested therein, and jurisdiction to promulgate the hereinafter prescribed Order.

Pursuant to 35 CSR § 4-11.5 and 35 CSR § 8-9.2.h.8 the Chief of the Office of Oil and Gas may approve different cement blends upon the well operator providing satisfactory proof that different cement types are adequate.

ORDER

It is ordered that Nabors Completion & Production Services Co. may use the cement blend listed in Findings of Fact No.1 for the cementing of surface and coal protection casing of oil and gas wells in the State as may be requested by oil and gas operators. The waiting time on the cement blend shall be 8 hours. The cement blend shall be mixed in strict accordance with the specifications for each blend and weight measurements made on-site to assure the cement slurries meet the minimum weight specifications. A sample shall be collected and, if after 8 hours the cement is not set up, additional time will be required. Nabors Completion & Production Services Co. shall keep a record of cement blend jobs in which the cement blend approved under this order is to be used and made available to the Office of Oil and Gas upon request.

Dated this, the 18th day of March, 2014.

IN THE NAME OF THE STATE OF WEST VIRGINIA

OFFICE OF OIL AND GAS
DEPARTMENT OF ENVIRONMENTAL PROTECTION
OF THE STATE OF WEST VIRGINIA




James Martin, Chief
Office of Oil and Gas

4710302906 MOD

Well Schematic
EQT Production

Well Name: 513082/PNG103H13
County: Wetzel
State: West Virginia

Elevation KB: 1453
Target: Marcellus
Prospect: 106.5
Azimuth: 6/33
Vertical Section:

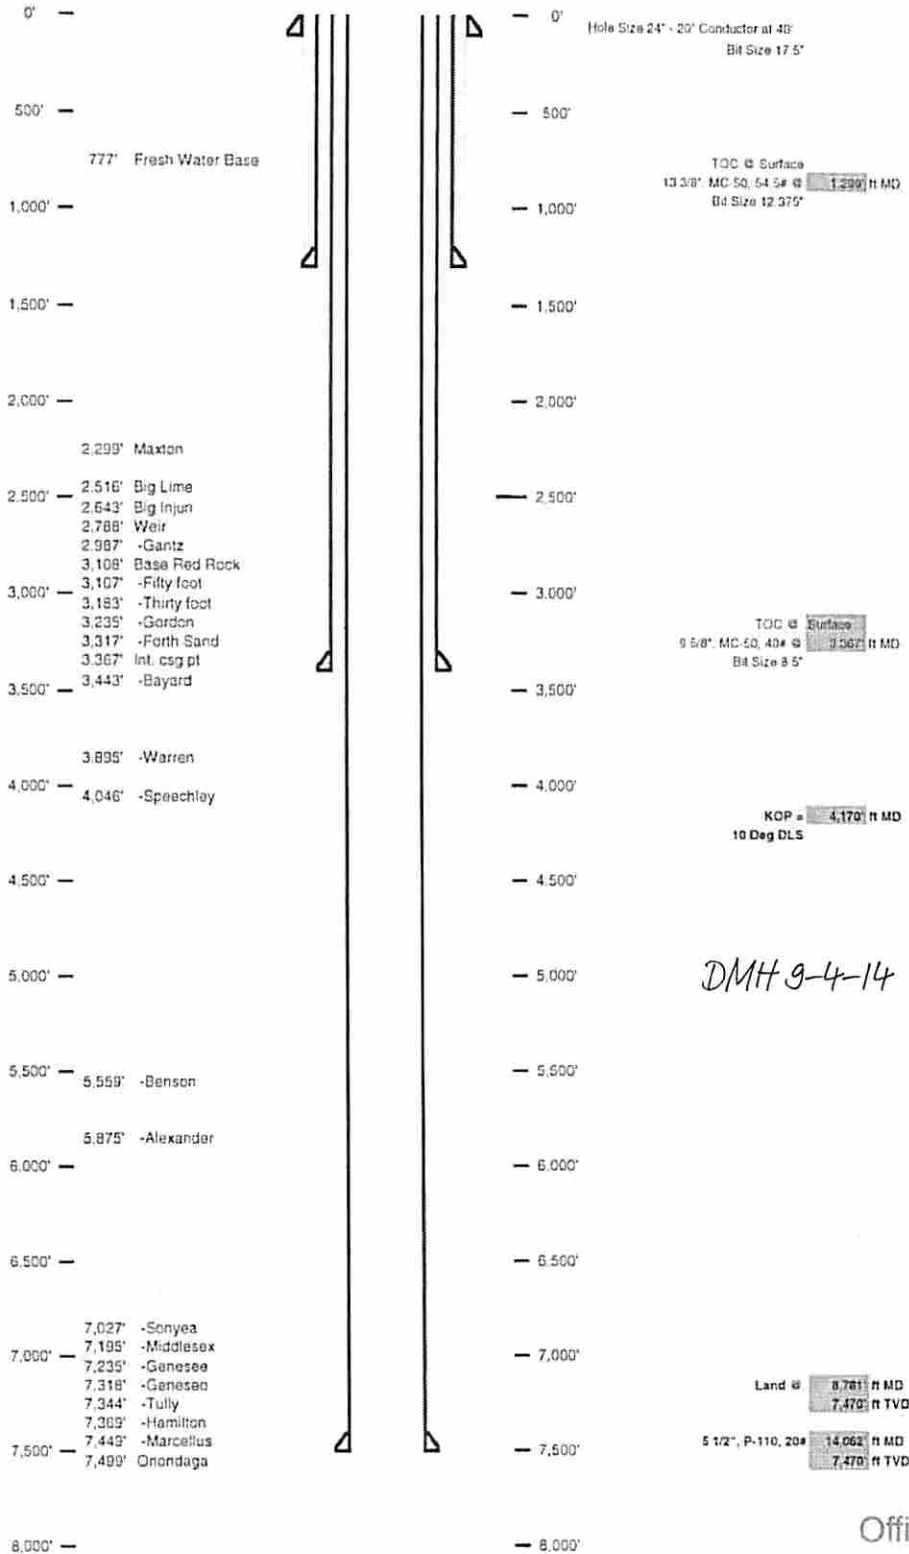

RECEIVED
Office of Oil and Gas

SEP 09 2014

WV Department of
Environmental Protection

4710302906 MD

Well: 513982(PNG103H13)
 EOT Production
 Pine Grove
 West Virginia

Aspen 124.5
 Vertical Section 423



Proposed Well Work:
 Drill and complete a new horizontal well in the Marcellus formation.
 The vertical drill to go down to an approximate depth of 4170'.
 Then kick off the horizontal leg into the Marcellus using a slick water frac.



DMH 9-4-14

RECEIVED
 Office of Oil and Gas
 SEP 09 2014
 WV Department of
 Environmental Protection

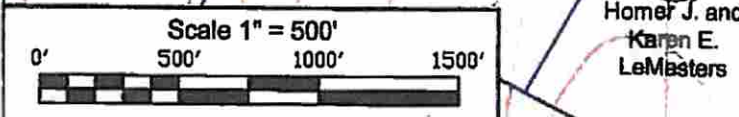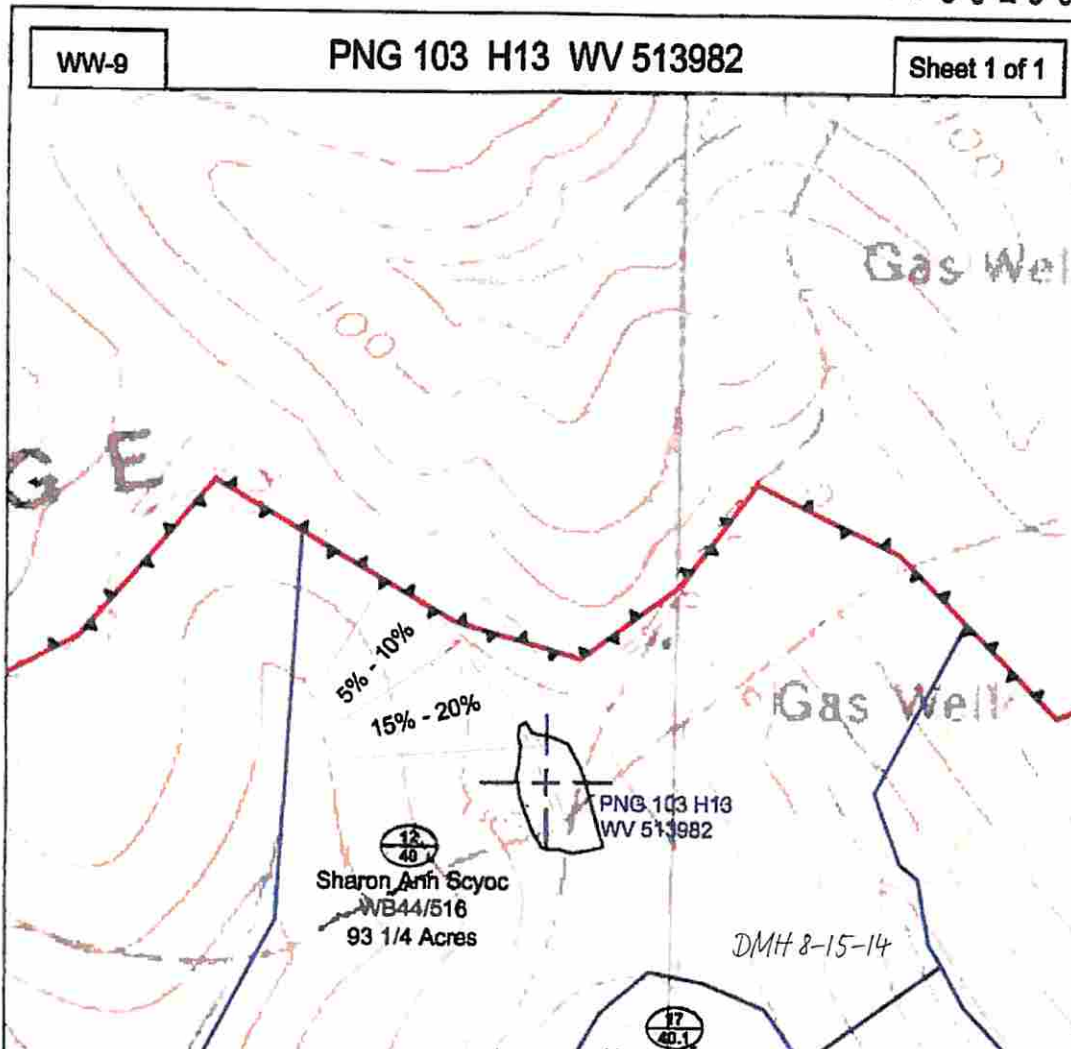

Well # WV 513982
Location Detail PNG 103 H13

(C) Denotes to install 12" minimum culvert **(X)** Denotes a proposed stream crossing (if applies) "see table for culvert detail"

Unless otherwise noted, all roads shown hereon are existing and shall be maintained in accordance with WV D.E.P., Office of Oil and Gas Erosion and Sediment Control Field Manual as revised 2/08

Entrances upon county/state roads shall be maintained in accordance with WV D.O.T. regulations, however, separate permits may be required by the WV D.O.T.

Sediment basins (traps) and appropriate erosion control barriers are to be constructed at all culverts and cross-drains as required in the aforementioned Erosion and Sediment Control Field Manual. Where field conditions dictate, alternative erosion control measures shall be enacted as required.

Earthwork contractors are responsible for notification to the operator and inspector prior to any deviation from this plan.

Temporary seed and mulch all slopes after construction of location.


Cut and stack all marketable timber.

Stacked brush may be used for sediment control.

Applications for separate Public Land Corporation Permits on the access roads stream crossings have been prepared (if applies).

Additional culverts and/or other drainage structures and sediment control devices may be required by the WV D.E.P. Oil & Gas Inspector.

Operator is responsible for the coordination with contractor and Allegheny Surveys regarding any changes or additions the state may require.

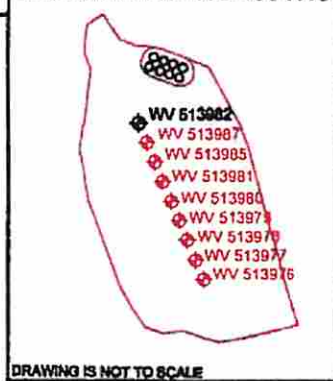

SECTION OF THE Pine Grove 7.5' USGS QUADRANGLE	
Projected culvert inventory (for bid purposes only)	
12" minimum diameter culverts	0 Culverts
15" minimum diameter culverts	0 Culverts
DRAWN BY: Scott Brown	DATE: April 18, 2013
FILE NO. 212-34-G-10	DRAWING FILE NO. 212-10 PNG103 H13 Race Plan

- DRAWING IS NOT TO SCALE**
- LEASE BOUNDARY
 - PROPERTY BOUNDARY
 - ROAD PATH
 - ROAD
 - DITCH
 - SILT FENCE
 - PROPOSED WELL
 - BROAD BASED RIP
 - EXISTING GATE
 - EXISTING CULVERT
 - PROPOSED CULVERT
 - CROSS DRAIN
 - PIT-CUT WALLS
 - PIT-CONCRETE WALLS
 - AREA OF LAND APPLICATION OF PIT WASTE

RECEIVED
Office of Oil and Gas
SEP 09 2014
West Virginia Department of Environmental Protection

ALLEGHENY SURVEYS, INC. logo

SURVEYING AND MAPPING SERVICES PERFORMED BY:
ALLEGHENY SURVEYS, INC.
1-800-482-8608

Birch River Office 237 Birch River Road
Phone: (304) 649-8608 P.O. Box 438
Fax: (304) 649-8608 Birch River, WV 26610